


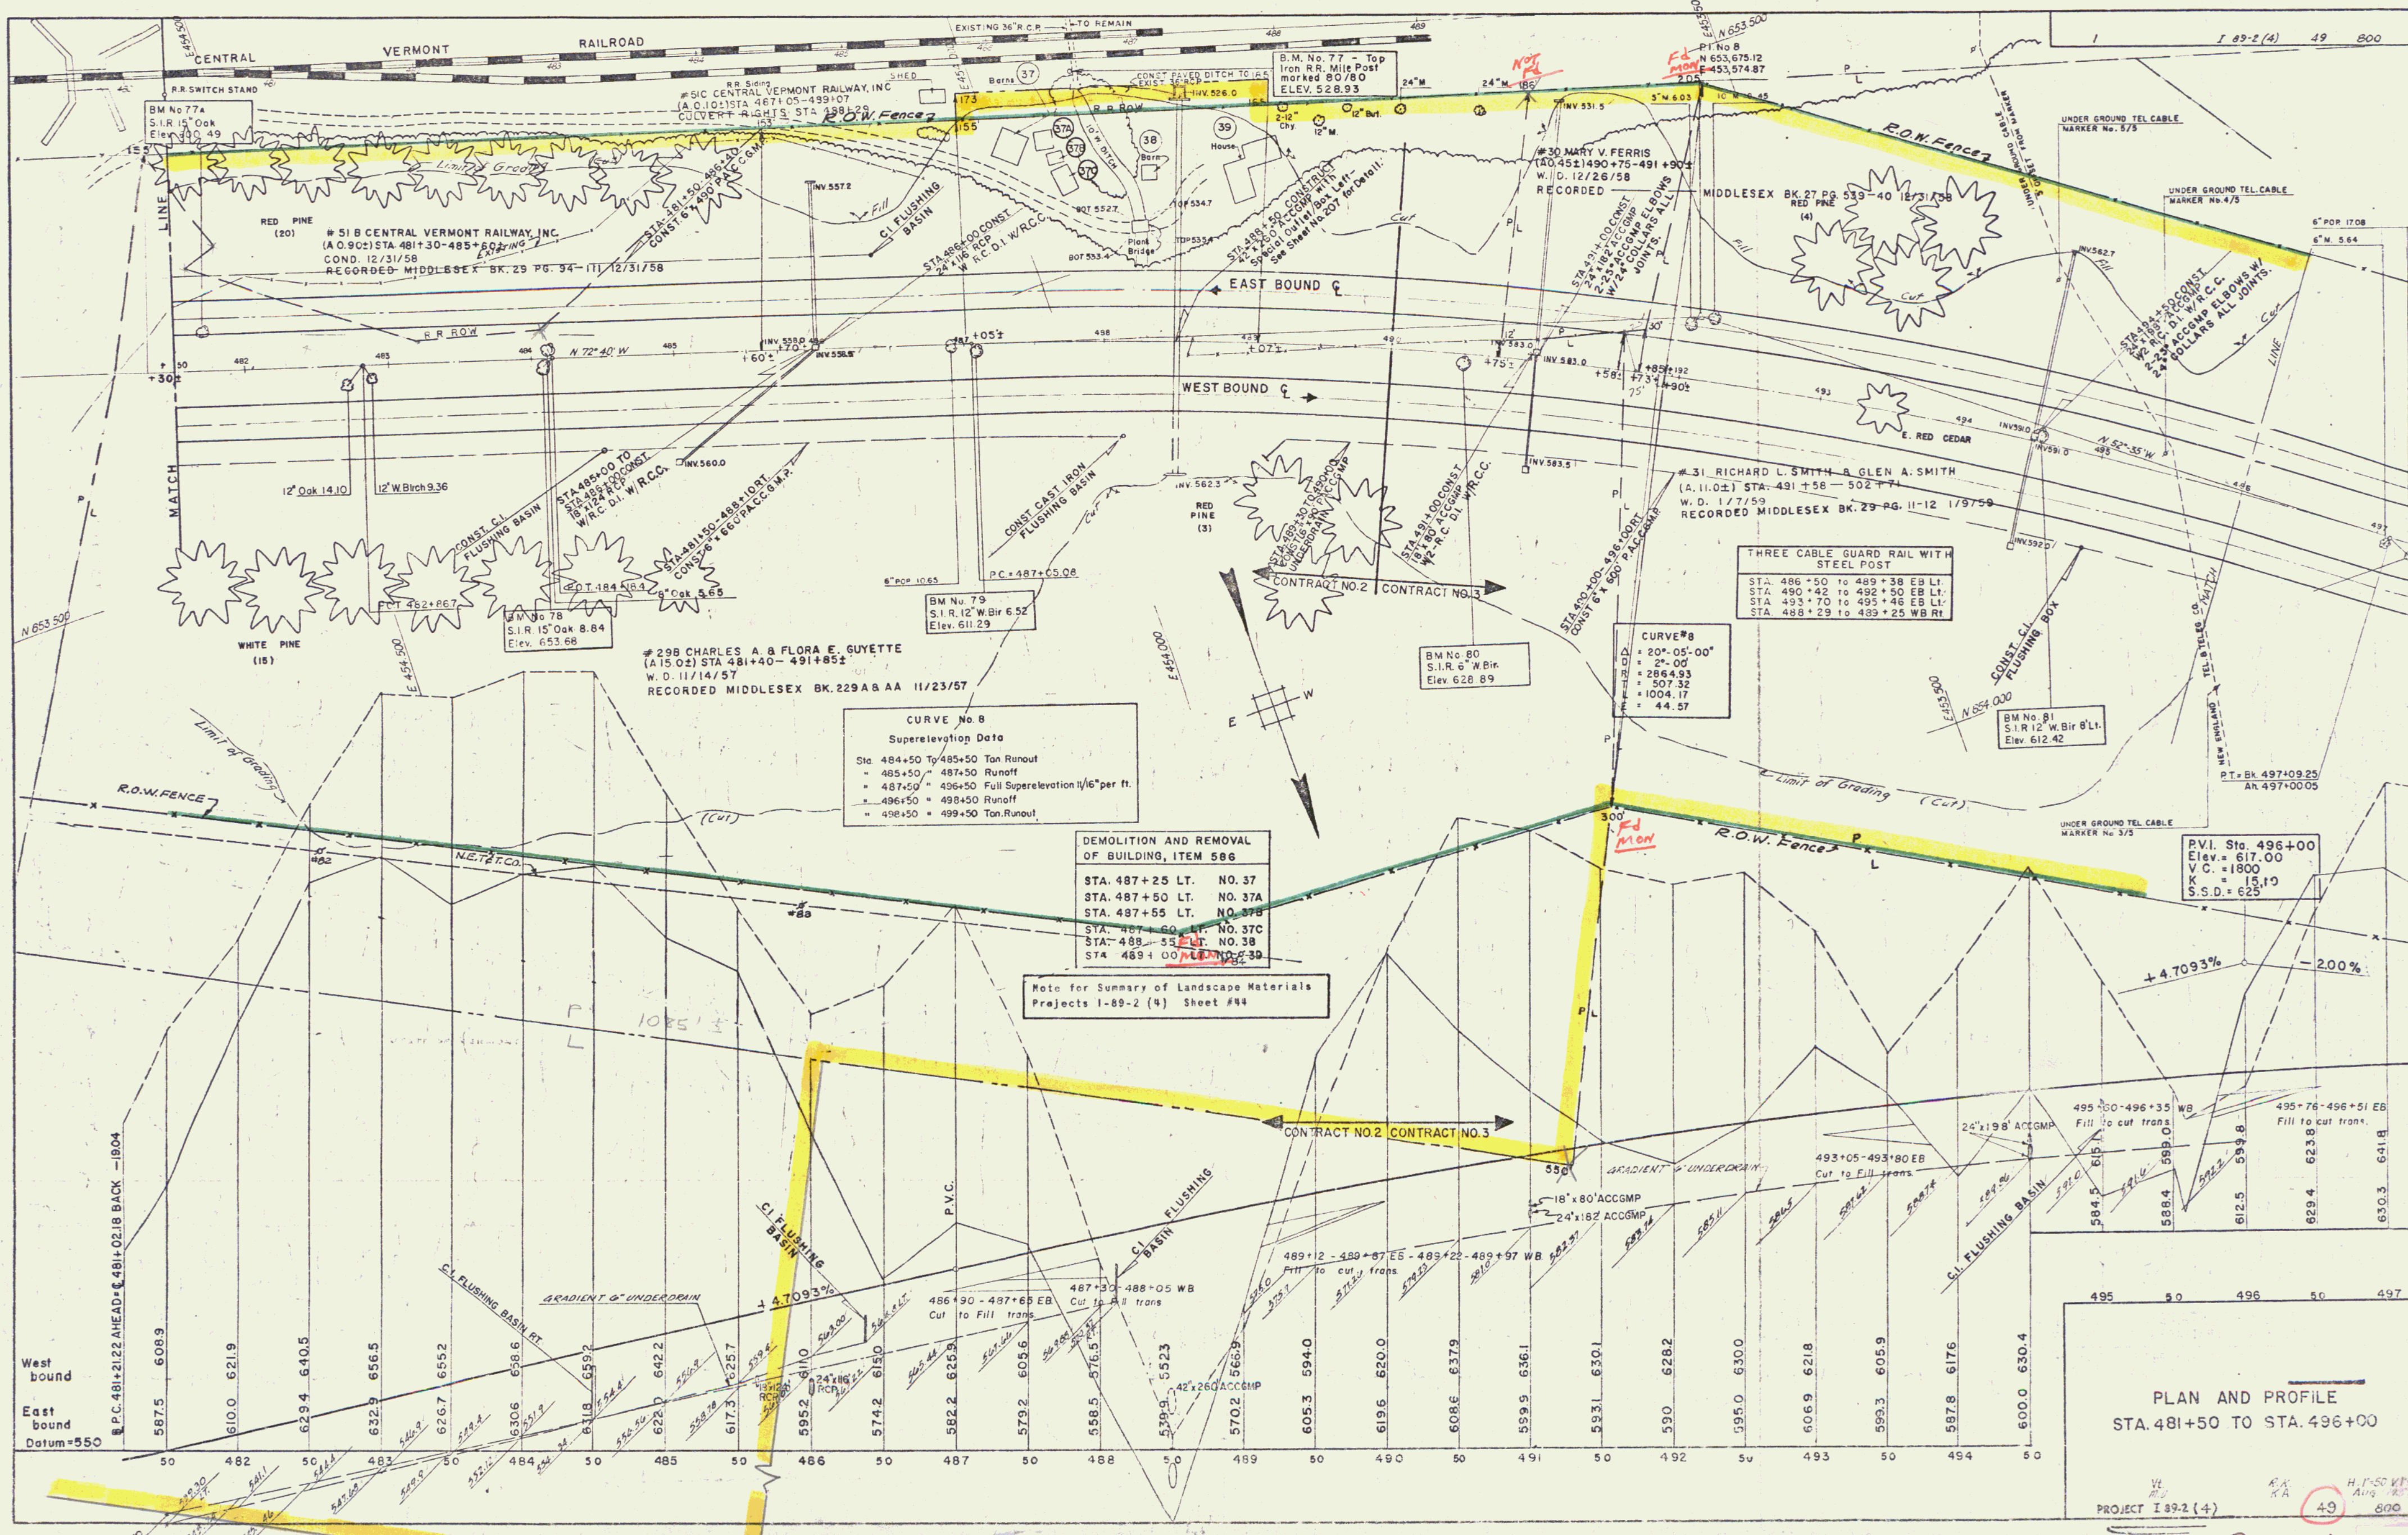

CURVE NO. 8
Superlevation Data

Sta. 484+50 To 485+50	Tan Runout	
485+50	487+50	Runoff
487+50	496+50	Full Superlevation 1/16" per ft.
496+50	498+50	Runoff
498+50	499+50	Tan Runout

DEMOLITION AND REMOVAL OF BUILDING, ITEM 586

STA. 487+25	LT. NO. 37
STA. 487+50	LT. NO. 37A
STA. 487+55	LT. NO. 37B
STA. 487+60	LT. NO. 37C
STA. 489+55	LT. NO. 38
STA. 489+00	LT. NO. 39

Note for Summary of Landscape Materials
Projects I-89-2 (4) Sheet #44

PLAN AND PROFILE
STA. 481+50 TO STA. 496+00

V.L. KA
 H. 11-50 V.L. KA
 Aug 1957
 PROJECT I 89-2 (4)
 49
 800
 Bconst 35