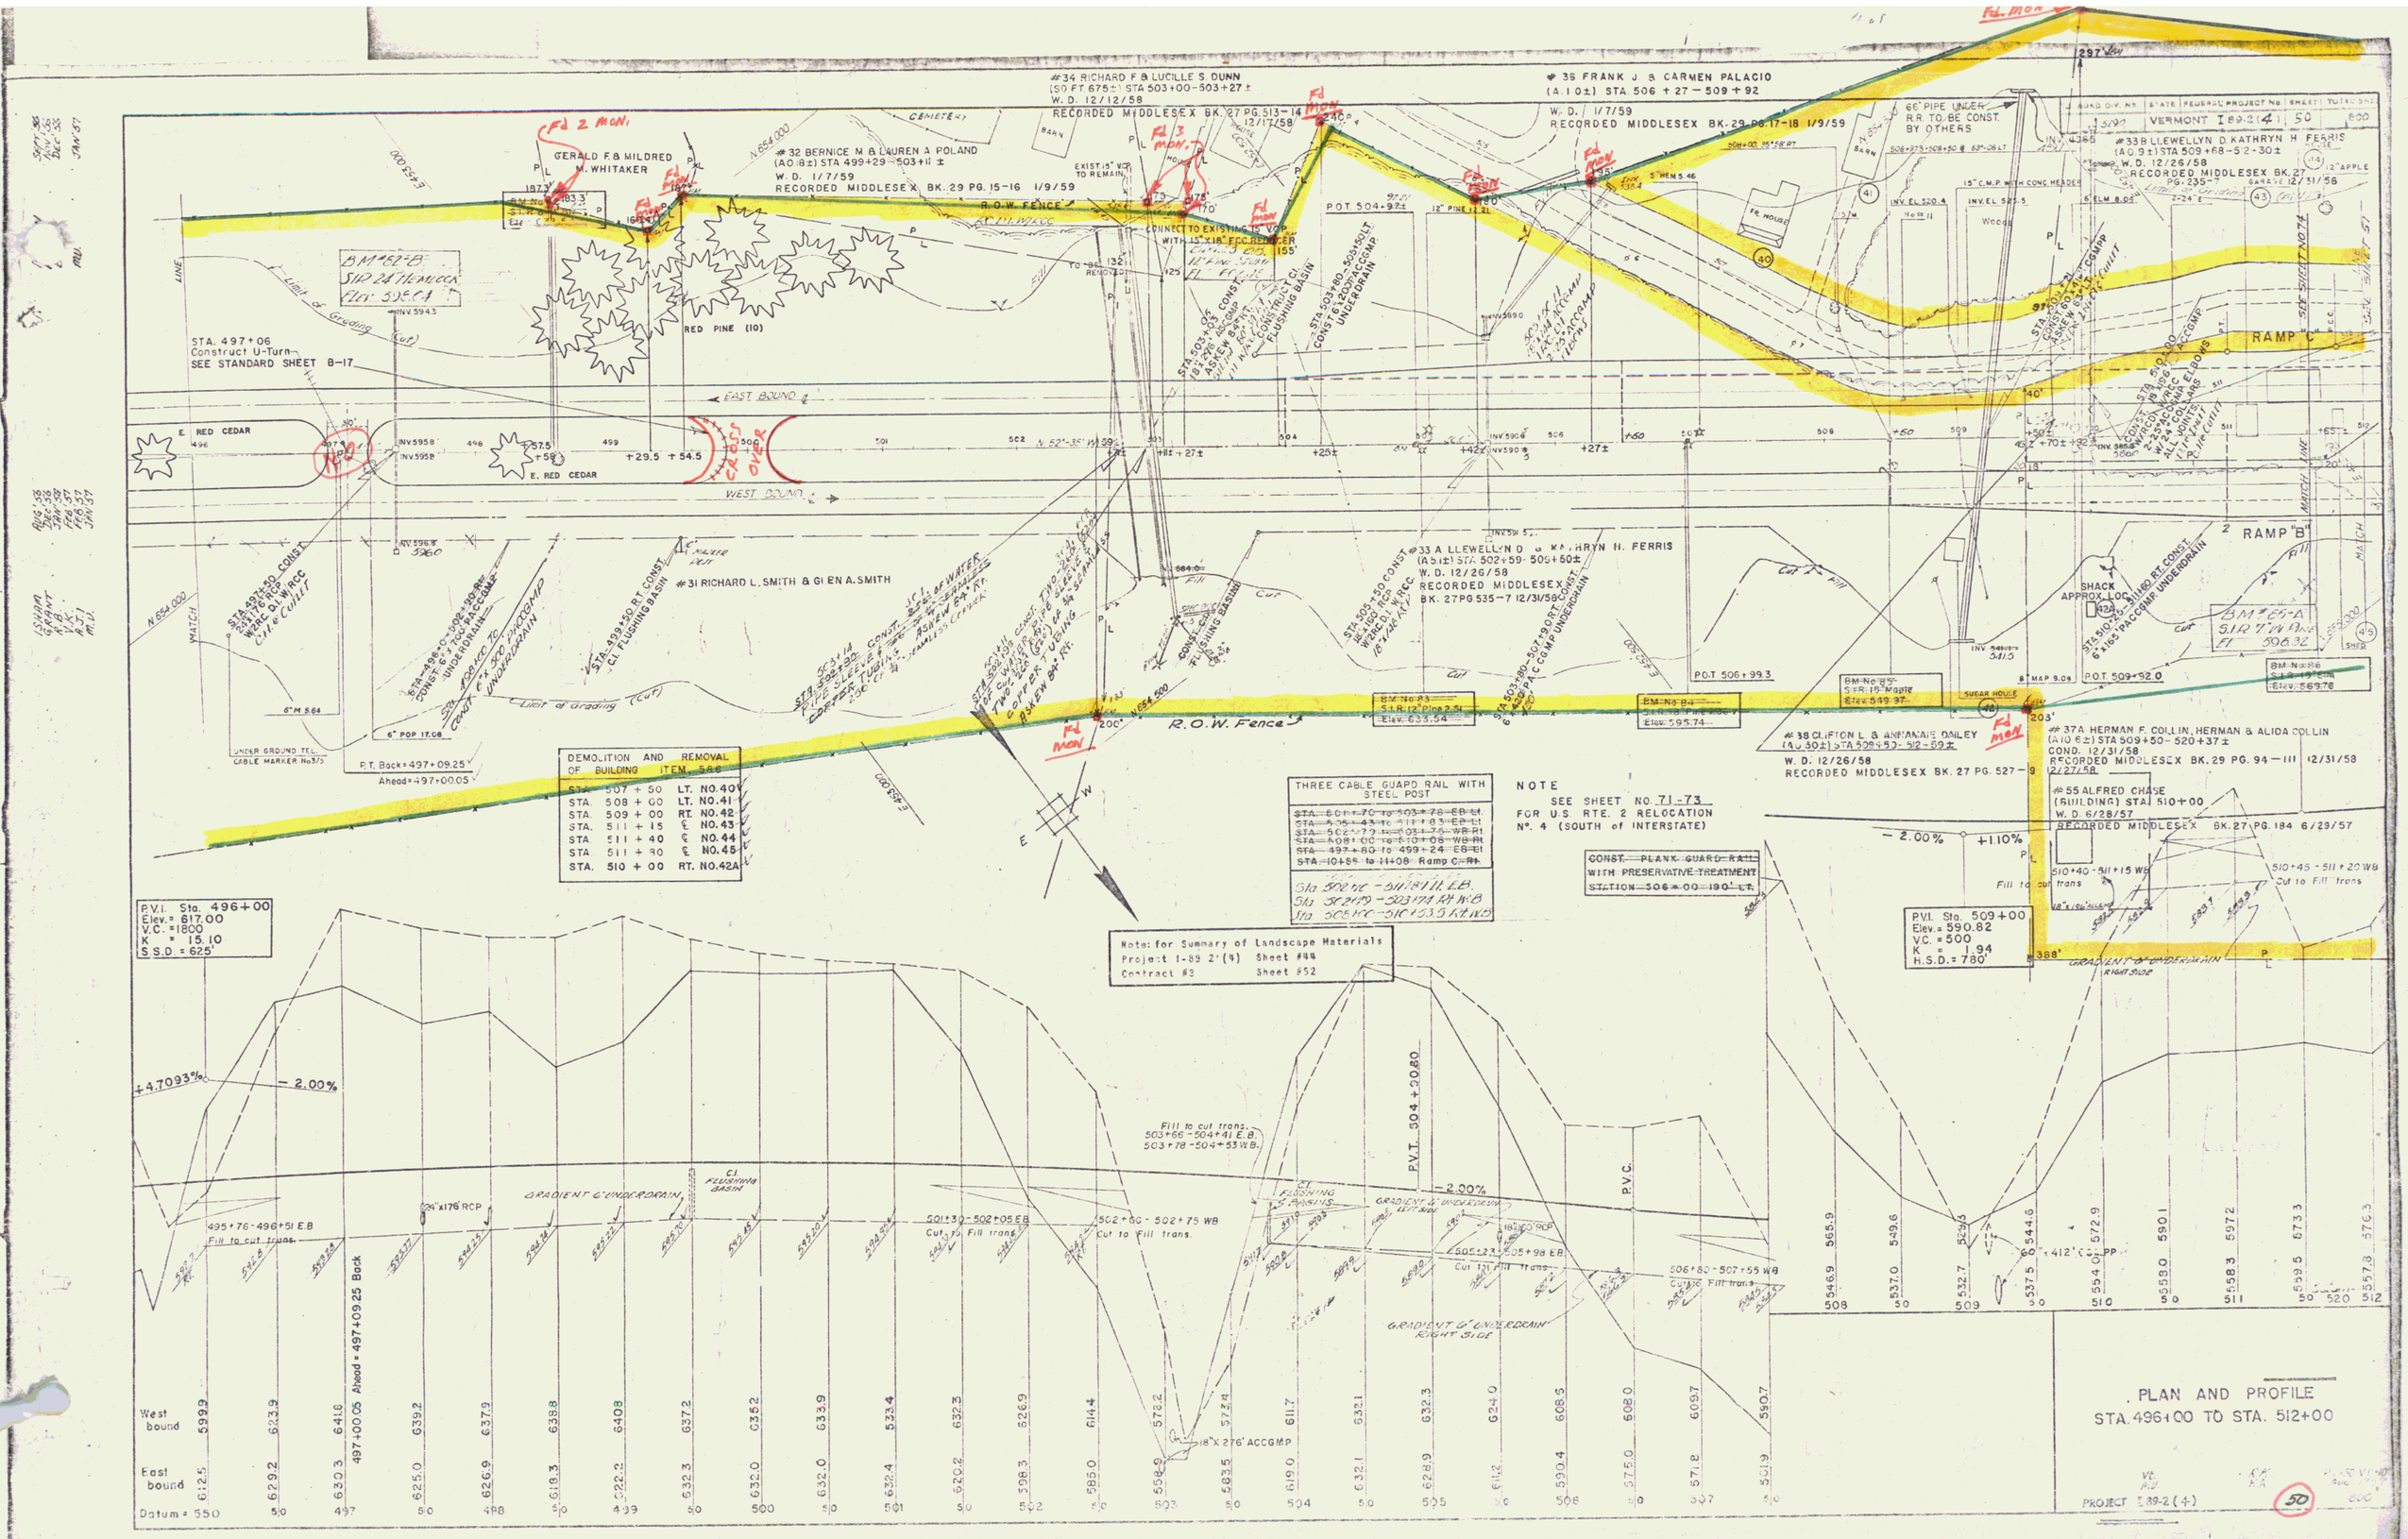
#34 RICHARD F & LUCILLE S. DUNN
(50 FT 675±) STA 503+00-503+27±
W. D. 12/12/58
RECORDED MIDDLESEX BK. 27 PG. 513-14 12/17/58
#36 FRANK J. & CARMEN PALACIO
(A. 1.0±) STA. 506 + 27 — 509 + 92
W. D. 1/7/59
RECORDED MIDDLESEX BK. 29 PG. 17-18 1/9/59
66" PIPE UNDER R.R. TO BE CONST. BY OTHERS
VERMONT I 89-2(4) 50
#33 B LLEWELLYN D. & KATHRYN H. FERRIS
(A. 0.9±) STA 509+68-512+30±
W. D. 12/26/58
RECORDED MIDDLESEX BK. 27 PG. 235-7
GERALD F. & MILDRED M. WHITAKER
#32 BERNICE M. & LAUREN A. POLAND
(A. 0.8±) STA 499+29-503+11±
W. D. 1/7/59
RECORDED MIDDLESEX BK. 29 PG. 15-16 1/9/59
BM #82-B
SIR 24" HEMLOCK
Elev. 595.04
STA. 497+06
Construct U-Turn
SEE STANDARD SHEET B-17
RED PINE (10)
E. RED CEDAR
EAST BOUND
WEST BOUND
RAMP "C"
RAMP "B"
#31 RICHARD L. SMITH & GLEN A. SMITH
#33 A LLEWELLYN D. & KATHRYN H. FERRIS
(A. 5.1±) STA 502+59-506+50±
W. D. 12/26/58
RECORDED MIDDLESEX BK. 27 PG. 535-7 12/31/58
SHACK APPROX. LOC.
BM #85-A
SIR 7" WHITE PINE
Elev. 506.32
#38 CLIFTON L. & ANNAMAE DAILEY
(A. 0.30±) STA 508+50-512+59±
W. D. 12/26/58
RECORDED MIDDLESEX BK. 27 PG. 527-9 12/31/58
#37A HERMAN F. COLLIN, HERMAN & ALIDA COLLIN
(A. 0.6±) STA 509+50-520+37±
COND. 12/31/58
RECORDED MIDDLESEX BK. 29 PG. 94-111 12/31/58
#55 ALFRED CHASE
(BUILDING) STA. 510+00
W. D. 6/28/57
RECORDED MIDDLESEX BK. 27 PG. 184 6/29/57
R.O.W. Fence
P.T. Back = 497+09.25
Ahead = 497+00.05
DEMOLITION AND REMOVAL OF BUILDING ITEM 526
STA. 507 + 50 LT. NO. 40
STA. 508 + 00 LT. NO. 41
STA. 509 + 00 RT. NO. 42
STA. 511 + 15 ℄ NO. 43
STA. 511 + 40 ℄ NO. 44
STA. 511 + 90 ℄ NO. 45
STA. 510 + 00 RT. NO. 42A
THREE CABLE GUARD RAIL WITH STEEL POST
NOTE
SEE SHEET NO. 71-73
FOR U.S. RTE. 2 RELOCATION
N°. 4 (SOUTH of INTERSTATE)
CONST. PLANK GUARD RAIL WITH PRESERVATIVE TREATMENT
STATION 506 + 00 - 190' LT.
Note: for Summary of Landscape Materials
Project 1-89 2 (4) Sheet #44
Contract #3 Sheet #52
P.V.I. Sta. 496+00
Elev. = 617.00
V.C. = 1800
K = 15.10
S.S.D. = 625'
+4.7093%
-2.00%
P.V.I. Sta. 509+00
Elev. = 590.82
V.C. = 500
K = 1.94
H.S.D. = 780'
+1.10%
P.V.T. 504+90.80
P.V.C.
GRADIENT 6" UNDERDRAIN
Datum = 550
West bound
East bound
PLAN AND PROFILE
STA. 496+00 TO STA. 512+00
PROJECT I 89-2 (4)

37