DRIVES (R.O.W.)
STA. 13+50 R.T.
STA. 17+10 R.T
STA. 21+25 R.T.

TWO CABLE GUARD RAIL (R.O.W.)
STA. 22+03 – 23+80 LT.

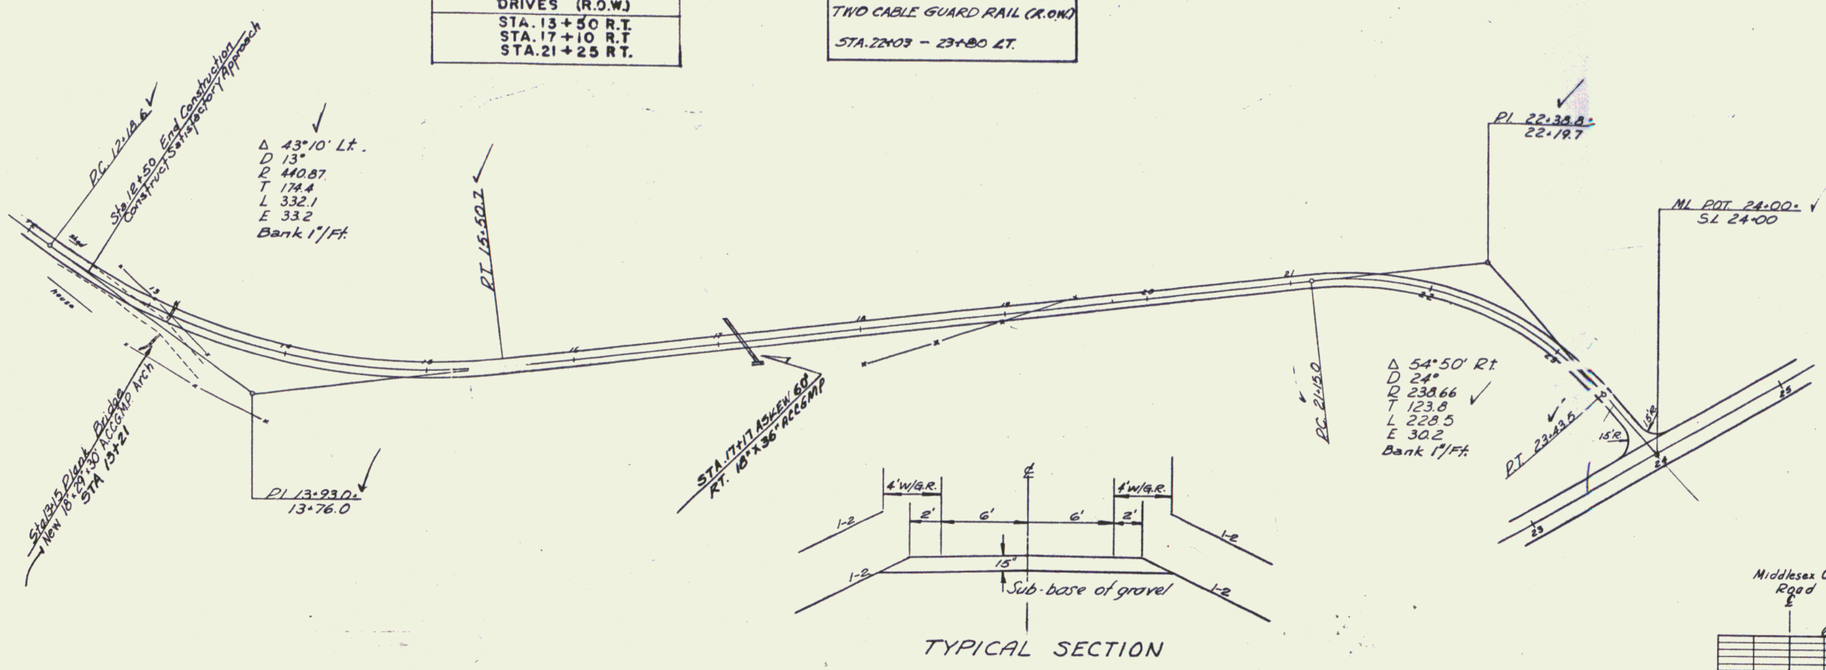

Relocated Middlesex Center Road
Drive @ 24+00 Lt

MIDDLESEX
Proj I No. 89-2(4) Contract 4
Sheet 6-A of 50

L const
60