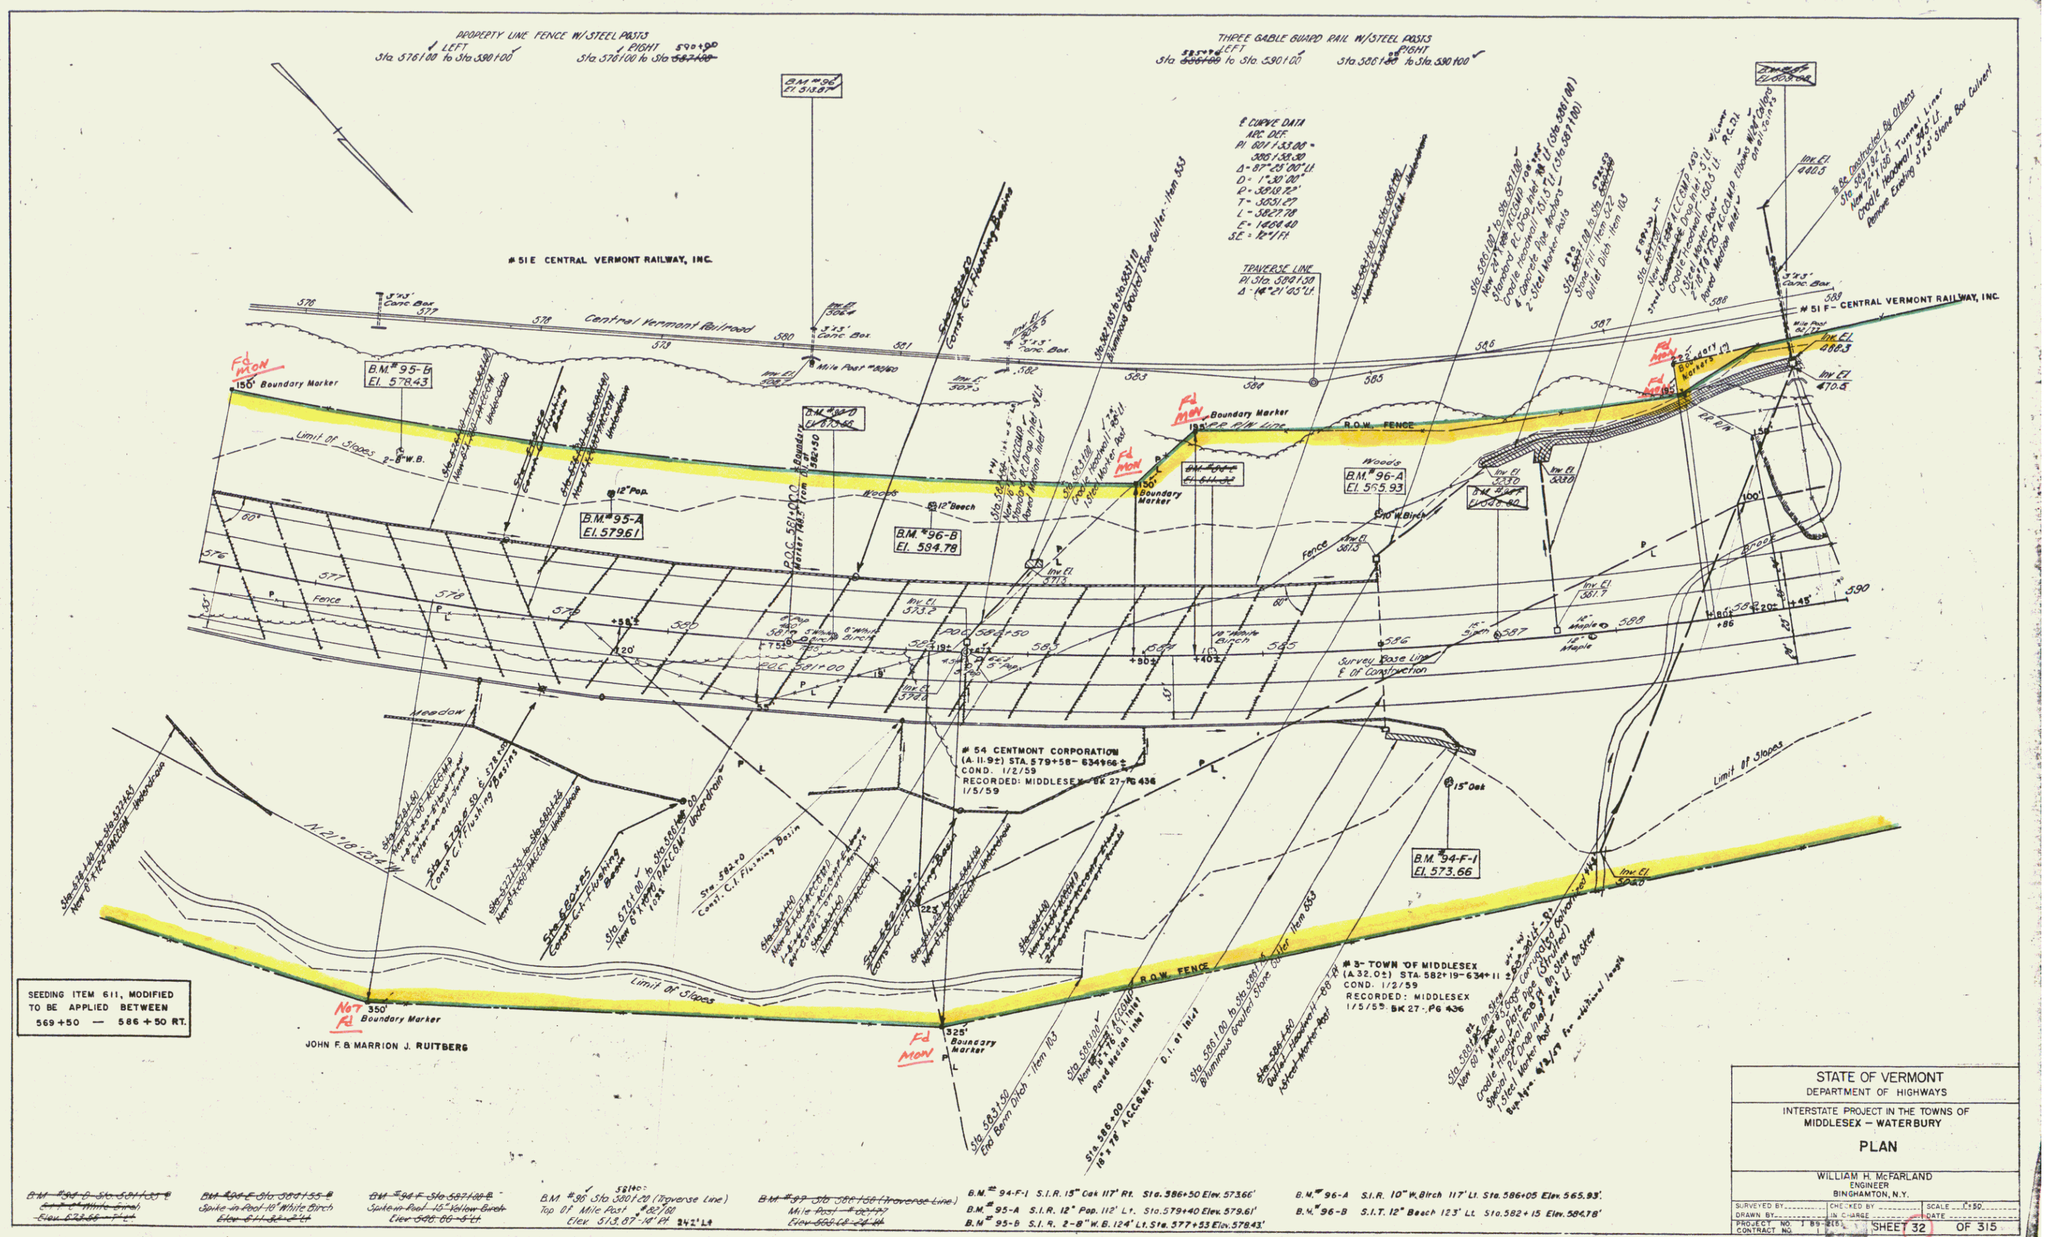
PROPERTY LINE FENCE W/STEEL POSTS
THREE CABLE GUARD RAIL W/STEEL POSTS
E CURVE DATA
TRAVERSE LINE
51 E CENTRAL VERMONT RAILWAY, INC.
51 F - CENTRAL VERMONT RAILWAY, INC.
Central Vermont Railroad
B.M. # 95-B El. 578.43
B.M. # 95-A El. 579.61
B.M. # 96-B El. 594.78
B.M. # 96-A El. 565.93
B.M. # 94-F-1 El. 573.66
Boundary Marker
Limit of Slopes
R.O.W. FENCE
Woods
Meadow
Fence
Survey Base Line ℄ of Construction
54 CENTMONT CORPORATION
(A. 11.92) STA. 579+58 - 634+66 ±
COND. 1/2/59
RECORDED: MIDDLESEX BK 27 - PG 436
1/5/59
3 - TOWN OF MIDDLESEX
(A. 32.0 ±) STA. 582+19 - 634+11 ±
COND. 1/2/59
RECORDED: MIDDLESEX
1/5/59 BK 27 - PG 436
JOHN F. & MARRION J. RUITBERG
SEEDING ITEM 611, MODIFIED
TO BE APPLIED BETWEEN
569+50 — 586+50 RT.
STATE OF VERMONT
DEPARTMENT OF HIGHWAYS
INTERSTATE PROJECT IN THE TOWNS OF
MIDDLESEX – WATERBURY
PLAN
WILLIAM H. McFARLAND
ENGINEER
BINGHAMTON, N.Y.
SHEET 32 OF 315