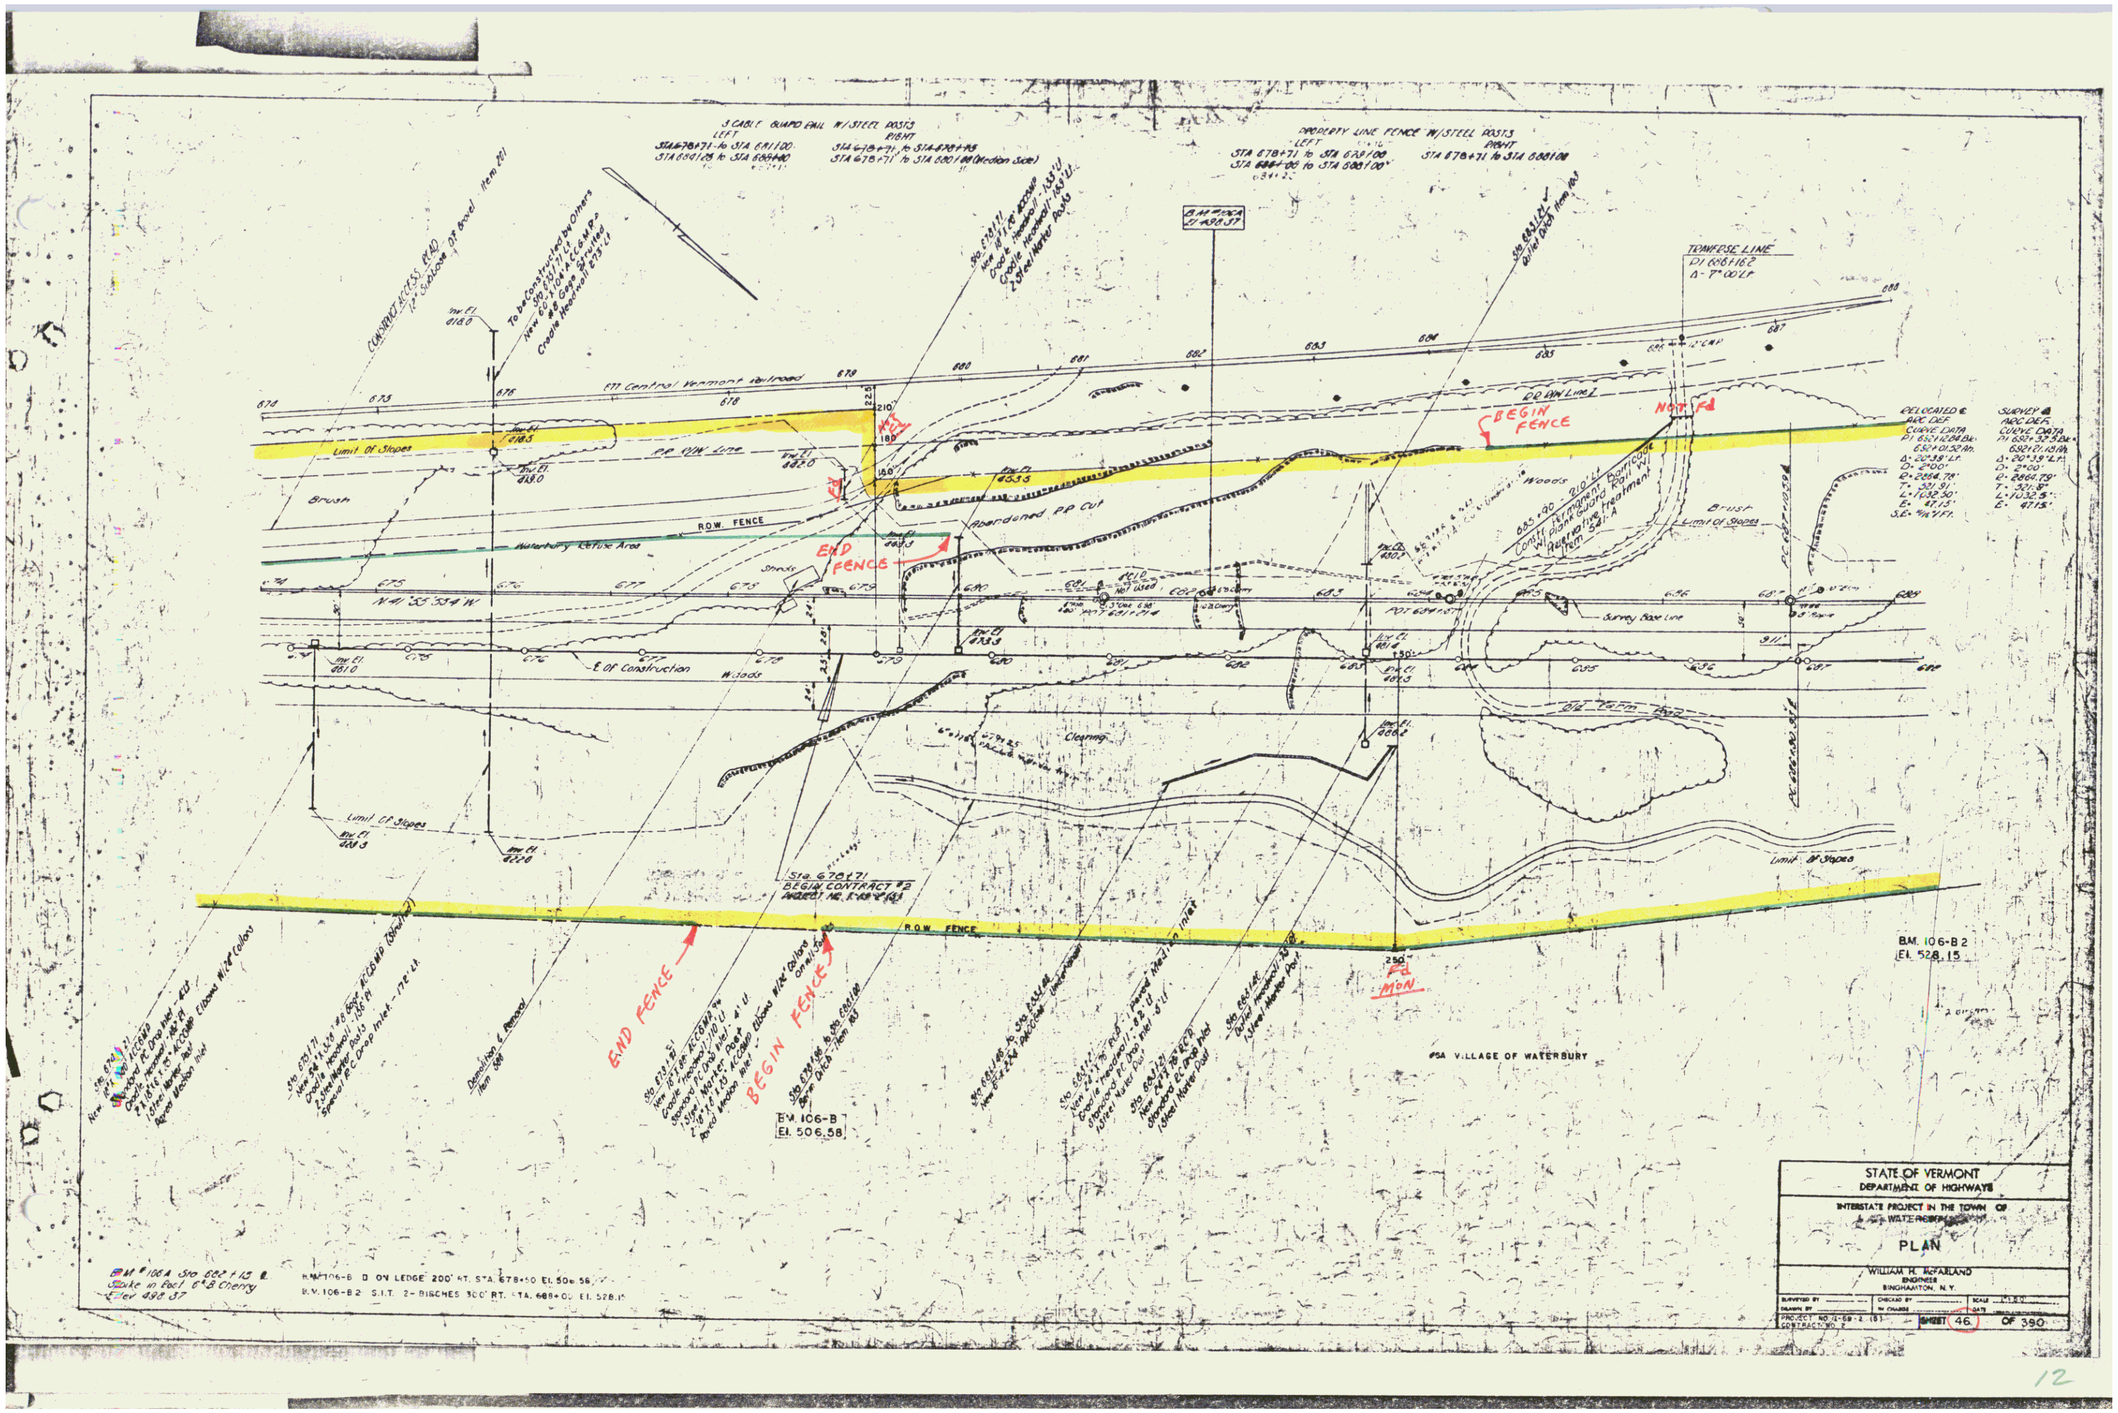
3 CABLE GUARD RAIL W/STEEL POSTS
LEFT
RIGHT
PROPERTY LINE FENCE W/STEEL POSTS
LEFT
RIGHT
CONSTRUCT ACCESS ROAD
BEGIN FENCE
END FENCE
BEGIN FENCE
END FENCE
ROW FENCE
Limit Of Slopes
Brush
Woods
Cleaning
Survey Base Line
Abandoned PP Cut
Stacks
Not Used
Not Used
Not Used