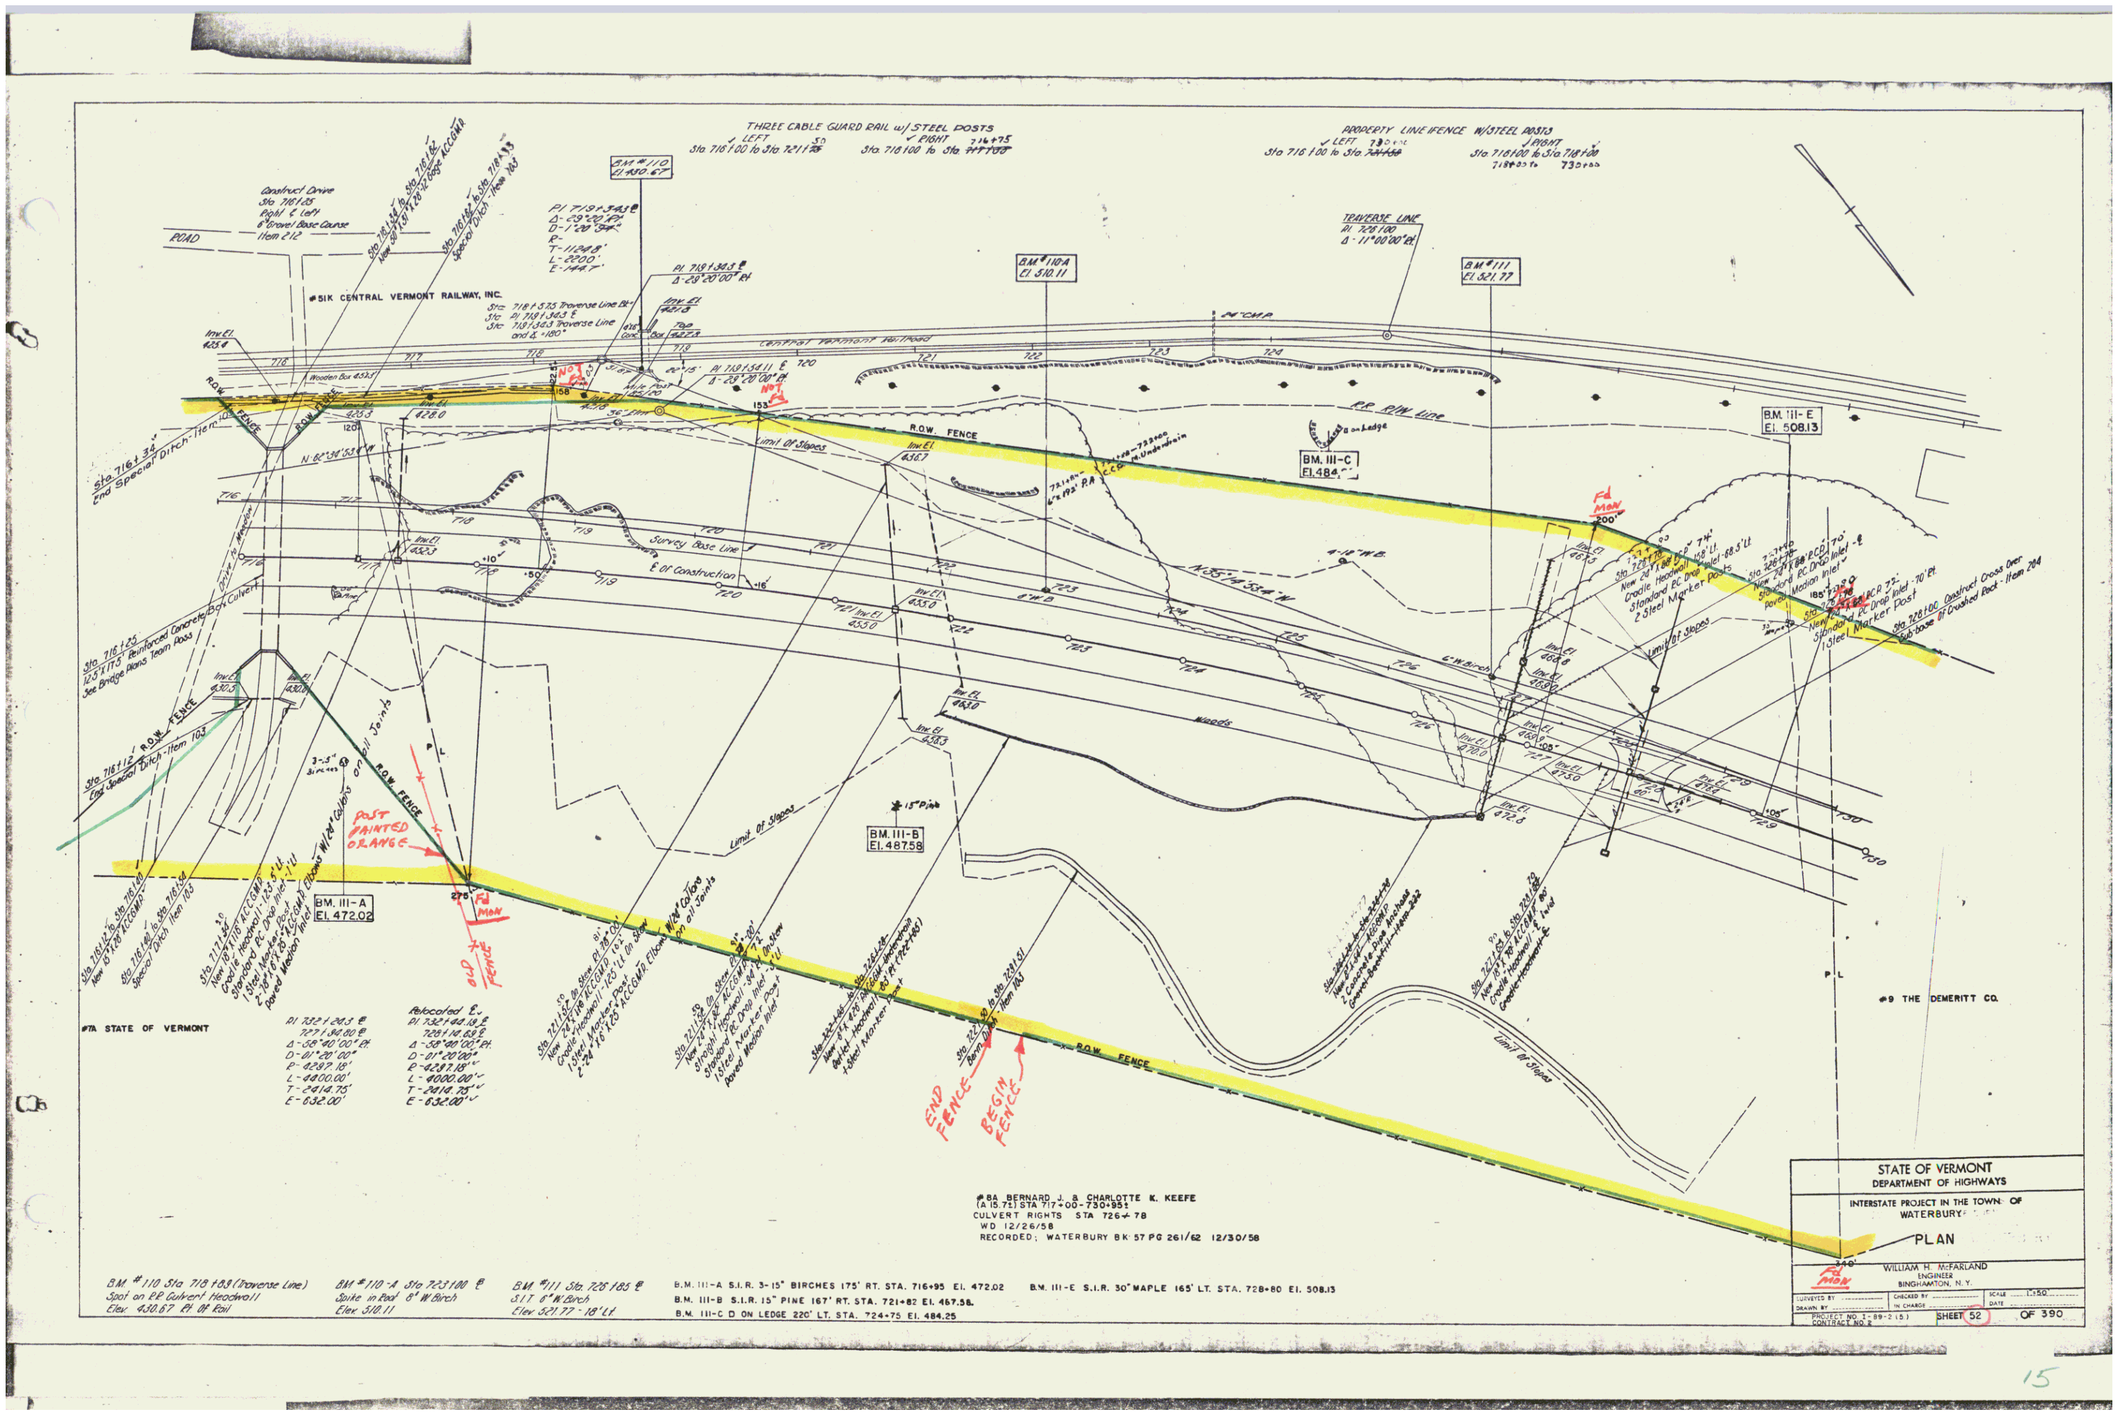
THREE CABLE GUARD RAIL w/ STEEL POSTS
PROPERTY LINE FENCE W/STEEL POSTS
#SIK CENTRAL VERMONT RAILWAY, INC.
Central Vermont Railroad
R.O.W. FENCE
Survey Base Line
℄ Of Construction
Limit Of Slopes
Woods
BM. III-A El. 472.02
BM. III-B El. 487.58
BM. III-C El. 484.
BM. III-E El. 508.13
#7A STATE OF VERMONT
#9 THE DEMERITT CO.
#8A BERNARD J. & CHARLOTTE K. KEEFE
(A 15.73) STA 717+00-730+85
CULVERT RIGHTS STA 726+78
WD 12/26/58
RECORDED; WATERBURY BK 57 PG 261/62 12/30/58
BM #110 Sta 718+83 (Traverse Line)
Spot on PE Culvert Headwall
Elev. 430.67 Ft. Of Rail
BM #110-A Sta 723+00 ℄
Spike in Pad 8" W. Birch
Elev. 510.11
BM #111 Sta 726+85 ℄
S.I.T. 6" W. Birch
Elev. 521.77 - 18' Lt.
B.M. III-A S.I.R. 3-15" BIRCHES 175' RT. STA. 716+95 El. 472.02
B.M. III-B S.I.R. 15" PINE 167' RT. STA. 721+82 El. 487.58.
B.M. III-C D ON LEDGE 220' LT. STA. 724+75 El. 484.25
B.M. III-E S.I.R. 30" MAPLE 165' LT. STA. 728+80 El. 508.13
END FENCE
BEGIN FENCE
POST PAINTED ORANGE
STATE OF VERMONT
DEPARTMENT OF HIGHWAYS
INTERSTATE PROJECT IN THE TOWN OF WATERBURY
PLAN
WILLIAM H. McFARLAND
ENGINEER
BINGHAMTON, N.Y.
SHEET 52 OF 390

15