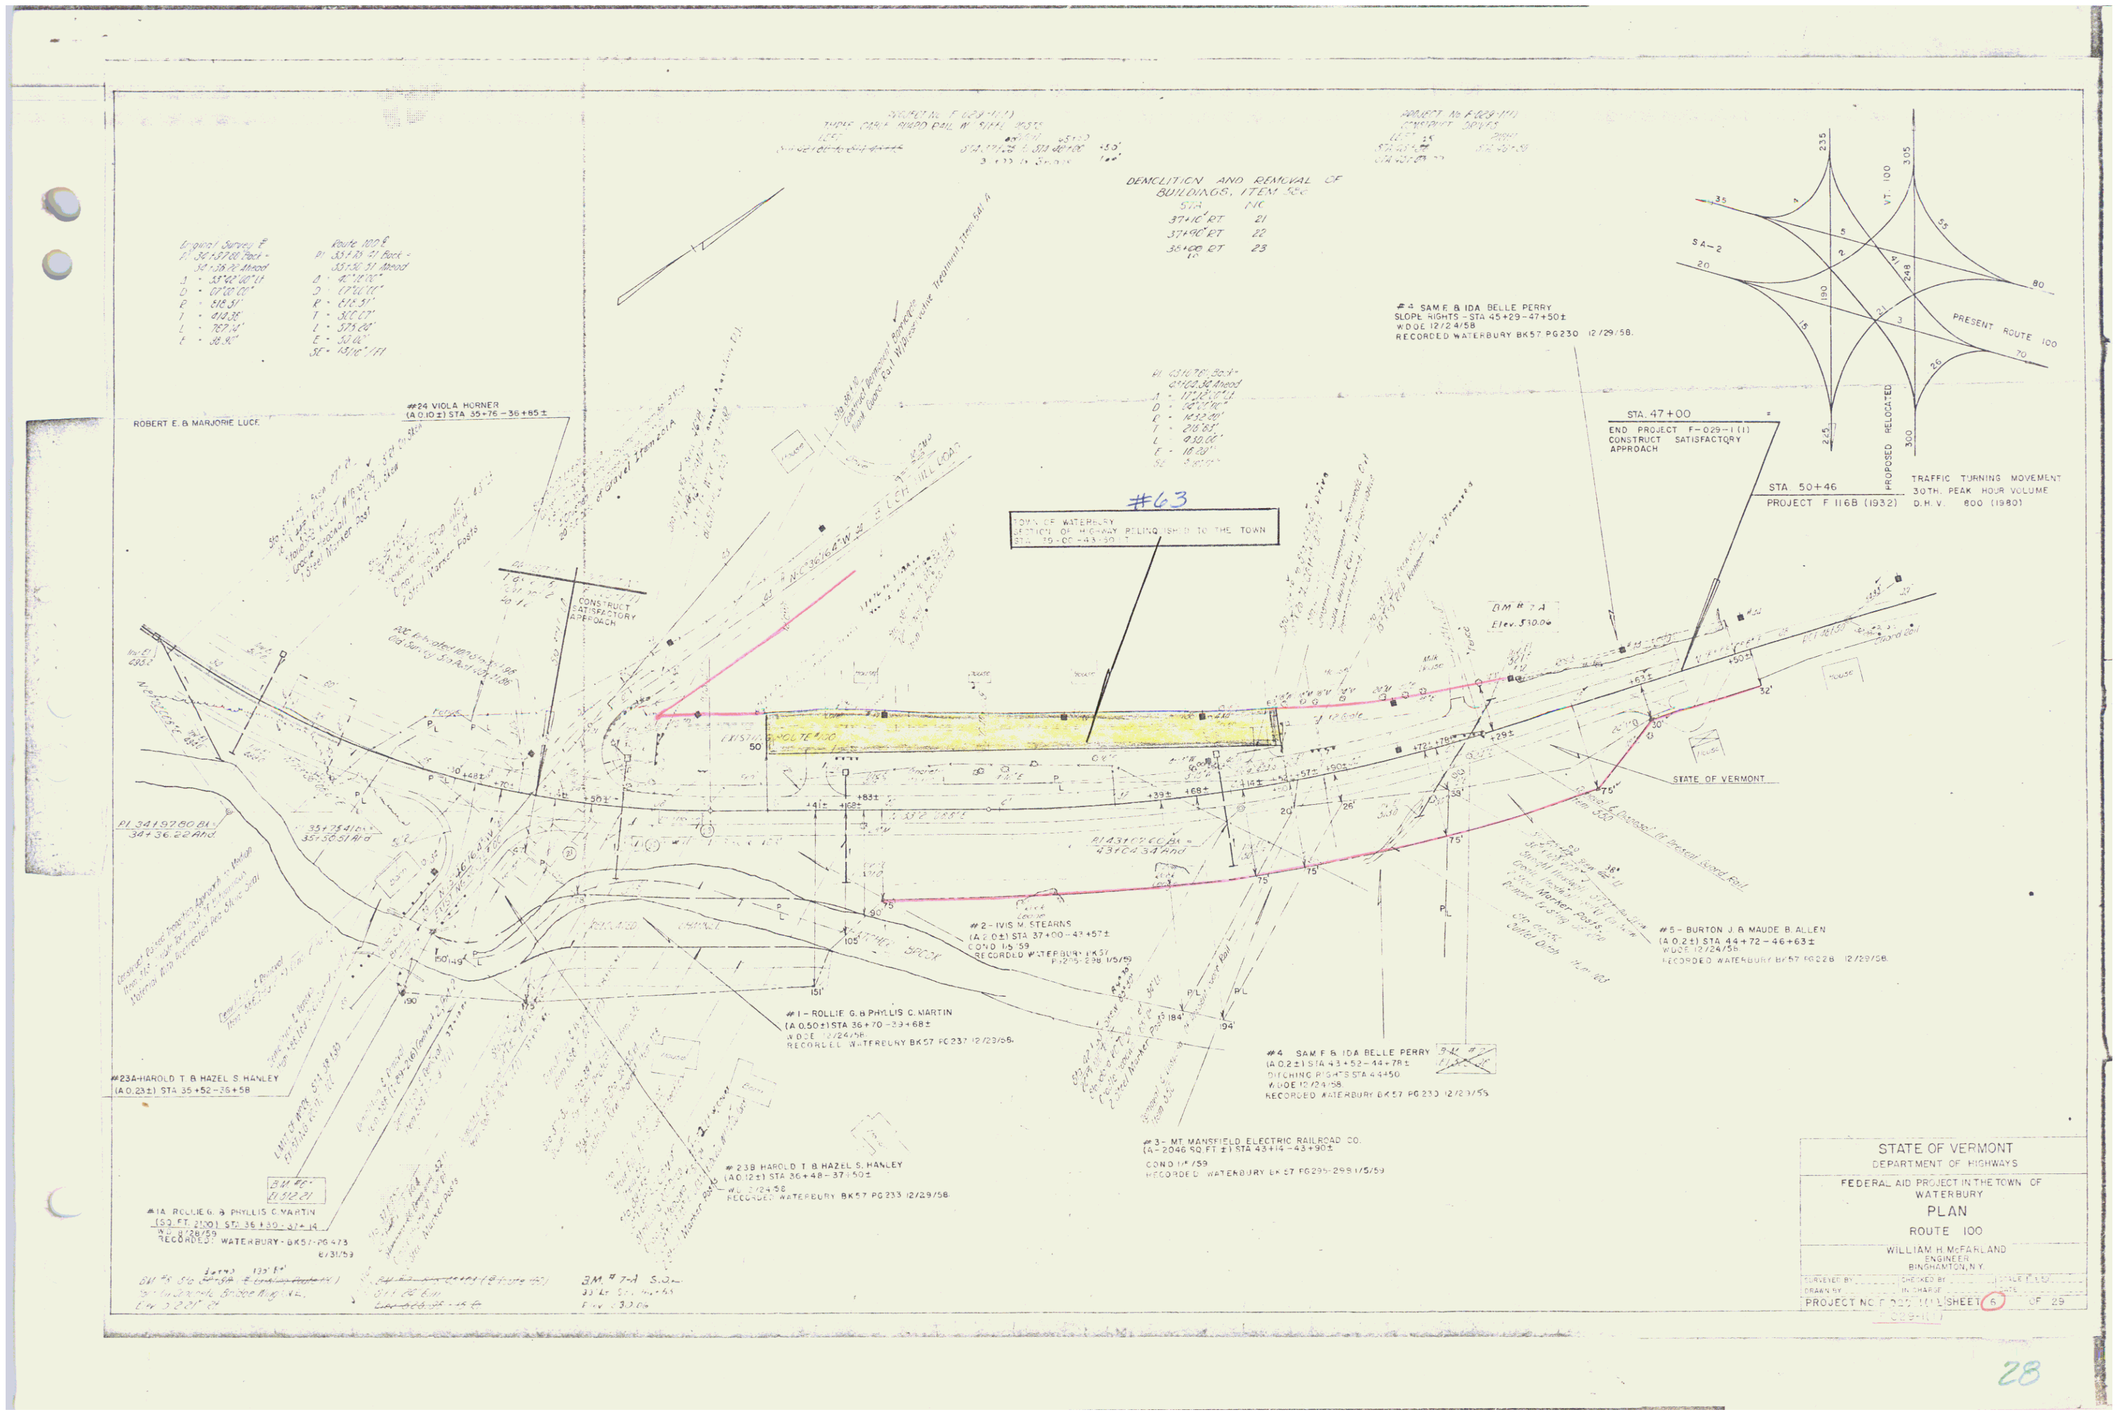
DEMOLITION AND REMOVAL OF BUILDINGS, ITEM 206
#4 SAM F. & IDA BELLE PERRY
SLOPE RIGHTS - STA 45+29-47+50±
W.O.D.E. 12/24/58
RECORDED WATERBURY BK57 PG230 12/29/58.
STA. 47+00
END PROJECT F-029-1(1)
CONSTRUCT SATISFACTORY APPROACH
STA. 50+46
PROJECT F 116B (1932)
PRESENT ROUTE 100
PROPOSED RELOCATED VT. 100
TRAFFIC TURNING MOVEMENT
30TH. PEAK HOUR VOLUME
D.H.V. 800 (1980)
#63
TOWN OF WATERBURY
SECTION OF HIGHWAY BELONGING TO THE TOWN
ROBERT E. & MARJORIE LUCE
#24 VIOLA HORNER
(A 0.10±) STA 35+76 - 36+85±
CONSTRUCT SATISFACTORY APPROACH
B.M. # 7-A
Elev. 510.00
STATE OF VERMONT
#2 - IVIS M. STEARNS
(A 2.0±) STA 37+00 - 41+57±
COND 1/5/59
RECORDED WATERBURY BK57 PG295-298 1/5/59
#5 - BURTON J. & MAUDE B. ALLEN
(A 0.2±) STA 44+72 - 46+63±
W.O.D.E. 12/24/58
RECORDED WATERBURY BK57 PG228 12/29/58.
#1 - ROLLIE G. & PHYLLIS C. MARTIN
(A 0.50±) STA 36+70 - 39+68±
W.O.D.E. 12/24/58
RECORDED WATERBURY BK57 PG237 12/29/58.
#23A-HAROLD T. & HAZEL S. HANLEY
(A 0.23±) STA 35+52 - 36+58
#4 SAM F. & IDA BELLE PERRY
(A 0.2±) STA 43+52 - 44+78±
DITCHING RIGHTS STA 44+50
W.O.D.E. 12/24/58
RECORDED WATERBURY BK57 PG233 12/29/58
#3 - MT. MANSFIELD ELECTRIC RAILROAD CO.
(A - 2046.90 FT. ±) STA 43+16 - 43+90±
COND 1/5/59
RECORDED WATERBURY BK57 PG295-298 1/5/59
#23B HAROLD T. & HAZEL S. HANLEY
(A 0.12±) STA 36+48 - 37+50±
W.O.D.E. 12/24/58
RECORDED WATERBURY BK57 PG233 12/29/58
#1A ROLLIE G. & PHYLLIS C. MARTIN
(50 FT. 21.00) STA 36+39 - 37+14
W.O.D.E. 8/28/59
RECORDED WATERBURY - BK57 - PG 473
6/31/59
STATE OF VERMONT
DEPARTMENT OF HIGHWAYS
FEDERAL AID PROJECT IN THE TOWN OF WATERBURY
PLAN
ROUTE 100
WILLIAM H. McFARLAND
ENGINEER
BINGHAMTON, N.Y.
PROJECT NO. F 029-1(1) SHEET 6 OF 29