EXCAVATION & REMOVAL OF ROAD SURFACE ON ROADWAYS ITEM 118-A			
LOCA.	STA.	STA.	POS.
	~~964+00~~	~~965+50~~	~~LT.~~
	~~973+50~~	~~979+25~~	~~LT.~~

SOD REMOVAL ITEM 101			
LOCA.	STA.	STA.	POS.
	~~960+40~~	~~968+80~~	

STANDARD STEEL BEAM GUARD RAIL WITH STEEL POSTS (MEDIAN TYPE) ITEM 547-A			
LOCA.	STA.	STA.	POS.
RT. LANE	964+00	980+00	RT.
	964+00	980+00	MED.

THREE CABLE GUARD RAIL WITH STEEL POSTS ITEM 543			
LOCA.	STA.	STA.	POS.
LT. LANE	964+00	973+~~25~~	LT.
"	978+25	980+00	LT.

REMOVAL OF EXISTING PAVEMENT ITEM 101-C			
LOCA.	STA.	STA.	POS.
	~~972+25~~	~~973+50~~	~~LT.~~

CONSTRUCT ROCK FILL SEE SPECIAL PROVISION NO.			
LOCA.	STA.	STA.	POS.
	965+00	970+00	LT.

MAINTENANCE of TRAFFIC
CONSTRUCT TEMP. ROADWAY
STA. 979+00 LT - STA. 980+00 LT
SEE SPECIAL PROVISION NO. 5
SEE SHEET, 175 OF 296

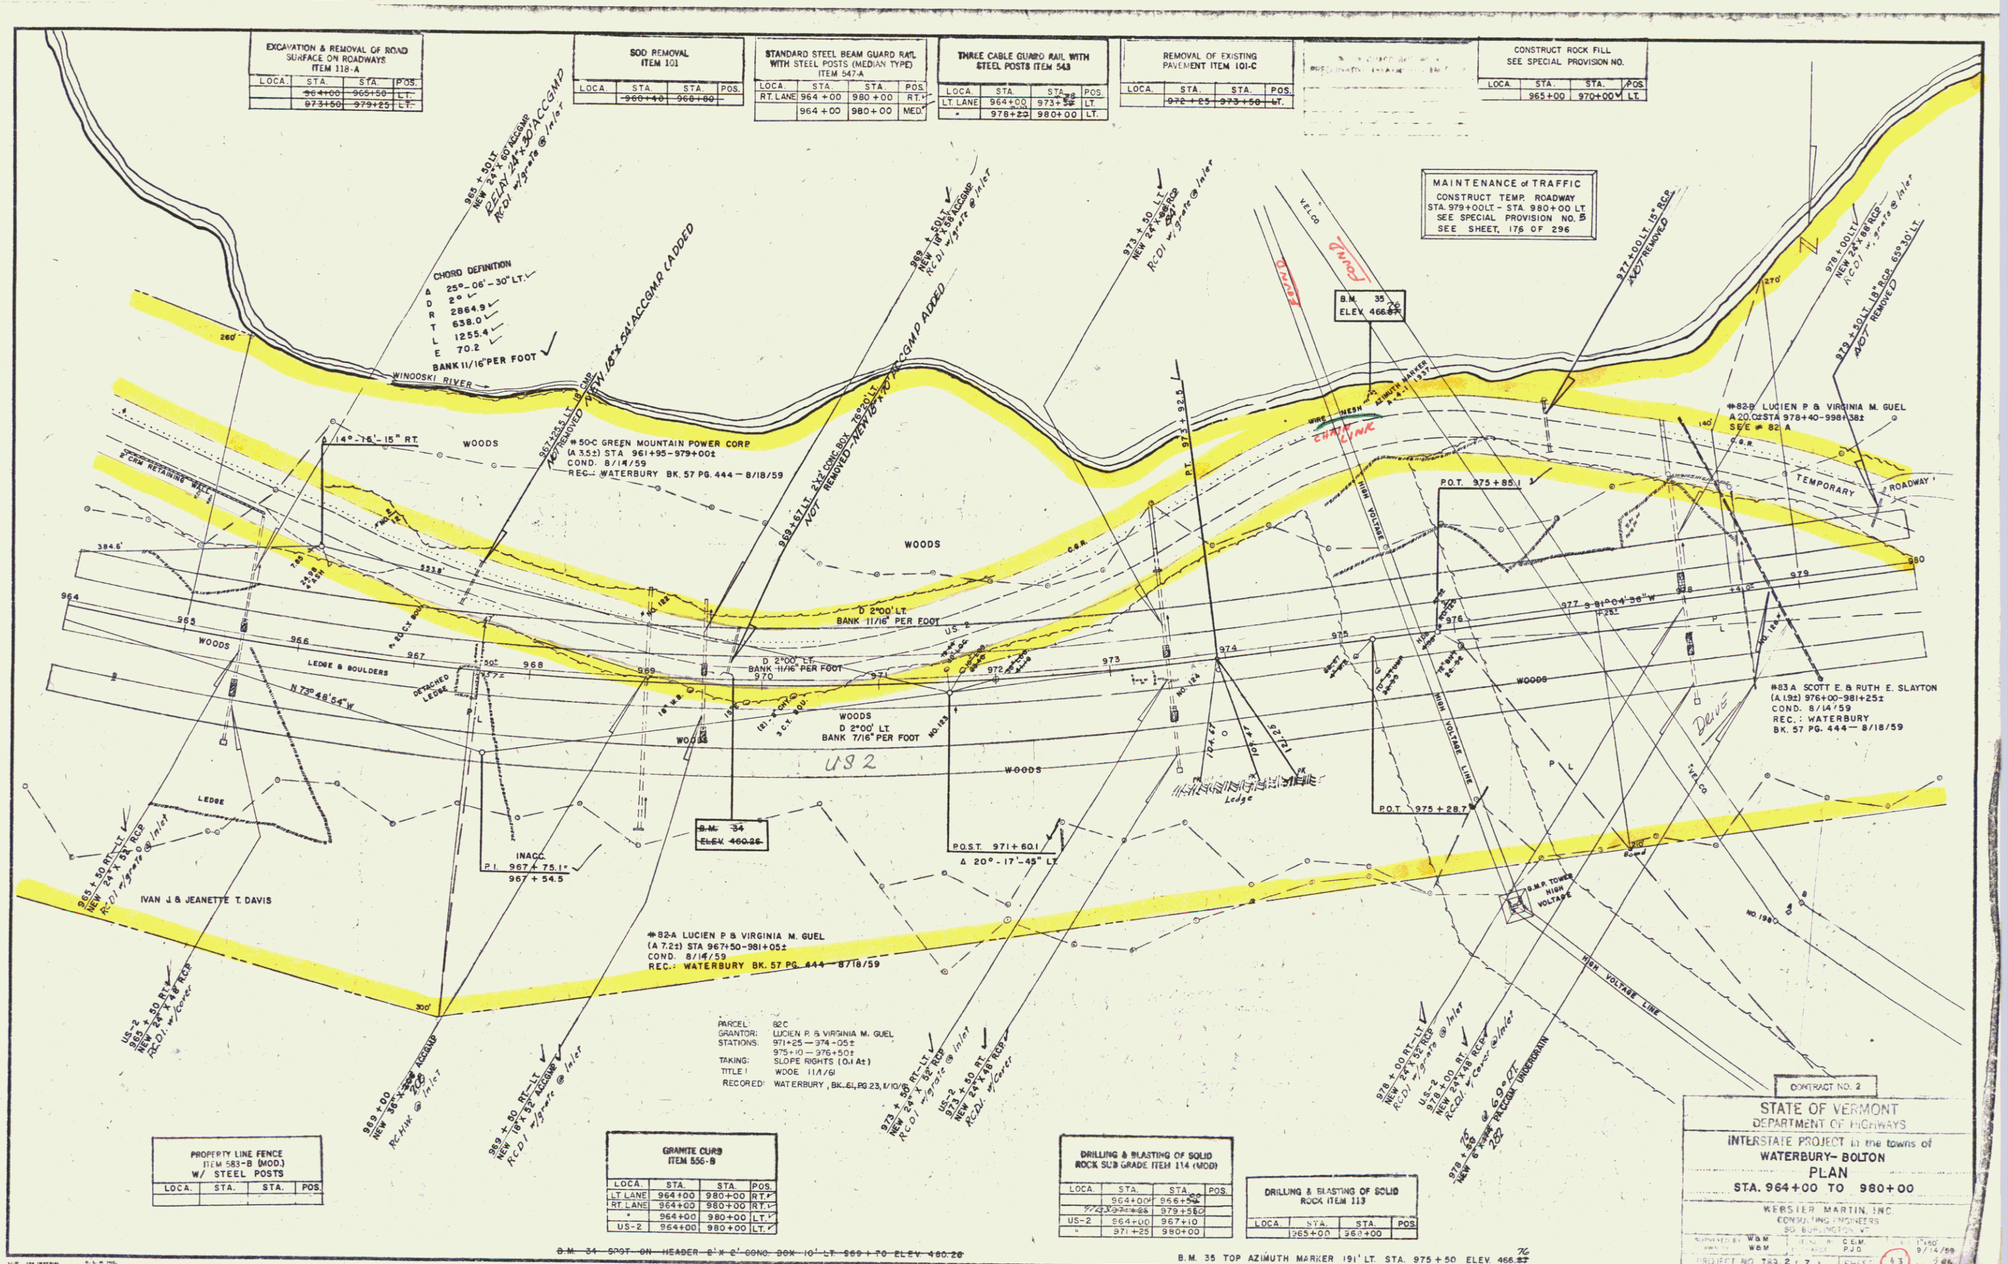

PROPERTY LINE FENCE ITEM 583-B (MOD.) W/ STEEL POSTS			
LOCA.	STA.	STA.	POS.

GRANITE CURB ITEM 556-B			
LOCA.	STA.	STA.	POS.
LT. LANE	964+00	980+00	RT.
RT. LANE	964+00	980+00	RT.
"	964+00	980+00	LT.
US-2	964+00	980+00	LT.

DRILLING & BLASTING OF SOLID ROCK SUB GRADE ITEM 114 (MOD)			
LOCA.	STA.	STA.	POS.
	964+00	966+~~50~~ 75	
	~~972+25~~ 974+25	979+50	
US-2	964+00	967+10	
"	971+25	980+00	

DRILLING & BLASTING OF SOLID ROCK ITEM 113			
LOCA.	STA.	STA.	POS.
	965+00	969+00	

~~B.M. 34 SPOT ON HEADER 6' X 6' CONC. BOX 10' LT. 969+70 ELEV. 460.26~~

B.M. 35 TOP AZIMUTH MARKER 191' LT. STA. 975 + 50 ELEV. 466.~~27~~ 76

CONTRACT NO. 2

STATE OF VERMONT
DEPARTMENT OF HIGHWAYS
INTERSTATE PROJECT in the towns of
WATERBURY- BOLTON
PLAN
STA. 964+00 TO 980+00

WEBSTER MARTIN, INC.
CONSULTING ENGINEERS
BURLINGTON, VT.

SURVEYED BY	DRAWN BY	CHECKED BY	DATE
WBM	WBM	C.E.M. P.J.D.	9/14/59

PROJECT NO. T83 2 (7) SHEET 63 OF 246

14