DRILLING & BLASTING OF SOLID ROCK SUB GRADE ITEM 114 (MOD)			
LOCA.	STA.	STA.	POS.
	1092+00	1094+50	
US-2	1092+00	1094+50	

PLANK GUARD RAIL WITH PRESERVATIVE TREATMENT ITEM 541-A (BARRICADE)		
LOCA.	STATION	POS.
	1101+50	LT

THREE CABLE GUARD RAIL WITH STEEL POSTS ITEM 543			
LOCA.	STA.	STA.	POS.
LT. LANE	1107+25	1108+00	LT.
RT. LANE	1107+25	1108+00	RT.
US-2	~~1094+21~~	~~1094+29~~	~~LT.~~

PROPERTY LINE FENCE ITEM 583-B (MOD.) W/ STEEL POSTS			
LOCA.	STA.	STA.	POS.
RT. LANE	1092+00	~~1094+50~~	RT.
LT. LANE	1092+00	1093+00	LT.

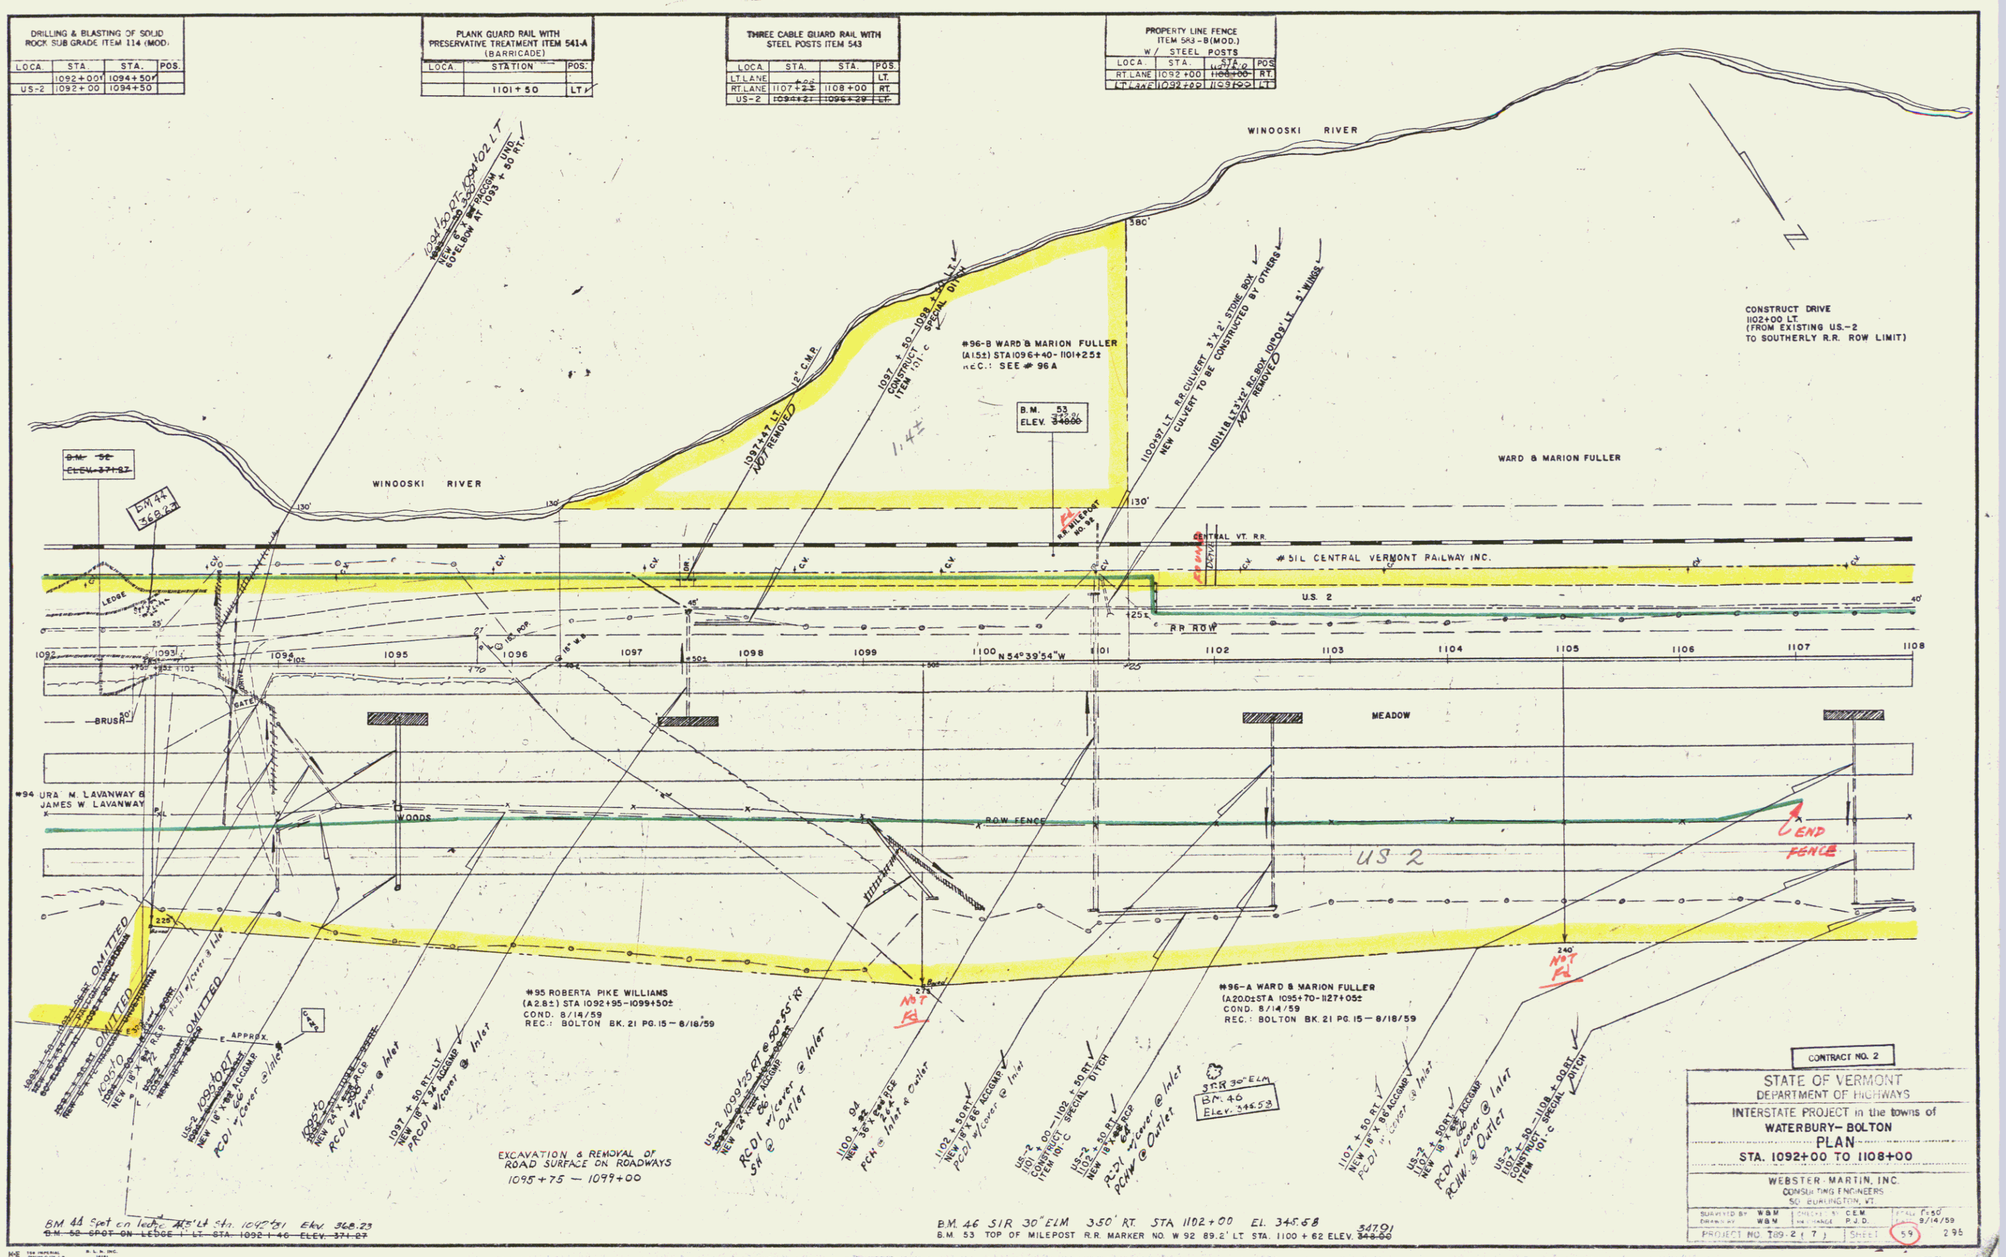

22