Property Line Fence, Item 583-B. Mod.
1698+00 - 1710+00 NB Rt.
1698+00 - 1711+00 SB Lt.

1710+00 - 1711+00 NB Rt.

BITUMINOUS CONCRETE SURFACE FOR GUTTERS AND TRAFFIC ISLANDS, ITEM 554
1699+00 SB Lt.

PARCEL: 520 A
STATIONS: 1690+90 NB – 1713+40 SB
TAKING: 18.7 A ±

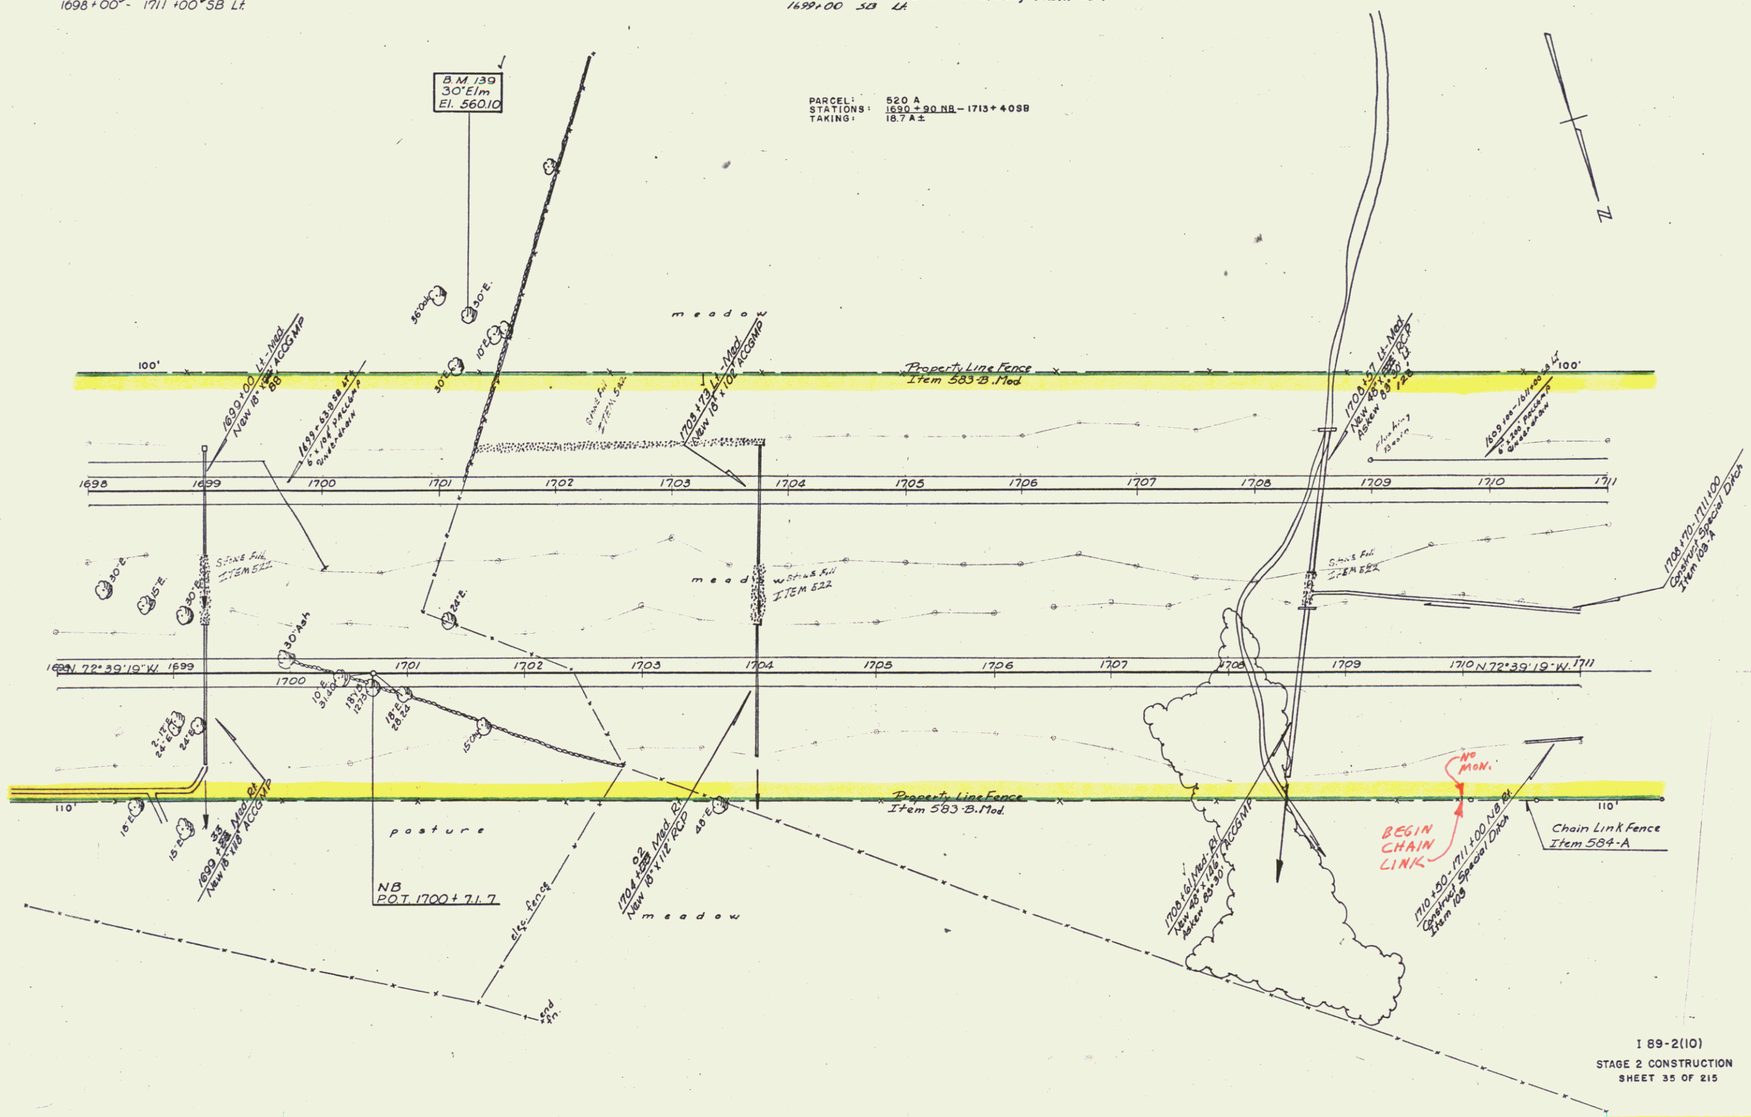

I 89-2(10)
STAGE 2 CONSTRUCTION
SHEET 35 OF 215

RICHMOND-WILLISTON
I-89-2(9)
Surv.-Spaulding & Martin 4-'59
Plot.-Trombly-WJ, Traced-WJ-'59
Sheet 131 of 225

CONTRACT II

const. ROW
14