THREE CABLE GUARD RAIL with STEEL POSTS Item 543
1792 + 50 to 1805 + 46.25 SB Rt.
1793 + 66 to 1805 + 61.25 NB Rt
1799 + 48 to 1803 + 00 SB Lt.

Property Line Fence Item 583 B, Mod.
1799 + 10 - 1807 + 00 SB Lt.
1791 + 00 - 1807 + 00 NB Rt

DRILLING AND BLASTING OF SOLID ROCK SUBGRADE ITEM 114-Mod.
NB 1791 + 00 - 1793 + 50
SB 1791 + 00 - 1795 + 00
SB 1804 + 50 - 1807 + 00

PAVED MEDIAN GUTTER
1800 + 53 - 1800 + 75
1803 + 25 - 1803 + 75

Bituminous Concrete Curb - Item 555
1793 + 00 to 1805 + 62 SB. Rt

BITUMINOUS CONCRETE SURFACE FOR GUTTERS AND TRAFFIC ISLANDS — ITEM 554
1794 + 00 SB Lt. 1794 + 12 NB Lt.
1794 + 60 SB Lt. 1806 + 62 NB Lt
1806 + 10 SB Lt.
1805 + 50 to 1806 + 50 SB Rt.

PARCEL : 531
GRANTOR : HERBERT C., JR. & RITA GOODRICH
STATIONS : 1786+35 NB — 1799+08 SB ±
TAKING : 12.0 A ±
REMAINDER : 321.0 A ±
RIGHTS :
CULVERT — STA. 1790+60 NB, 1794+12 NB, 1797+50 NB ±

TITLE TAKEN : COND. 12/28/60
RECORDED : WILLISTON HWY BK I PG 21-48 12/28/60

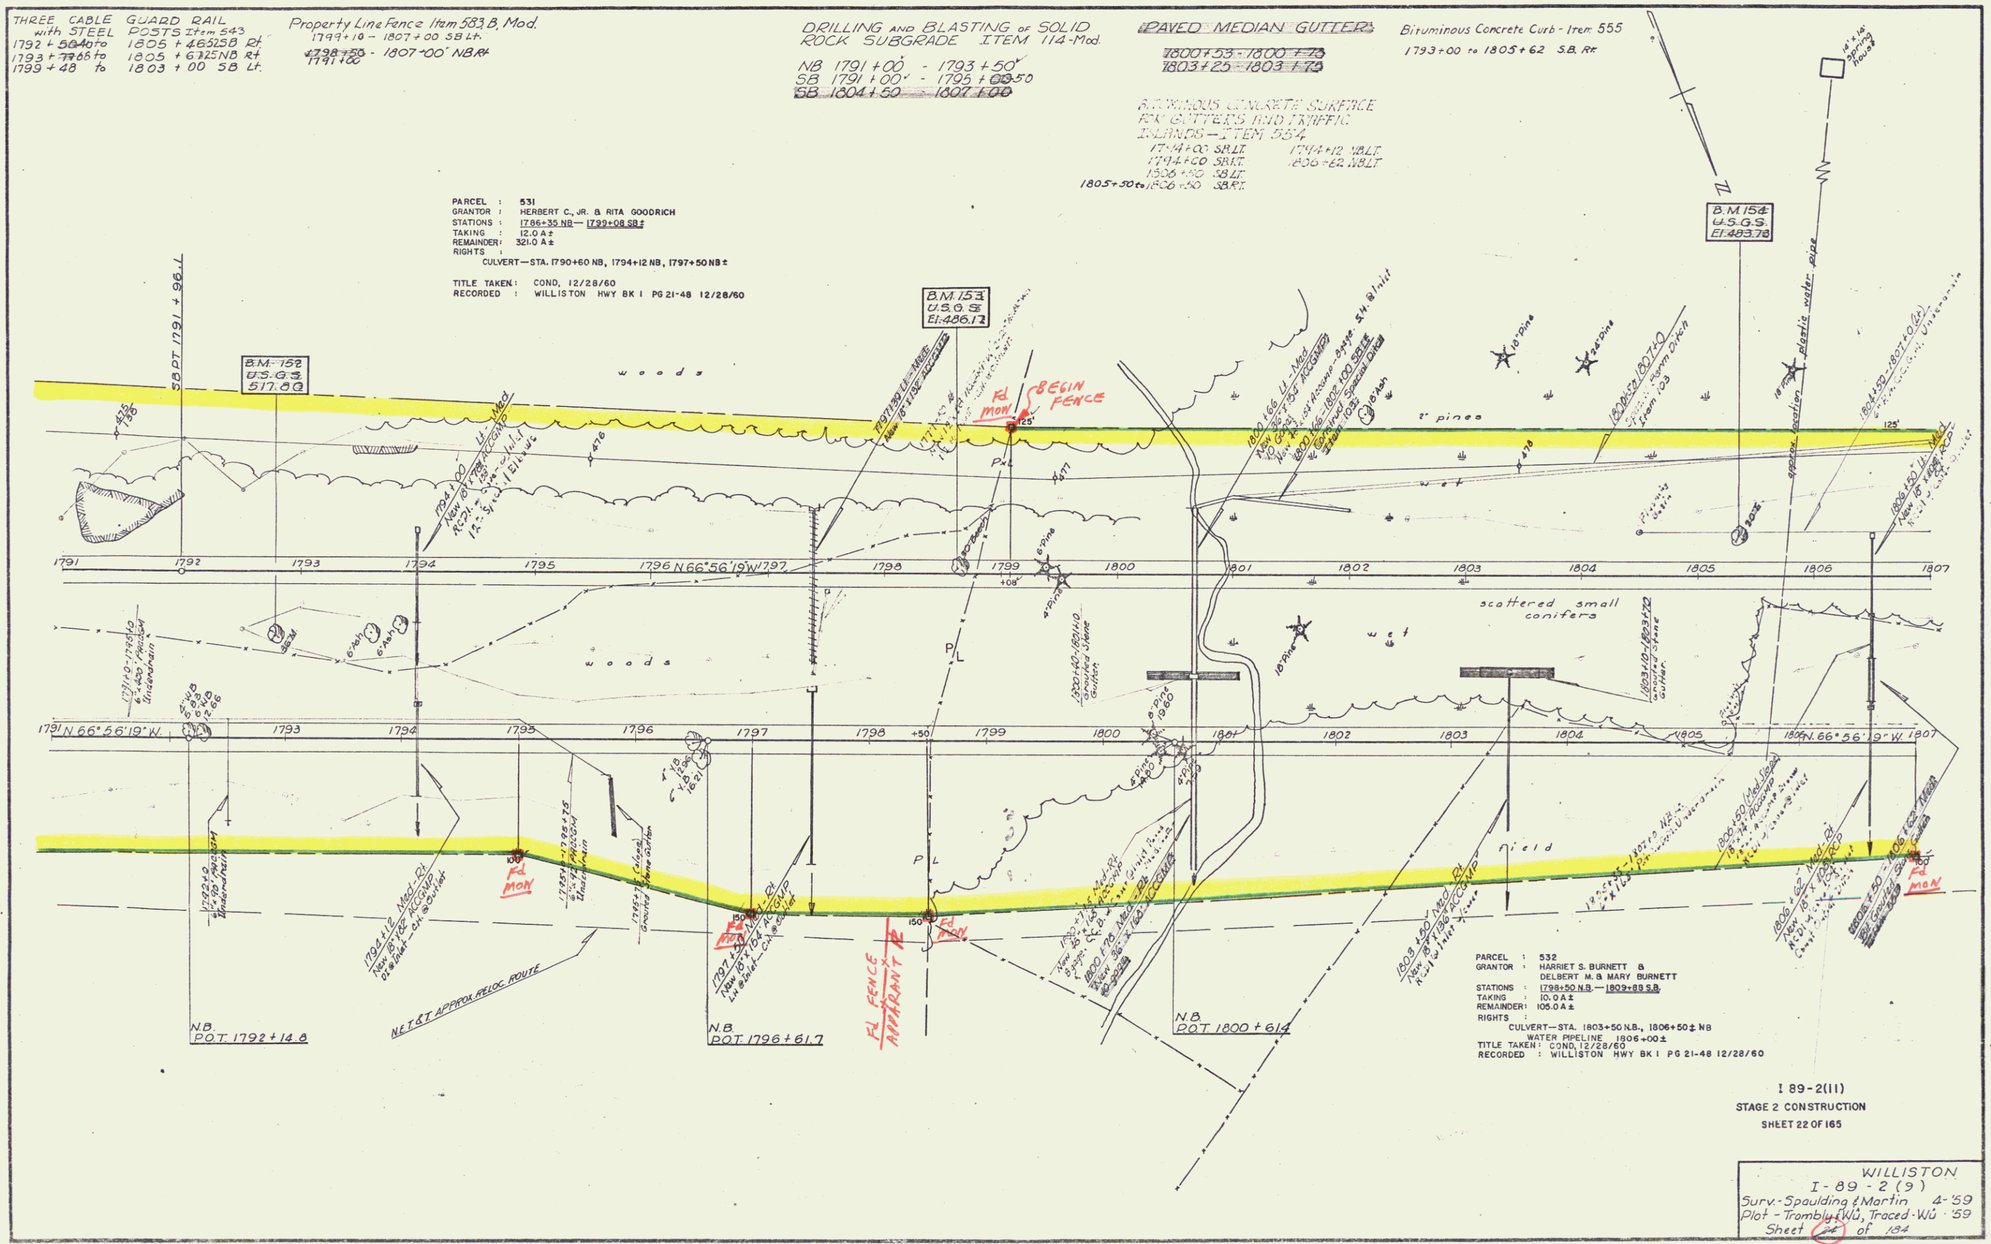

PARCEL : 532
GRANTOR : HARRIET S. BURNETT &
DELBERT M. & MARY BURNETT
STATIONS : 1798+50 N.B. — 1809+83 S.B.
TAKING : 10.0 A ±
REMAINDER : 105.0 A ±
RIGHTS :
CULVERT — STA. 1803+50 N.B., 1806+50 ± NB
WATER PIPELINE 1806+00 ±
TITLE TAKEN : COND. 12/28/60
RECORDED : WILLISTON HWY BK I PG 21-48 12/28/60

I 89-2(11)
STAGE 2 CONSTRUCTION
SHEET 22 OF 165

WILLISTON
I-89-2(9)
Surv - Spaulding & Martin 4-59
Plot - Trombly & Wu, Traced - Wu 59
Sheet 24 of 184
CONTRACT III

24