THREE CABLE GUARD RAIL WITH STEEL POSTS ITEM 543 *
STA 1875+98 TO STA. 1883+50 N.B. RT.

STANDARD STEEL BEAM GUARD RAIL ITEM 547-A *
STA. 1875 + 75 TO STA. 1876+19 N.B. LT.
STA. 1875 + 49 TO STA. 1876+33 S.B. LT.
STA. 1875 + 69 TO STA. 1876+23 S.B. RT.

PROPERTY LINE FENCE WITH STEEL POSTS ITEM 583-B MOD.
STA. 1875+00 TO 1883+00 - N.B. RT. - 1000'
STA. 1875+00 TO 1883+45 - S.B. LT. - 845'
STA. 1883+30 TO 1885+00 - S.B. LT. - 170'
2015' 2012

MUCK EXCAVATION ITEM 116
STA. 1882+53 TO STA. 1885+00 N.B.
STA. 1882+50 TO STA. 1885+00 S.B.

FED. ROAD DIV. No.	STATE	FEDERAL PROJECT No.	SHEET	TOTAL SHEETS
1	VERMONT	I-89-3(14)	11	115

* STAGE 2 ITEMS

ERECT R.O.W. FENCE PRIOR TO CONSTRUCTION
FROM STA 1883+30 TO STA. 1885+00 LT
1882+40 1885+00 RT

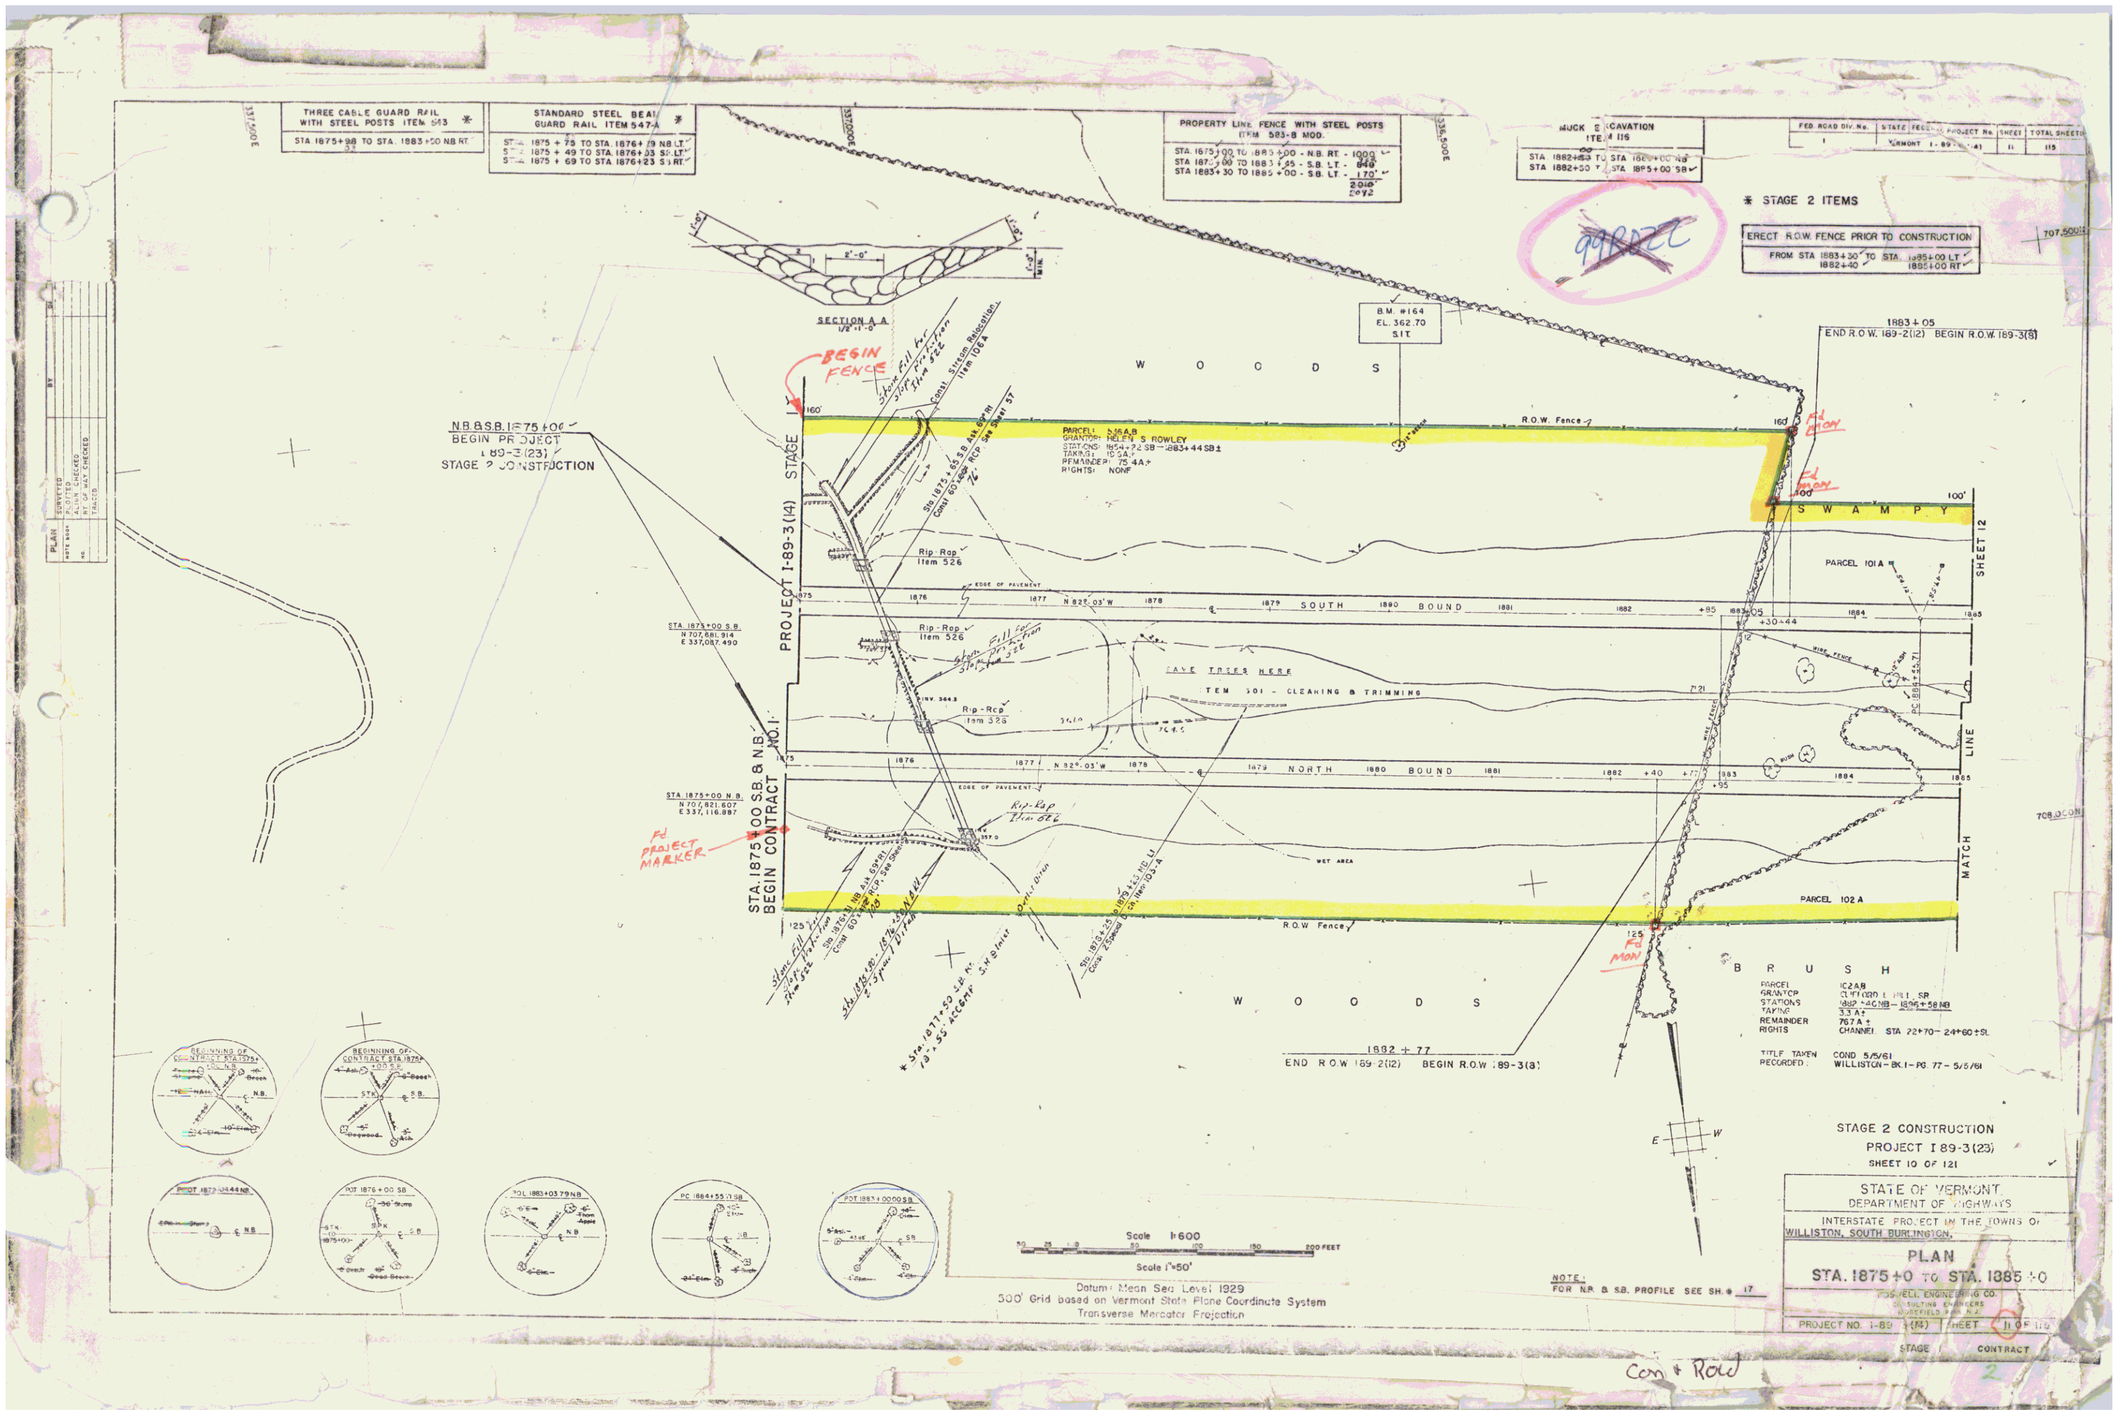

Con + Road