FED. ROAD DIV. No.	STATE	FEDERAL PROJECT No.	SHEET	TOTAL SHEETS
1	VERMONT	1-89-3(14)	16	115

PROPERTY LINE FENCE WITH STEEL POSTS
ITEM 583-B MOD.

STA. 1945+00 TO 1947+00 ± N.B. RT. - ~~150'~~ 172'
STA. 1945+00 TO 1946+50 ± S.B. LT. - ~~150'~~ 150'
~~300~~ 322'

ERECT R.O.W. FENCE PRIOR TO CONSTRUCTION
FROM STA. 1945+00 TO STA. 1947+00 RT.

* STAGE 2 ITEMS

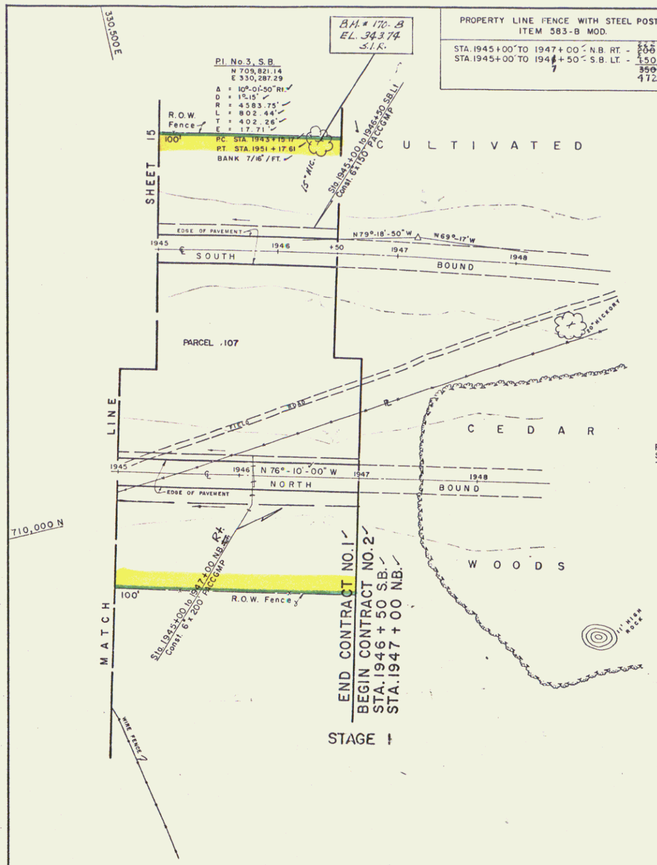

PARCEL 201 A
STATIONS 1942+82 NB — 1951+80 NB
TAKING 16.1 A ±

NOTE
FOR N.B. & S.B. PROFILE SEE SH. # 20

STAGE 2 CONSTRUCTION
I 89-3(23)
SHEET 15 OF 121

STATE OF VERMONT
DEPARTMENT OF HIGHWAYS

INTERSTATE PROJECT IN THE TOWNS OF
WILLISTON, SOUTH BURLINGTON.

PLAN
STA. 1945+0 to STA. 1946+50

BOSWELL ENGINEERING CO. RIDGEFIELD PARK, N.J.

DRAWN BY	IN CHARGE	SCALE
CHECKED BY	DATE	

PROJECT NO. I-89-3(14) | SHEET OF 115

(16) STAGE 1 CONTRACT 1

const & ROW