FED. ROAD DIV. No.	STATE	FEDERAL PROJECT No	SHEET	TOTAL SHEETS
1	VERMONT	I-89-3(14)	23	125

CONTRACT NO. 2

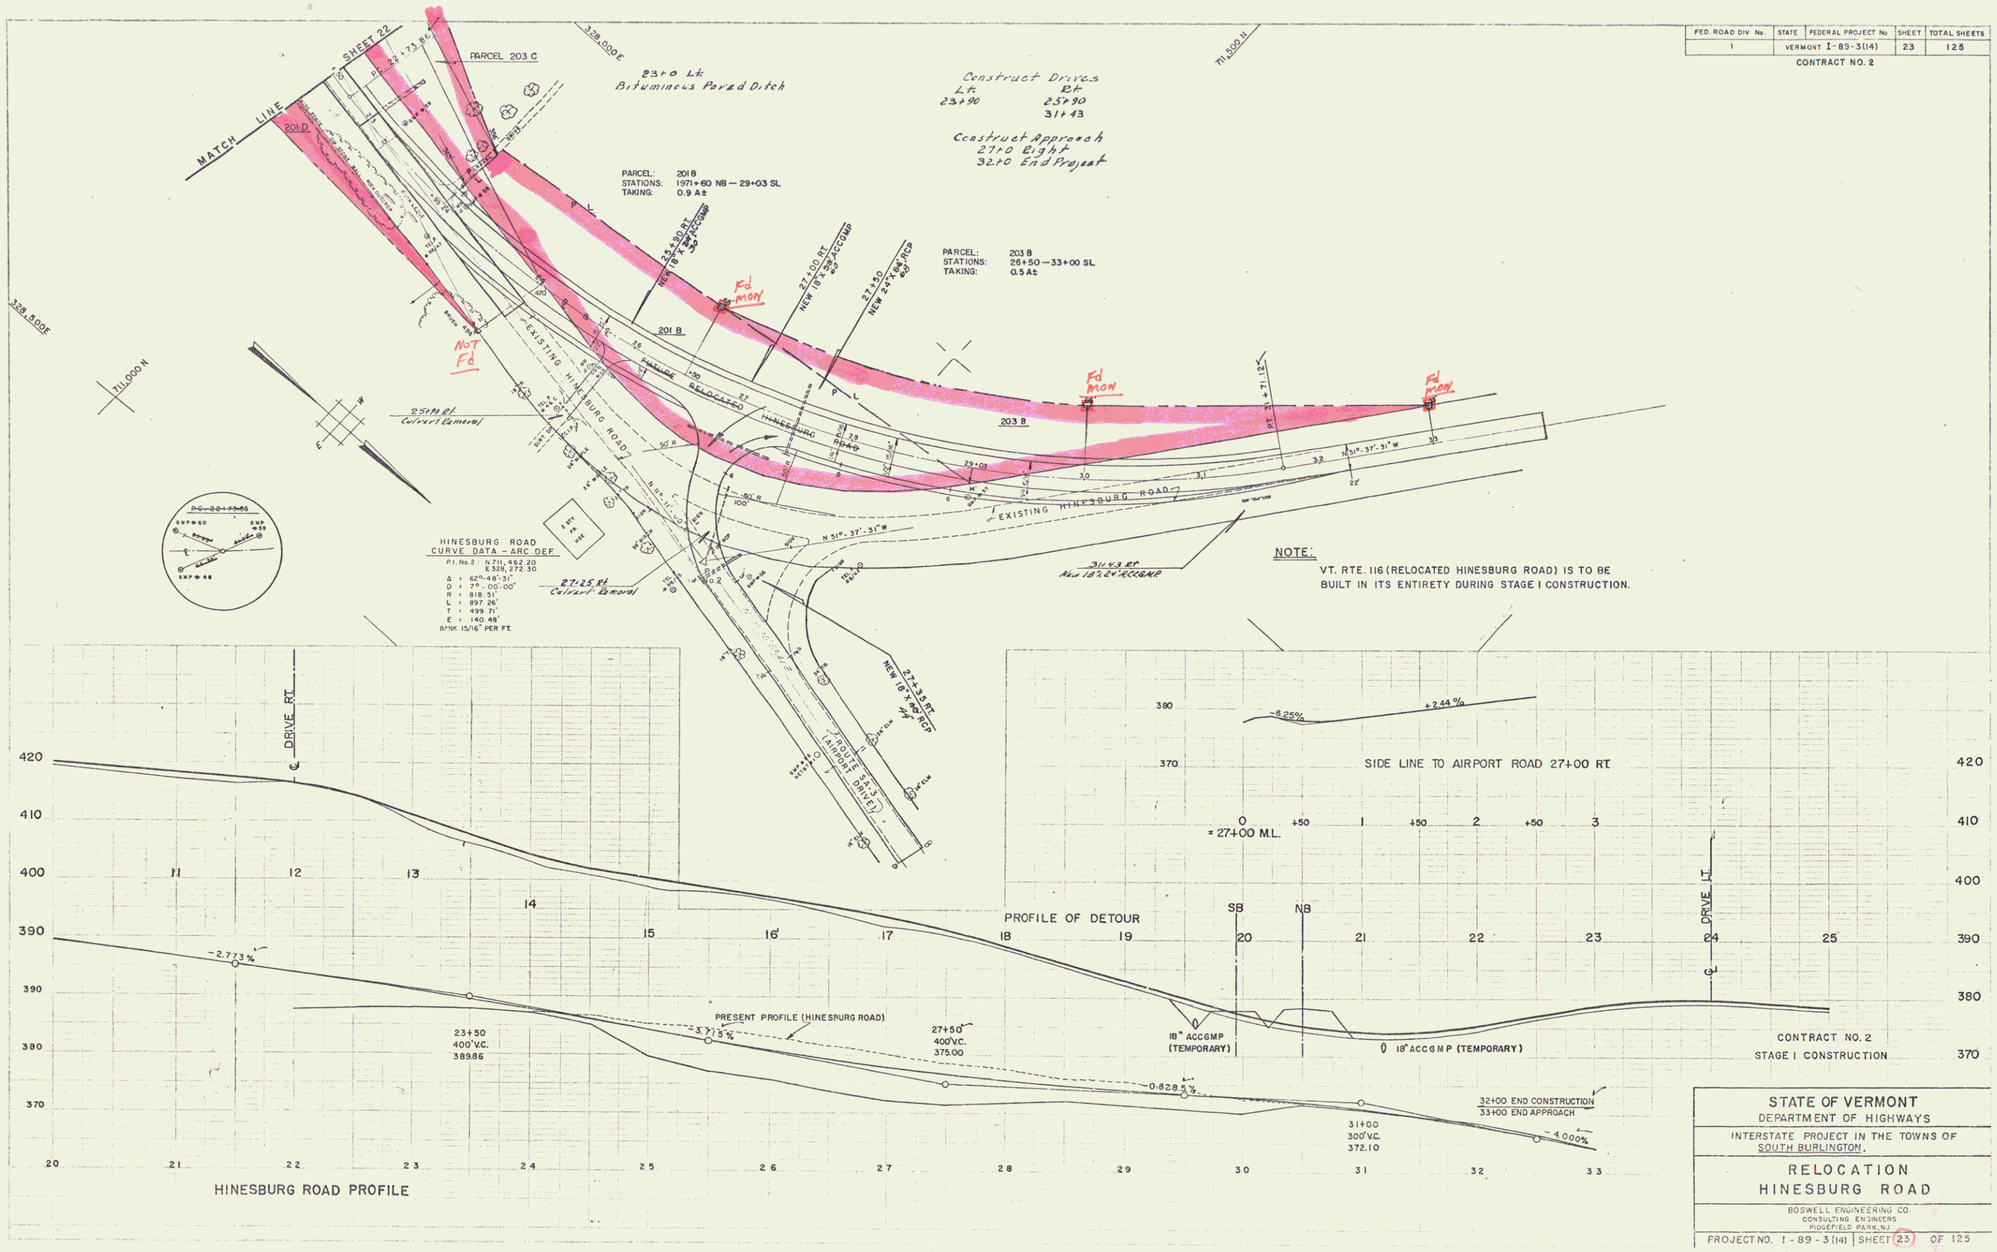

STATE OF VERMONT
DEPARTMENT OF HIGHWAYS

INTERSTATE PROJECT IN THE TOWNS OF SOUTH BURLINGTON.

RELOCATION
HINESBURG ROAD

BOSWELL ENGINEERING CO.
CONSULTING ENGINEERS
RIDGEFIELD PARK, N.J.

PROJECT NO. I-89-3(14) | SHEET 23 OF 125

Const & R.O.W

13