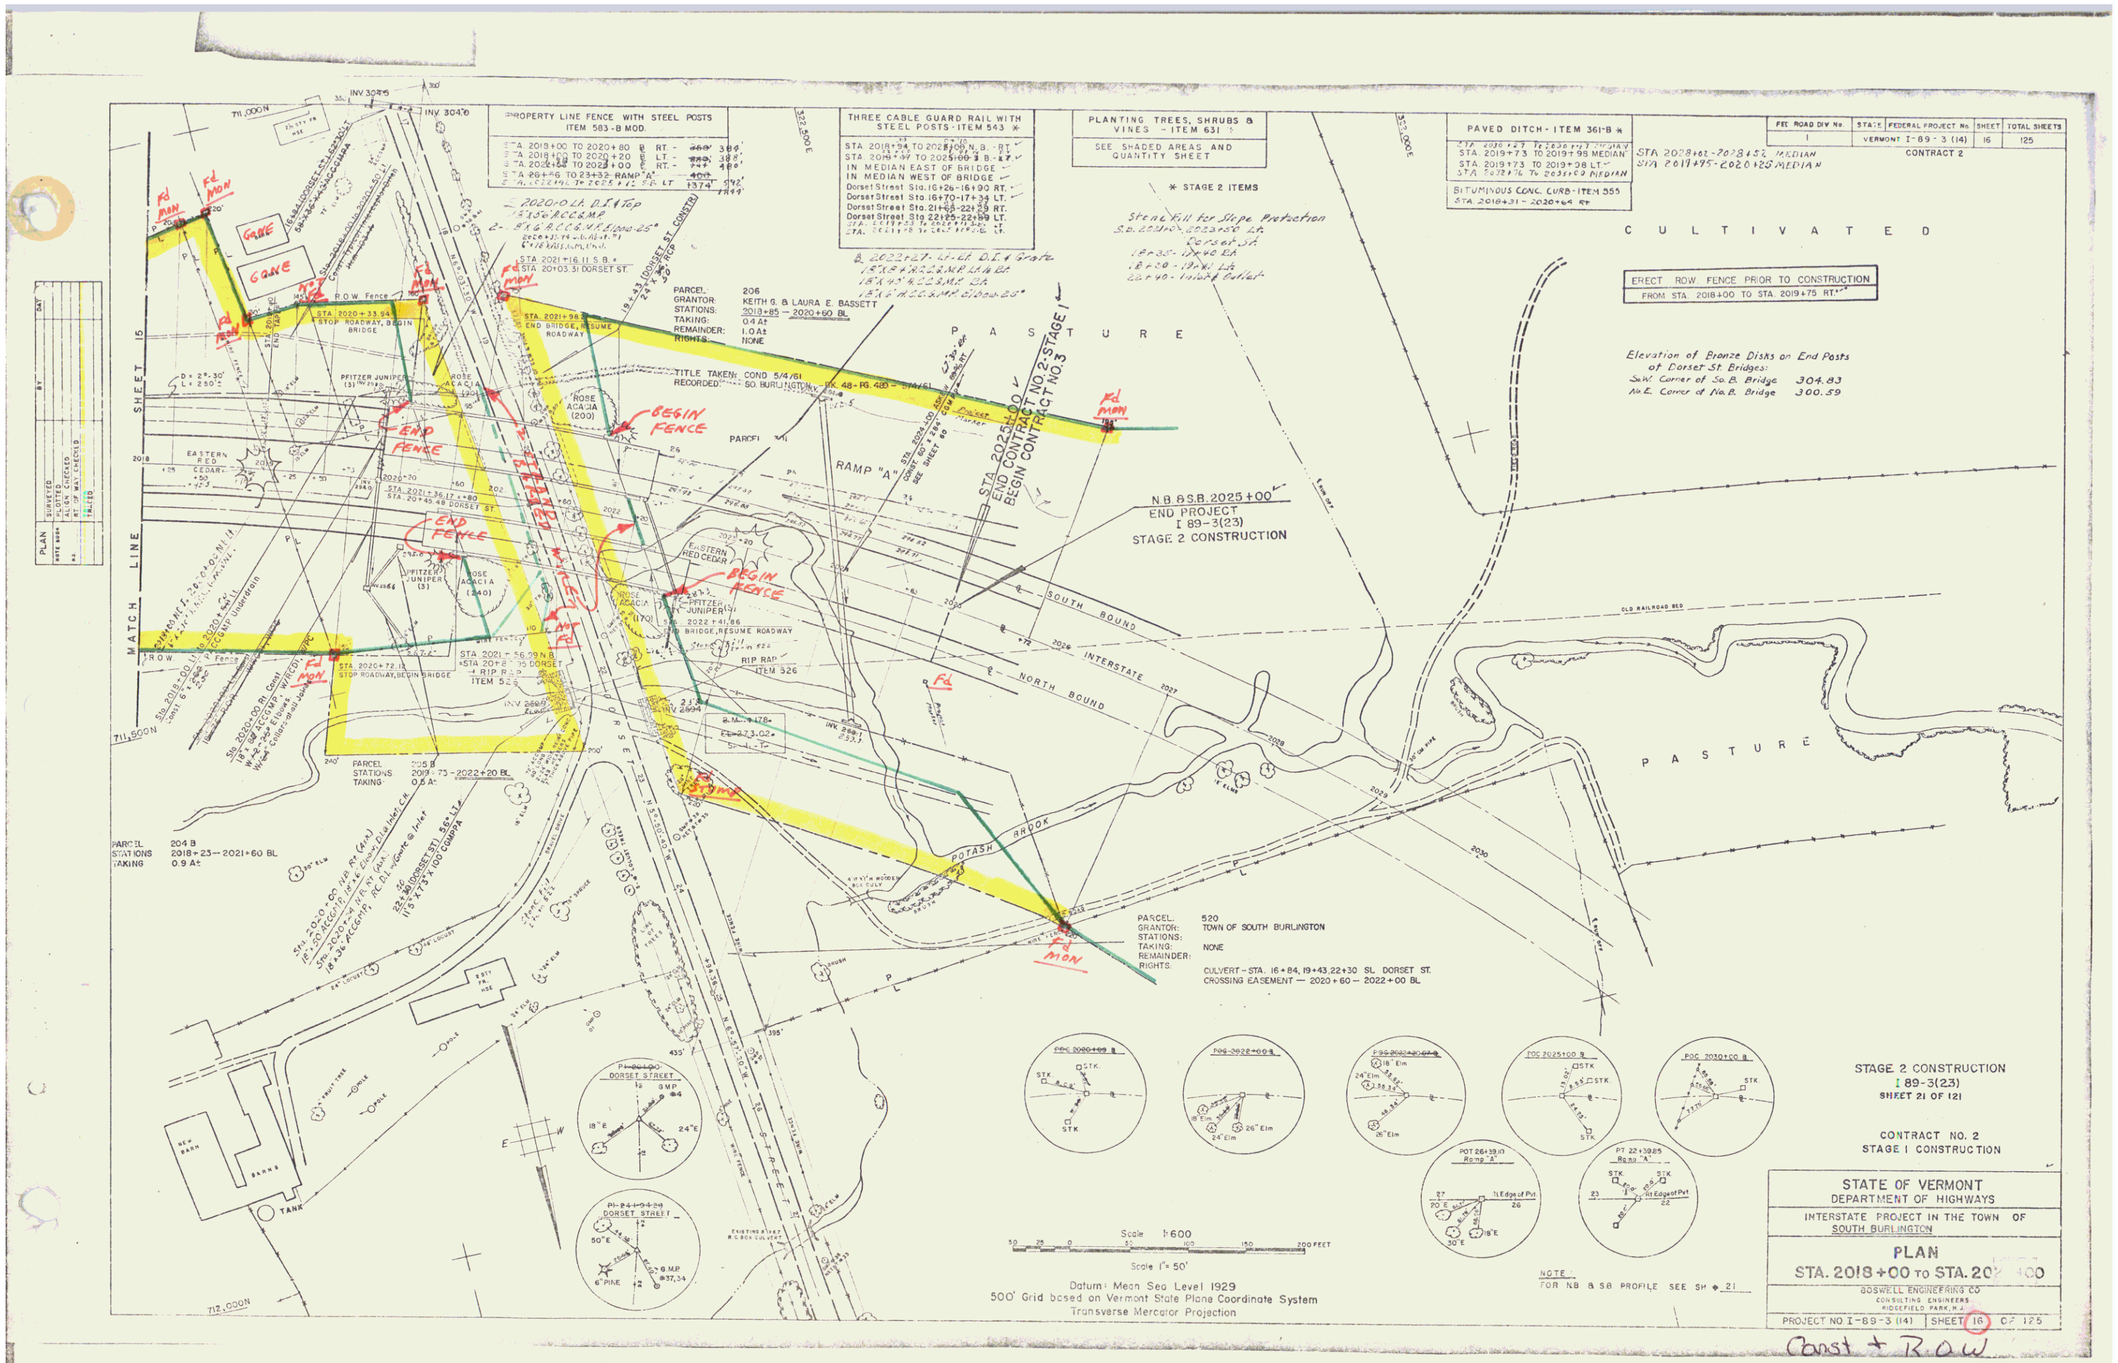
PROPERTY LINE FENCE WITH STEEL POSTS ITEM 583-B MOD.
STA. 2019+00 TO 2020+80 B RT. - 780' 380'
STA. 2018+00 TO 2020+20 B LT. - 820' 38'
STA. 2022+00 TO 2023+00 B RT. - 744' 480'
STA. 2016+46 TO 2+32 RAMP "A" 405
STA. 2022+00 TO 2025+00 B RT. LT. 1374' 592' 1966'
THREE CABLE GUARD RAIL WITH STEEL POSTS - ITEM 543 *
STA. 2018+94 TO 2022+00 N.B. - RT.
STA. 2019+97 TO 2025+00 S.B. - LT.
IN MEDIAN EAST OF BRIDGE
IN MEDIAN WEST OF BRIDGE
Dorset Street Sta. 16+26-16+90 RT.
Dorset Street Sta. 16+70-17+34 LT.
Dorset Street Sta. 21+65-22+29 RT.
Dorset Street Sta. 22+25-22+89 LT.
PLANTING TREES, SHRUBS & VINES - ITEM 631 *
SEE SHADED AREAS AND QUANTITY SHEET
* STAGE 2 ITEMS
PAVED DITCH - ITEM 361-B *
STA. 2019+73 TO 2019+98 MEDIAN
STA. 2019+73 TO 2019+98 LT.
BITUMINOUS CONC. CURB - ITEM 555
STA. 2018+31 - 2020+64 RT.
STA. 2028+62-2028+85 MEDIAN
STA. 2019+95-2020+25 MEDIAN
FED. ROAD DIV. No. 1
STATE VERMONT
FEDERAL PROJECT No. I-89-3(14)
SHEET 16
TOTAL SHEETS 125
CONTRACT 2
CULTIVATED
ERECT ROW FENCE PRIOR TO CONSTRUCTION
FROM STA. 2018+00 TO STA. 2019+75 RT.
Elevation of Bronze Disks on End Posts of Dorset St. Bridges:
S.W. Corner of So. B. Bridge 304.83
No. E. Corner of No. B. Bridge 300.59
PASTURE
PARCEL 206
GRANTOR: KEITH G. & LAURA E. BASSETT
STATIONS: 2018+85 — 2020+60 BL
TAKING: 0.4 A±
REMAINDER: 1.0 A±
RIGHTS: NONE
TITLE TAKEN: COND 5/4/61
RECORDED: SO. BURLINGTON
RAMP "A"
STA. 2025+00 END CONTRACT NO. 2 STAGE I BEGIN CONTRACT NO. 3
N.B. & S.B. 2025+00 END PROJECT I 89-3(23) STAGE 2 CONSTRUCTION
SOUTH BOUND
INTERSTATE
NORTH BOUND
OLD RAILROAD BED
POTASH BROOK
PARCEL 520
GRANTOR: TOWN OF SOUTH BURLINGTON
STATIONS:
TAKING: NONE
REMAINDER:
RIGHTS:
CULVERT - STA. 16+84, 19+43, 22+30 SL DORSET ST.
CROSSING EASEMENT — 2020+60 — 2022+00 BL
PARCEL 205 B
STATIONS 2019+73 - 2022+20 BL
TAKING 0.5 A±
PARCEL 204 B
STATIONS 2018+23 — 2021+60 BL
TAKING 0.9 A±
MATCH LINE SHEET 15
Scale 1:600
Scale 1" = 50'
Datum: Mean Sea Level 1929
500' Grid based on Vermont State Plane Coordinate System
Transverse Mercator Projection
NOTE
FOR NB & SB PROFILE SEE SH. 21
STAGE 2 CONSTRUCTION
I 89-3(23)
SHEET 21 OF 121
CONTRACT NO. 2
STAGE I CONSTRUCTION
STATE OF VERMONT
DEPARTMENT OF HIGHWAYS
INTERSTATE PROJECT IN THE TOWN OF SOUTH BURLINGTON
PLAN
STA. 2018+00 TO STA. 2025+00
BOSWELL ENGINEERING CO.
CONSULTING ENGINEERS
RIDGEFIELD PARK, N.J.
PROJECT NO. I-89-3(14) SHEET 16 OF 125

Const + R.O.W

17