FED. ROAD DIV. No.	STATE	FEDERAL PROJECT No.	SHEET	TOTAL SHEETS
1	VERMONT	I-89-3(12)	16	175

CURVE DATA					
NO.	Δ	R	L	T	BANK IN/FT
RAMP E					
E-3	161°-49'-35.5"	225.00'	635.49'	1406.81'	7/8"
RAMP F					
F-3	66°-19'-00.4"	200.00'	233.49'	130.62'	1/2"
	65°-56'-0"	1[illegible]	229.82'	123.54	
RAMP G					
G-1	175°-57'-41.16"	250.00'	767.78'		1/2"
RAMP H					
H-1	~~[illegible]~~	~~247.98~~	~~3[illegible]~~	~~184.42~~	1"
	71°-00'-15" Rt	249.13	308.71	177.72	

GRANITE SLOPE EDGING
ITEM 556-A *

STA 36+72 TO 38+39 Lt. Ramp "E"
STA 22+37 TO 6[illegible]+26 Rt. Ramp "F"
STA 10+28 TO 1[illegible]+00 Lt. Ramp "G"
STA. 22+25 TO 23+73 Rt. Ramp "H"

CONSTRUCT DRIVES

~~Reloc. Dorset St. Sta. 8+85 Lt.~~
Reloc. Dorset St. 8+66 Lt.
~~Reloc. Dorset St. 8+90 Lt.~~
Reloc. Dorset St. 8+66 Lt.
Reloc. Dorset St. 8+66 Rt.

PLANTING TREES, SHRUBS AND VINES - ITEM 631 - MOD. *

(SEE SHADED AREAS & QUANTITY SHEET)
SPECIAL GRASS SEED:
U.S. RTE. 2 STA. 31+00 TO 31+60 RT.

TREE CABLE GUARD RAIL AND STEEL POSTS - ITEM 543 *

Ramp "G" 12+40-13+70 Lt.

* STAGE II ITEMS

CHAIN LINK FENCE (ALUMINUM)
ITEM 590-A 6' HIGH

STA 19+85 TO 26+88 RAMP "H" RT. - 7' 2"
STA 21+70 TO ~~23~~ 23+60 RAMP "F" RT. - ~~[illegible]~~ 860

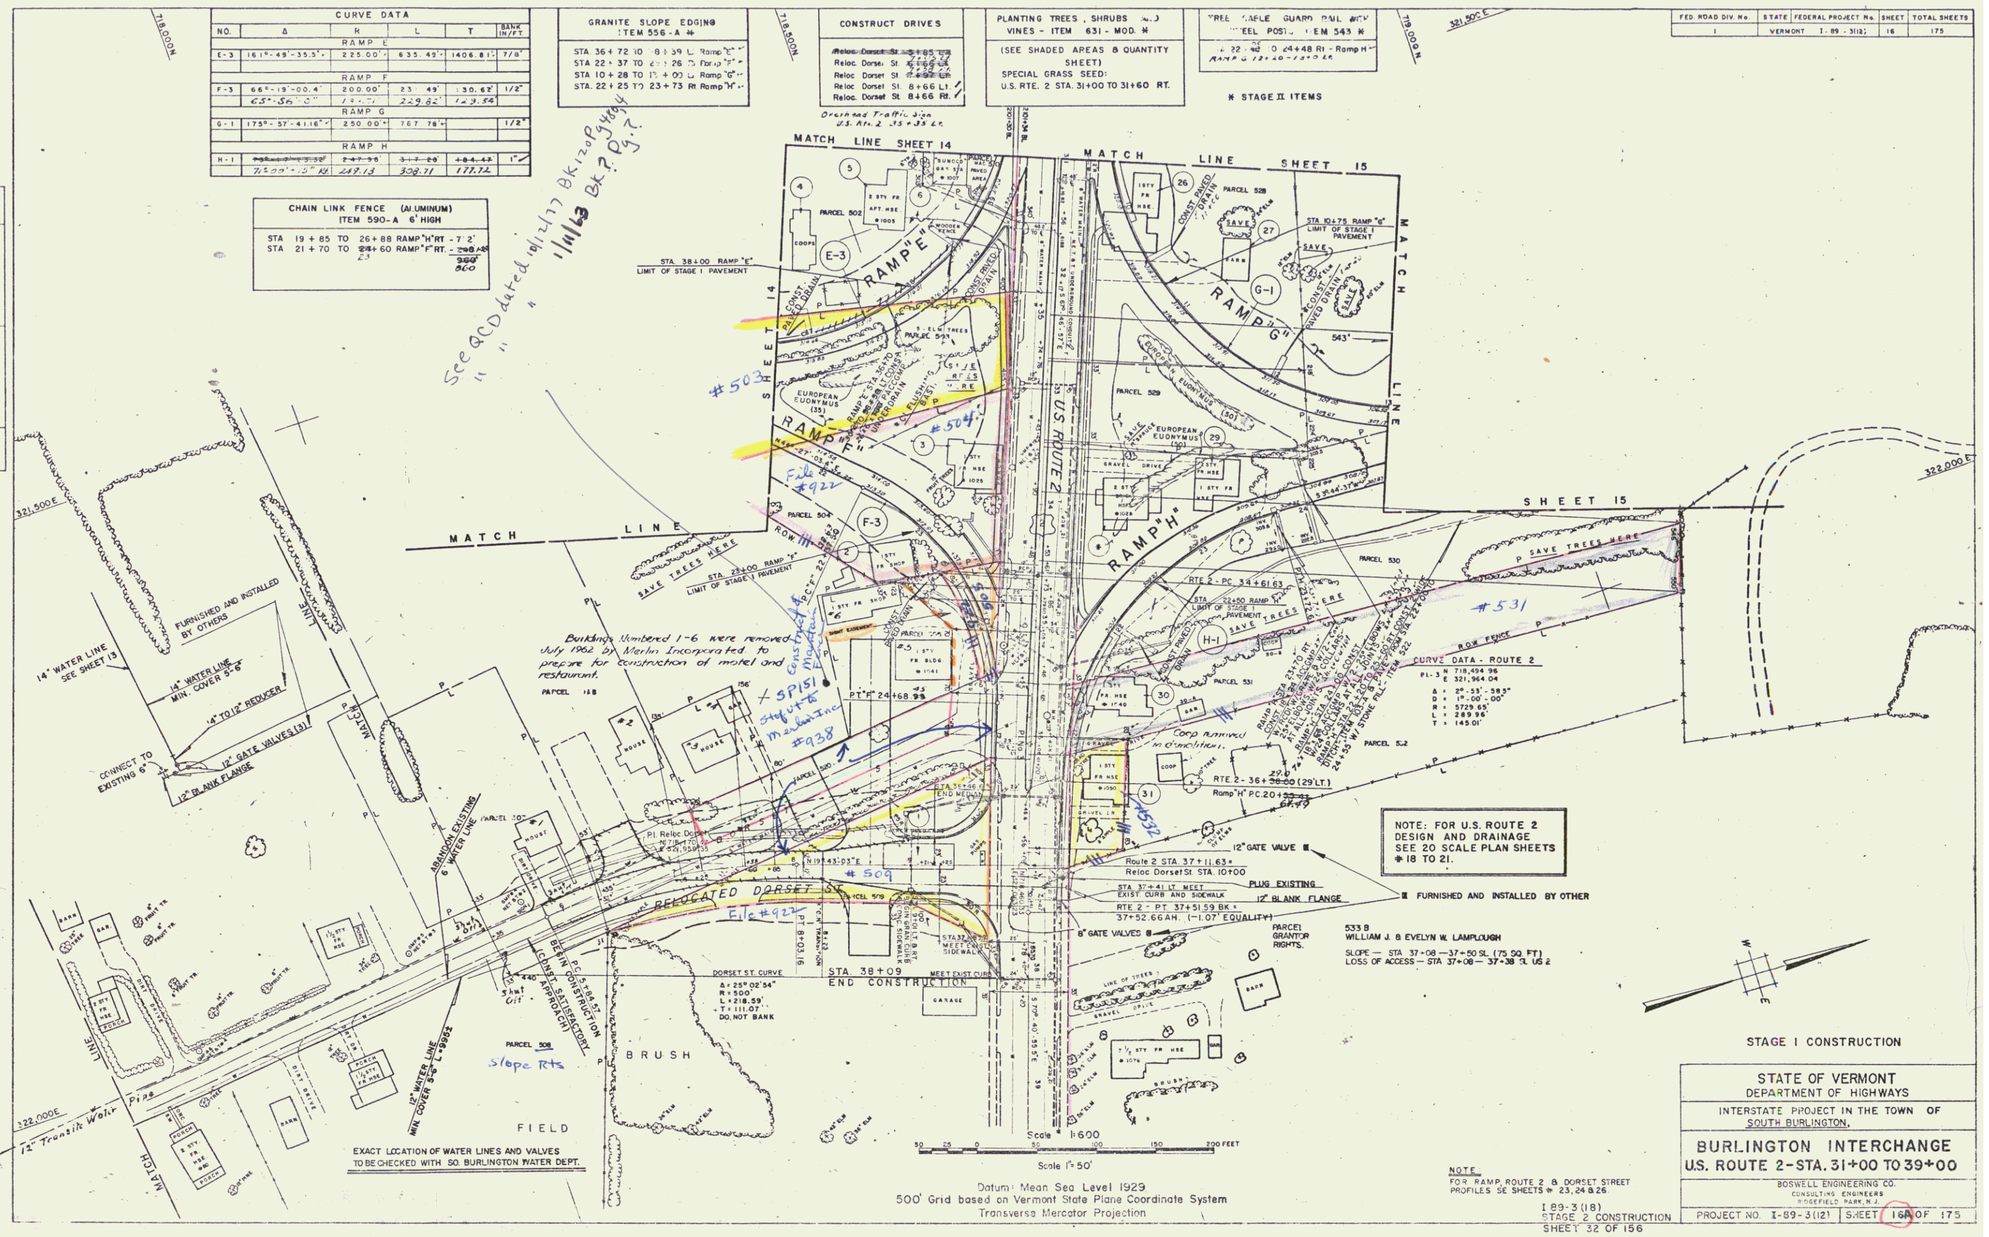

NOTE:
FOR RAMP, ROUTE 2 & DORSET STREET PROFILES SE SHEETS # 23, 24 & 26

I 89-3(18)
STAGE 2 CONSTRUCTION
SHEET 32 OF 156

STAGE I CONSTRUCTION

STATE OF VERMONT
DEPARTMENT OF HIGHWAYS

INTERSTATE PROJECT IN THE TOWN OF SOUTH BURLINGTON.

BURLINGTON INTERCHANGE
U.S. ROUTE 2-STA. 31+00 TO 39+00

BOSWELL ENGINEERING CO.
CONSULTING ENGINEERS
RIDGEFIELD PARK, N.J.

PROJECT NO. I-89-3(12) | SHEET 16A OF 175