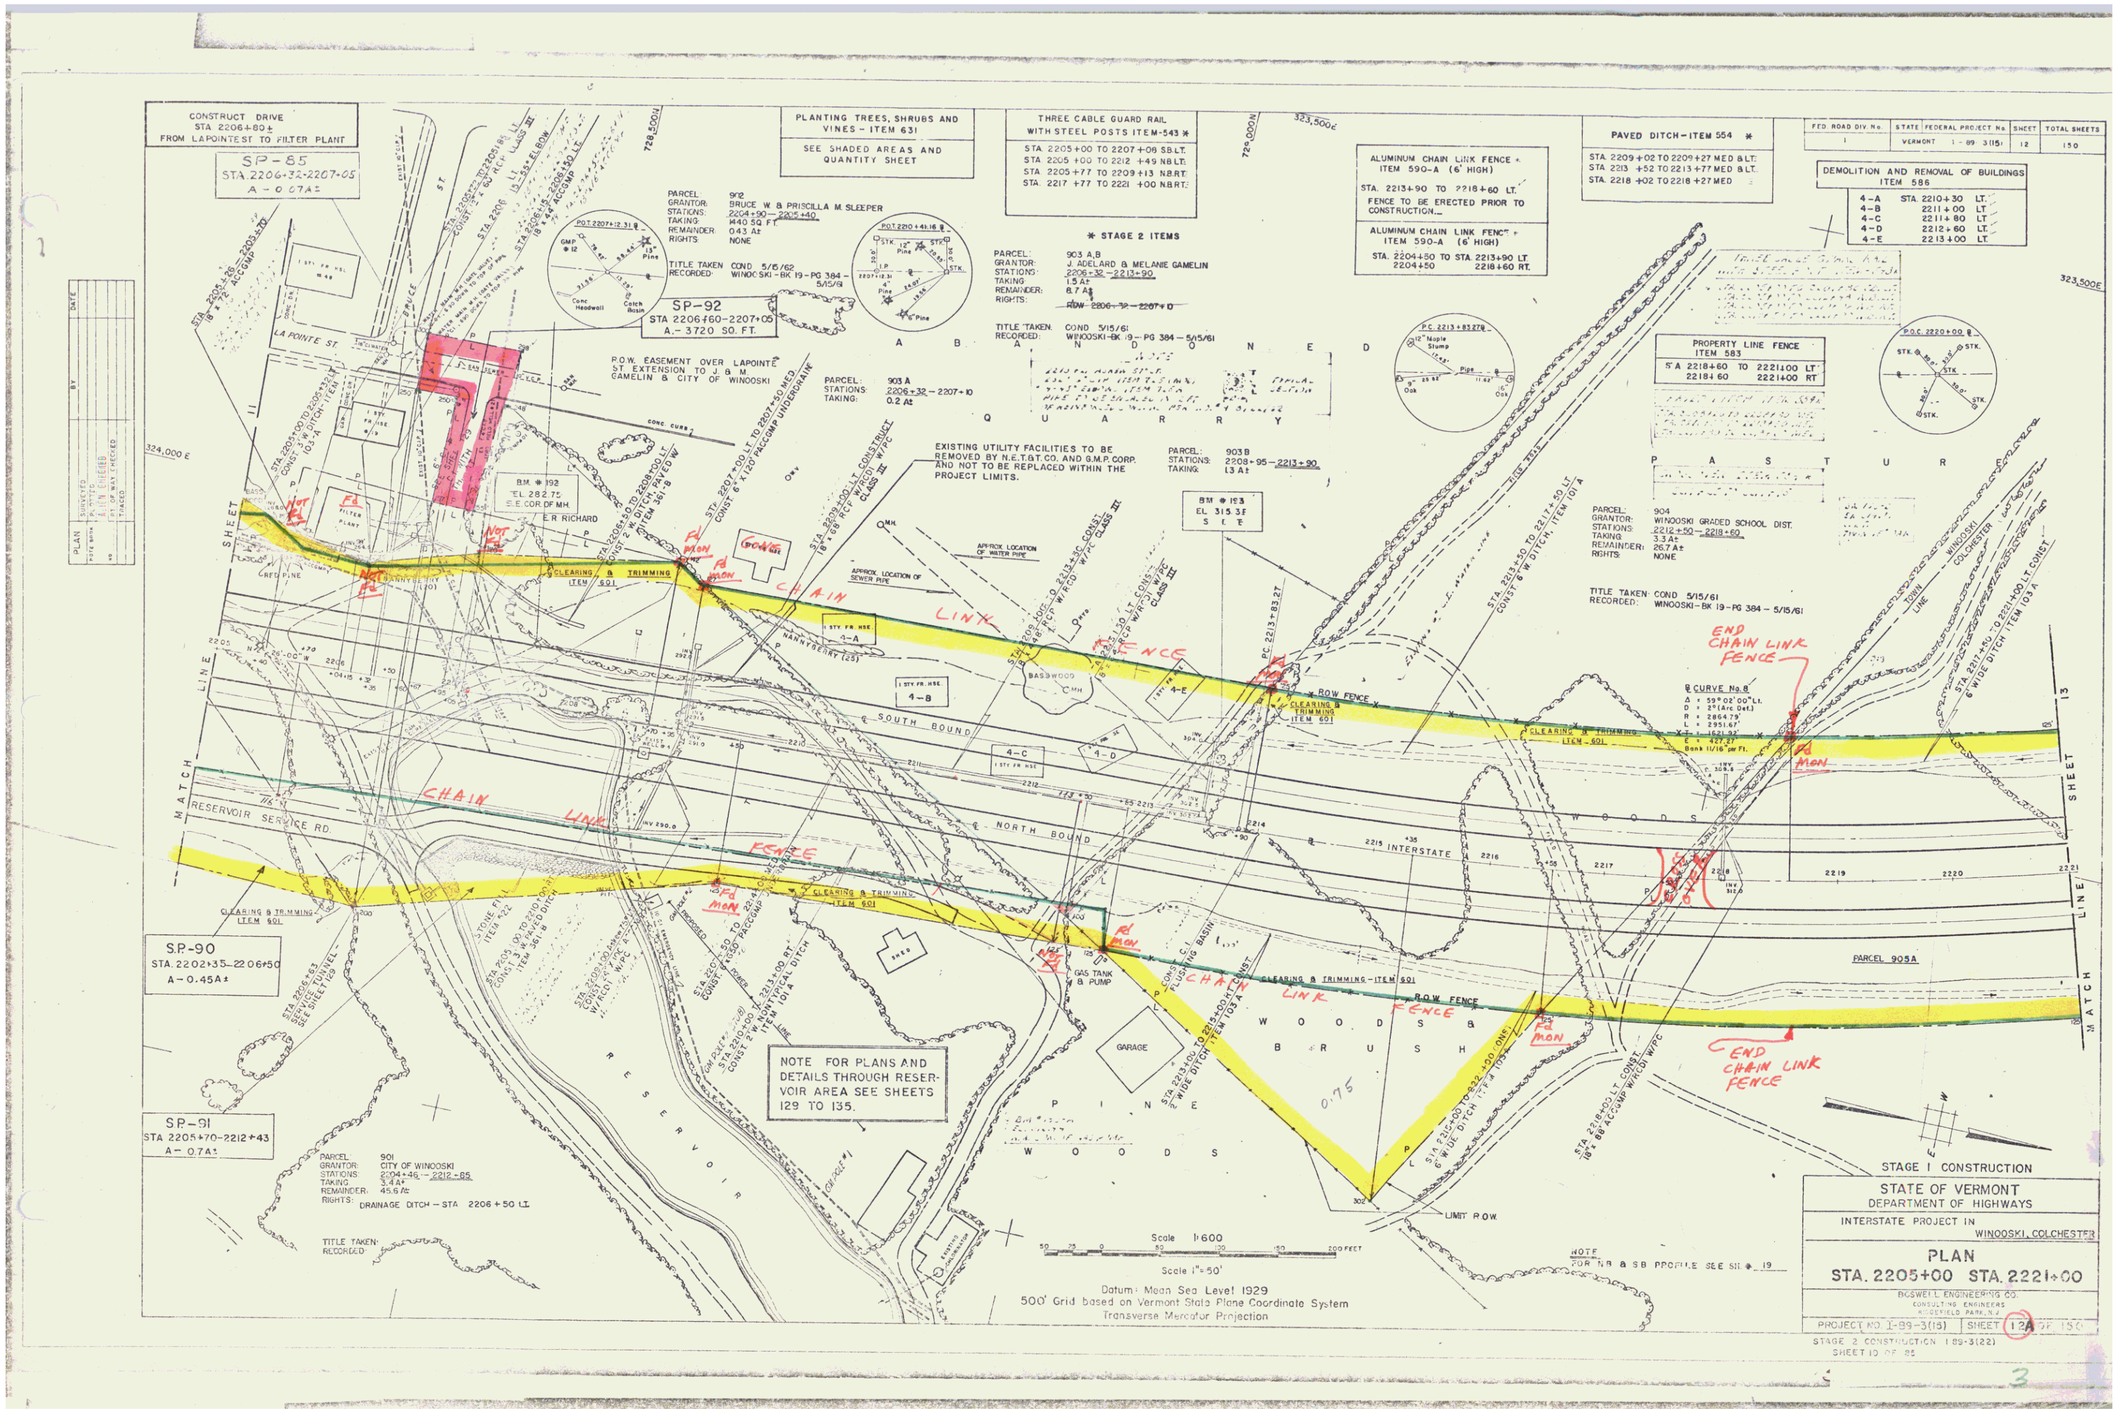

CONSTRUCT DRIVE
STA 2206+80±
FROM LAPOINTE ST TO FILTER PLANT
SP-85
STA. 2206+32-2207+05
A - 0.07A±
PLANTING TREES, SHRUBS AND VINES - ITEM 631
SEE SHADED AREAS AND QUANTITY SHEET
THREE CABLE GUARD RAIL WITH STEEL POSTS ITEM-543 *
STA 2205+00 TO 2207+08 SB LT.
STA 2205+00 TO 2212 +49 NB LT.
STA 2205+77 TO 2209+13 NB RT.
STA 2217 +77 TO 2221 +00 NB RT.
* STAGE 2 ITEMS
ALUMINUM CHAIN LINK FENCE * ITEM 590-A (6' HIGH)
STA. 2213+90 TO 2218+60 LT.
FENCE TO BE ERECTED PRIOR TO CONSTRUCTION.
ALUMINUM CHAIN LINK FENCE * ITEM 590-A (6' HIGH)
STA. 2204+50 TO STA 2213+90 LT.
2204+50 2218+60 RT.
PAVED DITCH - ITEM 554 *
STA 2209+02 TO 2209+27 MED & LT.
STA 2213 +52 TO 2213+77 MED & LT.
STA 2218 +02 TO 2218+27 MED
FED. ROAD DIV. No. 1
STATE VERMONT
FEDERAL PROJECT No. I-89-3(15)
SHEET 12
TOTAL SHEETS 150
DEMOLITION AND REMOVAL OF BUILDINGS ITEM 586
4-A STA 2210+30 LT.
4-B 2211+00 LT.
4-C 2211+80 LT.
4-D 2212+60 LT.
4-E 2213+00 LT.
PROPERTY LINE FENCE ITEM 583
STA 2218+60 TO 2221+00 LT
2218+60 2221+00 RT
SP-92
STA 2206+60-2207+05
A.- 3720 SQ. FT.
PARCEL: 902
GRANTOR: BRUCE W. & PRISCILLA M. SLEEPER
STATIONS: 2204+90 - 2205+40
TAKING: 1440 SQ. FT.
REMAINDER: 0.43 A±
RIGHTS: NONE
TITLE TAKEN: COND 5/15/62
RECORDED: WINOOSKI - BK 19 - PG 384 - 5/15/61
PARCEL: 903 A,B
GRANTOR: J. ADELARD & MELANIE GAMELIN
STATIONS: 2206+32 - 2213+90
TAKING: 1.5 A±
REMAINDER: 8.7 A±
RIGHTS: ROW 2206+32 - 2207+10
TITLE TAKEN: COND 5/15/61
RECORDED: WINOOSKI - BK 19 - PG 384 - 5/15/61
PARCEL: 903 A
STATIONS: 2206+32 - 2207+10
TAKING: 0.2 A±
R.O.W. EASEMENT OVER LAPOINTE ST. EXTENSION TO J. & M. GAMELIN & CITY OF WINOOSKI
EXISTING UTILITY FACILITIES TO BE REMOVED BY N.E.T.&T.CO. AND G.M.P. CORP. AND NOT TO BE REPLACED WITHIN THE PROJECT LIMITS.
PARCEL: 903 B
STATIONS: 2208+95 - 2213+90
TAKING: 1.3 A±
PARCEL: 904
GRANTOR: WINOOSKI GRADED SCHOOL DIST.
STATIONS: 2212+50 - 2218+60
TAKING: 3.3 A±
REMAINDER: 26.7 A±
RIGHTS: NONE
TITLE TAKEN: COND 5/15/61
RECORDED: WINOOSKI - BK 19 - PG 384 - 5/15/61
CHAIN LINK FENCE
END CHAIN LINK FENCE
SOUTH BOUND
NORTH BOUND
INTERSTATE
RESERVOIR SERVICE RD.
LA POINTE ST.
MATCH LINE
SHEET 13
PARCEL 905A
S.P.-90
STA. 2202+35 - 2206+50
A - 0.45A±
S.P.-91
STA 2205+70 - 2212+43
A - 0.7A±
PARCEL: 901
GRANTOR: CITY OF WINOOSKI
STATIONS: 2204+46 - 2212+85
TAKING: 3.4 A±
REMAINDER: 45.6 A±
RIGHTS: DRAINAGE DITCH - STA 2206+50 LT.
TITLE TAKEN:
RECORDED:
NOTE FOR PLANS AND DETAILS THROUGH RESERVOIR AREA SEE SHEETS 129 TO 135.
GAS TANK & PUMP
GARAGE
WOODS & BRUSH
PINE WOODS
RESERVOIR
LIMIT R.O.W.
Scale 1:600
Scale 1"=50'
Datum: Mean Sea Level 1929
500' Grid based on Vermont State Plane Coordinate System
Transverse Mercator Projection
NOTE FOR NB & SB PROFILE SEE SH. # 19
STAGE I CONSTRUCTION
STATE OF VERMONT
DEPARTMENT OF HIGHWAYS
INTERSTATE PROJECT IN WINOOSKI, COLCHESTER
PLAN
STA. 2205+00 STA. 2221+00
BOSWELL ENGINEERING CO.
CONSULTING ENGINEERS
RIDGEFIELD PARK, N.J.
PROJECT NO. I-89-3(15)
SHEET 12A OF 150
STAGE 2 CONSTRUCTION I-89-3(22)
SHEET 10 OF 85

3