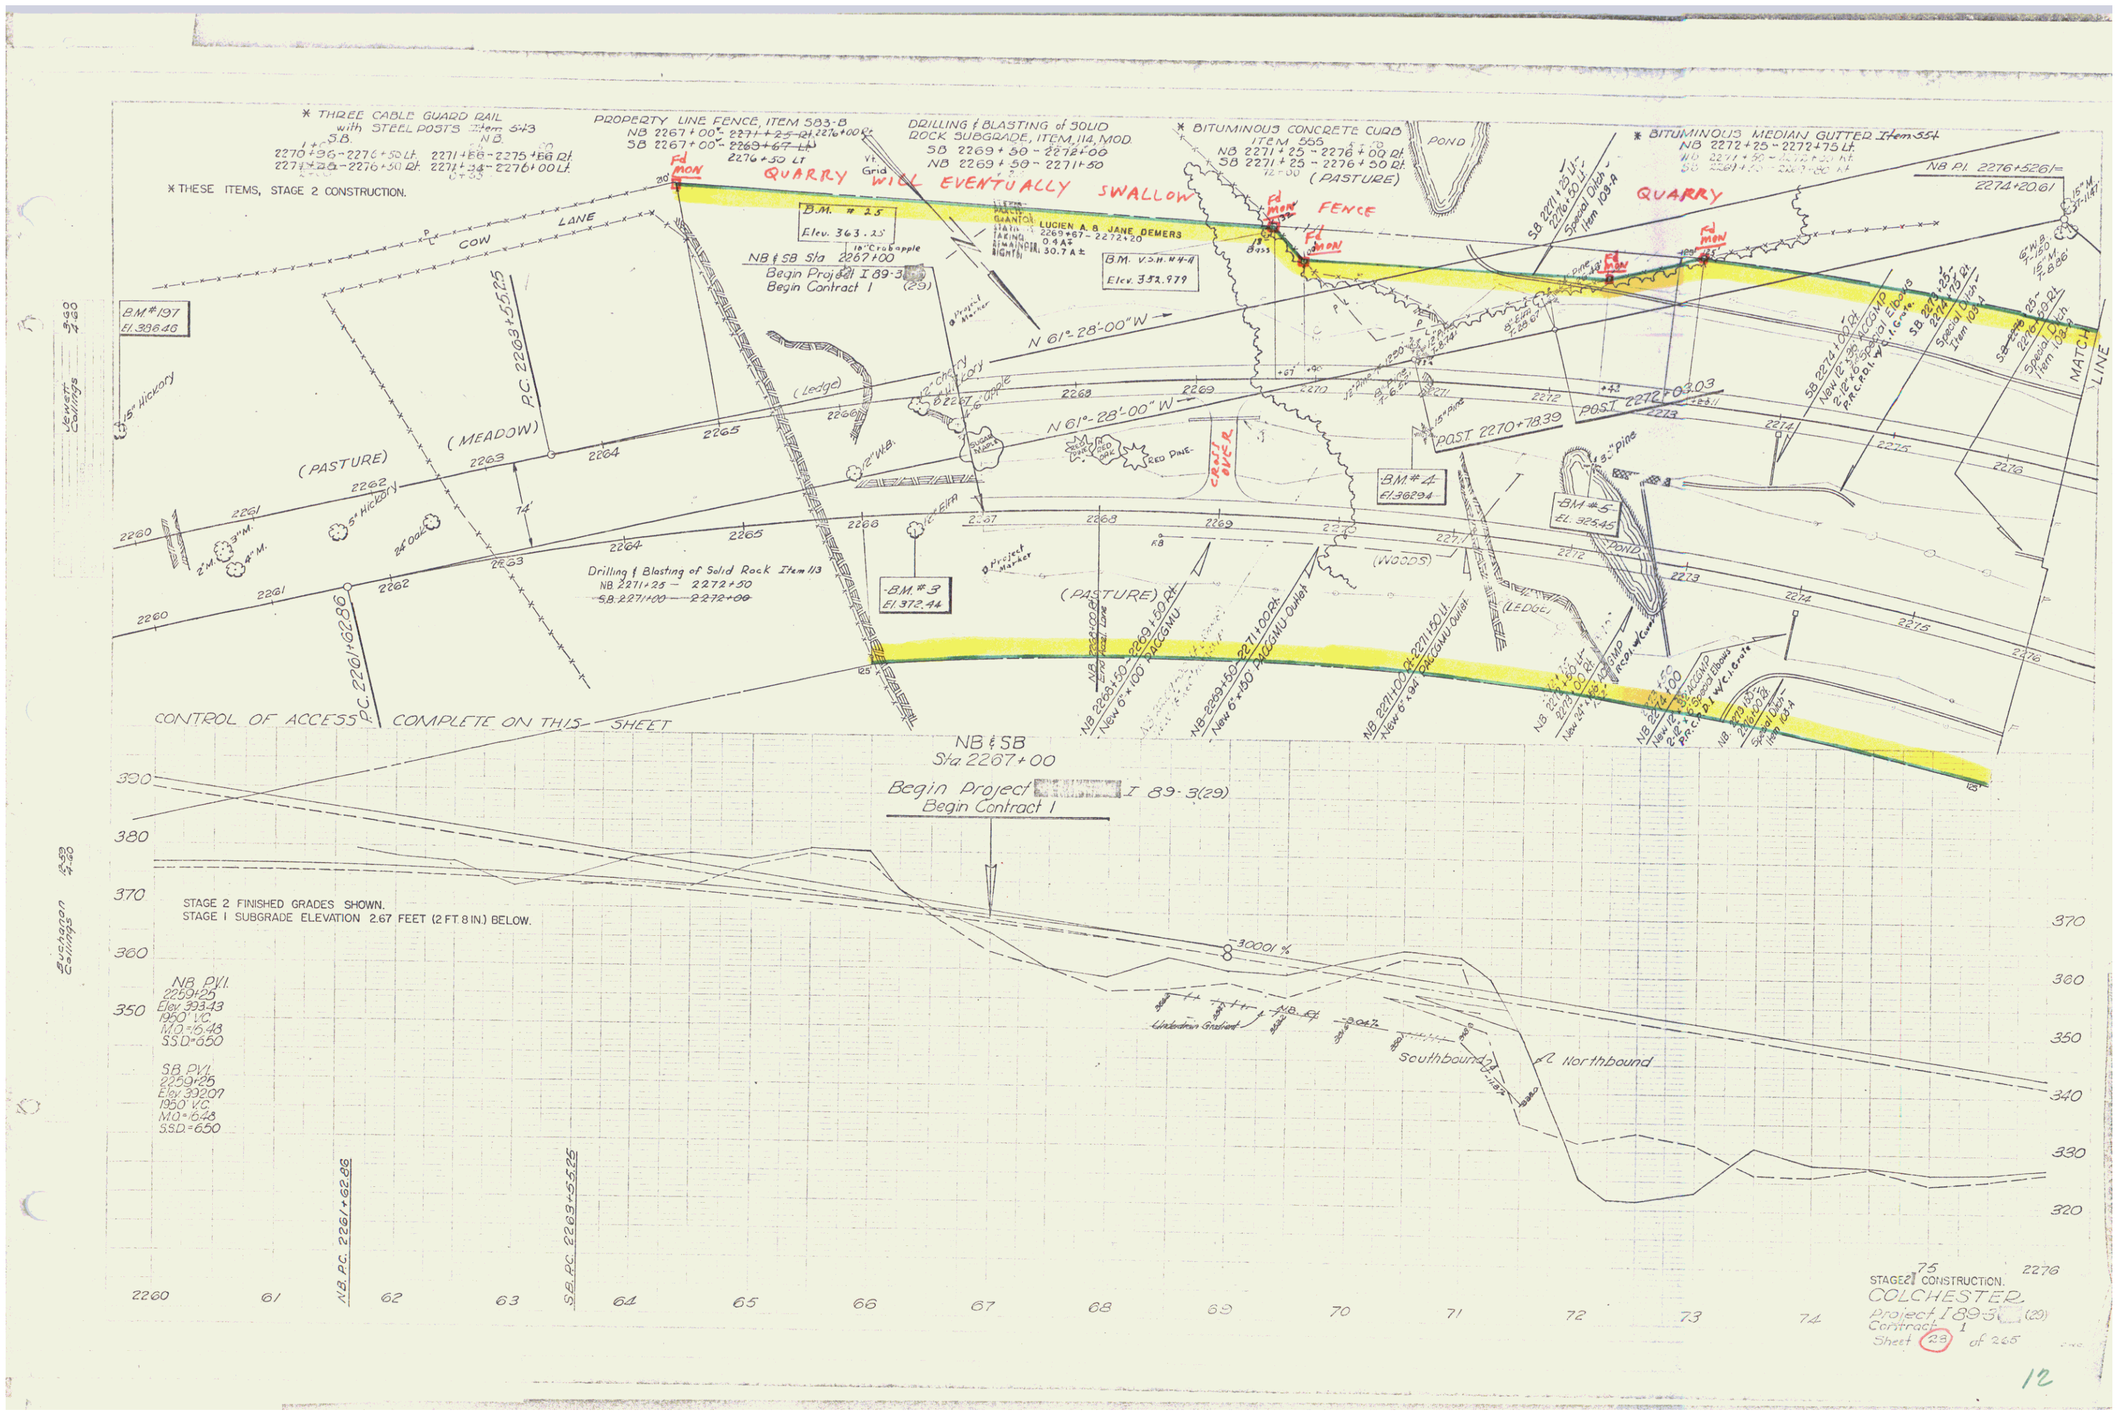
* THREE CABLE GUARD RAIL with STEEL POSTS Item 543
S.B.
2270+36 - 2276+50 Lt.
2271+26 - 2276+50 Rt.
N.B.
2271+66 - 2275+66 Rt.
2271+34 - 2276+00 Lt.
* THESE ITEMS, STAGE 2 CONSTRUCTION.
PROPERTY LINE FENCE, ITEM 583-B
NB 2267+00 - 2271+25 Rt. 2276+00 Rt.
SB 2267+00 - 2269+67 Lt.
2276+50 Lt.
DRILLING & BLASTING of SOLID ROCK SUBGRADE, ITEM 114, MOD.
SB 2269+50 - 2272+00
NB 2269+50 - 2271+50
* BITUMINOUS CONCRETE CURB ITEM 555
NB 2271+25 - 2276+00 Rt.
SB 2271+25 - 2276+50 Lt.
(PASTURE)
* BITUMINOUS MEDIAN GUTTER Item 554
NB 2272+25 - 2272+75 Lt.
QUARRY WILL EVENTUALLY SWALLOW FENCE
QUARRY
POND
COW LANE
B.M. # 25
Elev. 363.25
GRANTOR: LUCIEN A. & JANE DEMERS
STATION: 2269+67 - 2272+20
TAKING: 0.9 AS
REMAINDER: 30.7 A ±
RIGHT
B.M. V.S.H. # 4-A
Elev. 352.979
NB & SB Sta 2267+00
Begin Project I 89-3(29)
Begin Contract 1
B.M. # 197
P.C. 2263+55.25
N 61°-28'-00" W
(Ledge)
(MEADOW)
(PASTURE)
74'
POST 2270+78.39
POST 2272+03.03
RED OAK
RED PINE
B.M. # 4
El. 362.94
B.M. # 5
El. 324.45
(WOODS)
(LEDGE)
B.M. # 3
El. 372.44
Drilling & Blasting of Solid Rock Item 113
NB 2271+25 - 2272+50
SB 2271+00 - 2272+00
P.C. 2261+62.86
CONTROL OF ACCESS COMPLETE ON THIS SHEET
NB & SB
Sta 2267+00
Begin Project I 89-3(29)
Begin Contract 1
MATCH LINE
NB P.I. 2276+52.61 = 2274+20.61
NB P.V.I.
2259+25
1950' V.C.
M.O.=6.48
S.S.D.=650
SB P.V.I.
2259+25
1950 V.C.
M.O.=6.48
S.S.D.=650
-3.0001 %
Underdrain Gradient
Southbound
℄ Northbound
NB P.C. 2261+62.86
SB P.C. 2263+55.25
STAGE 2 FINISHED GRADES SHOWN.
STAGE 1 SUBGRADE ELEVATION 2.67 FEET (2 FT 8 IN.) BELOW.
STAGE 2 CONSTRUCTION.
COLCHESTER
Project I 89-3(29)
Contract 1
Sheet 23 of 265

12