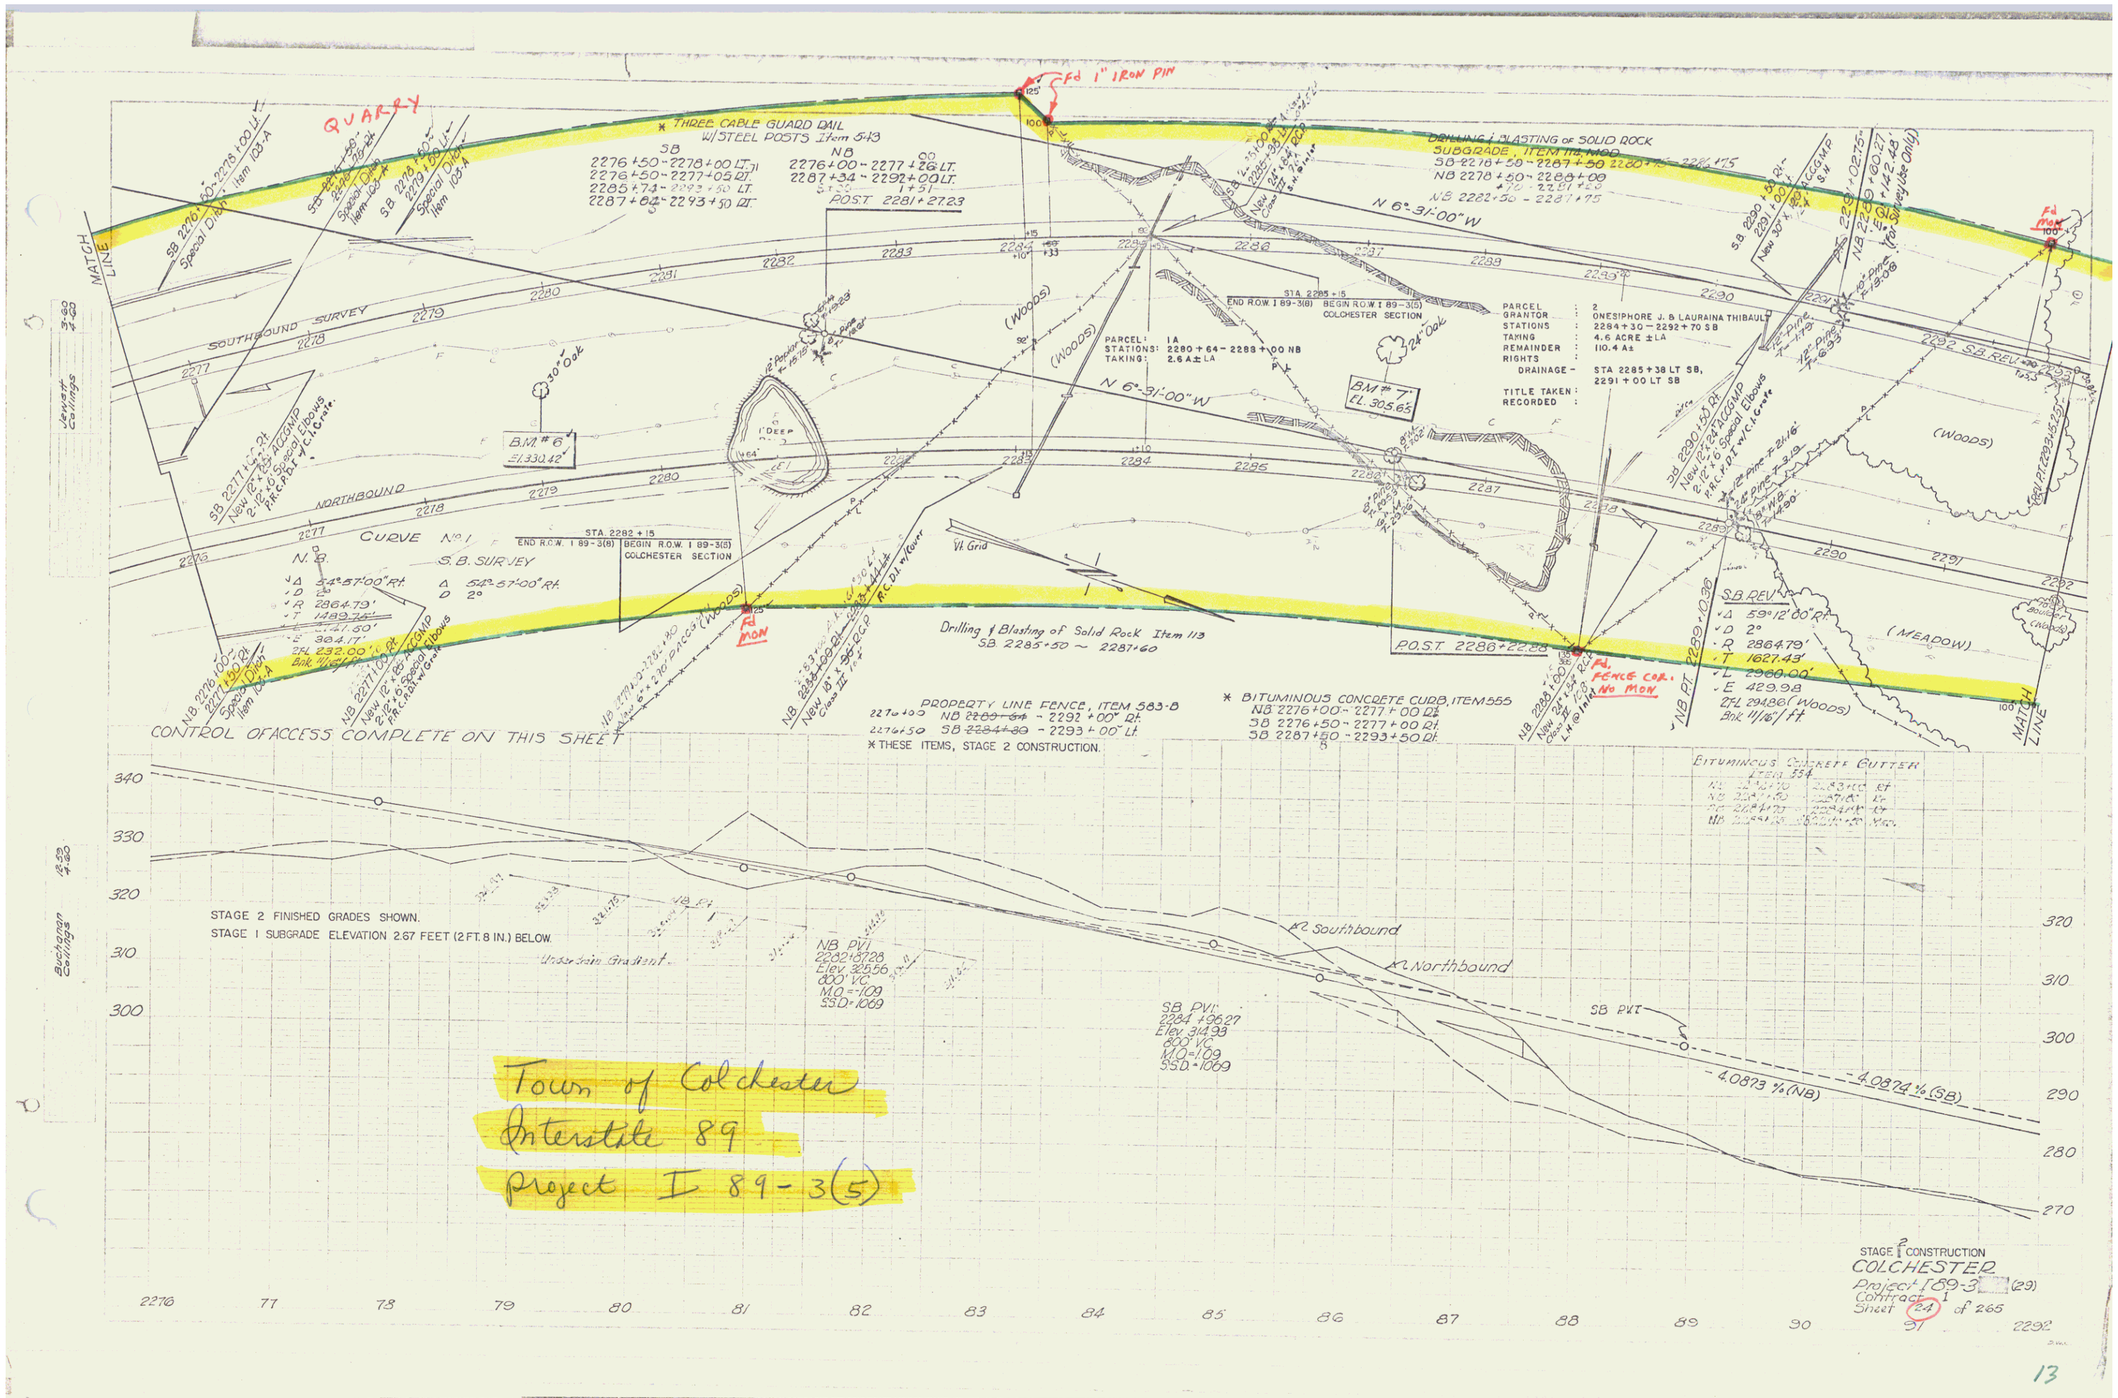

Town of Colchester
Interstate 89
Project I 89-3(5)

13