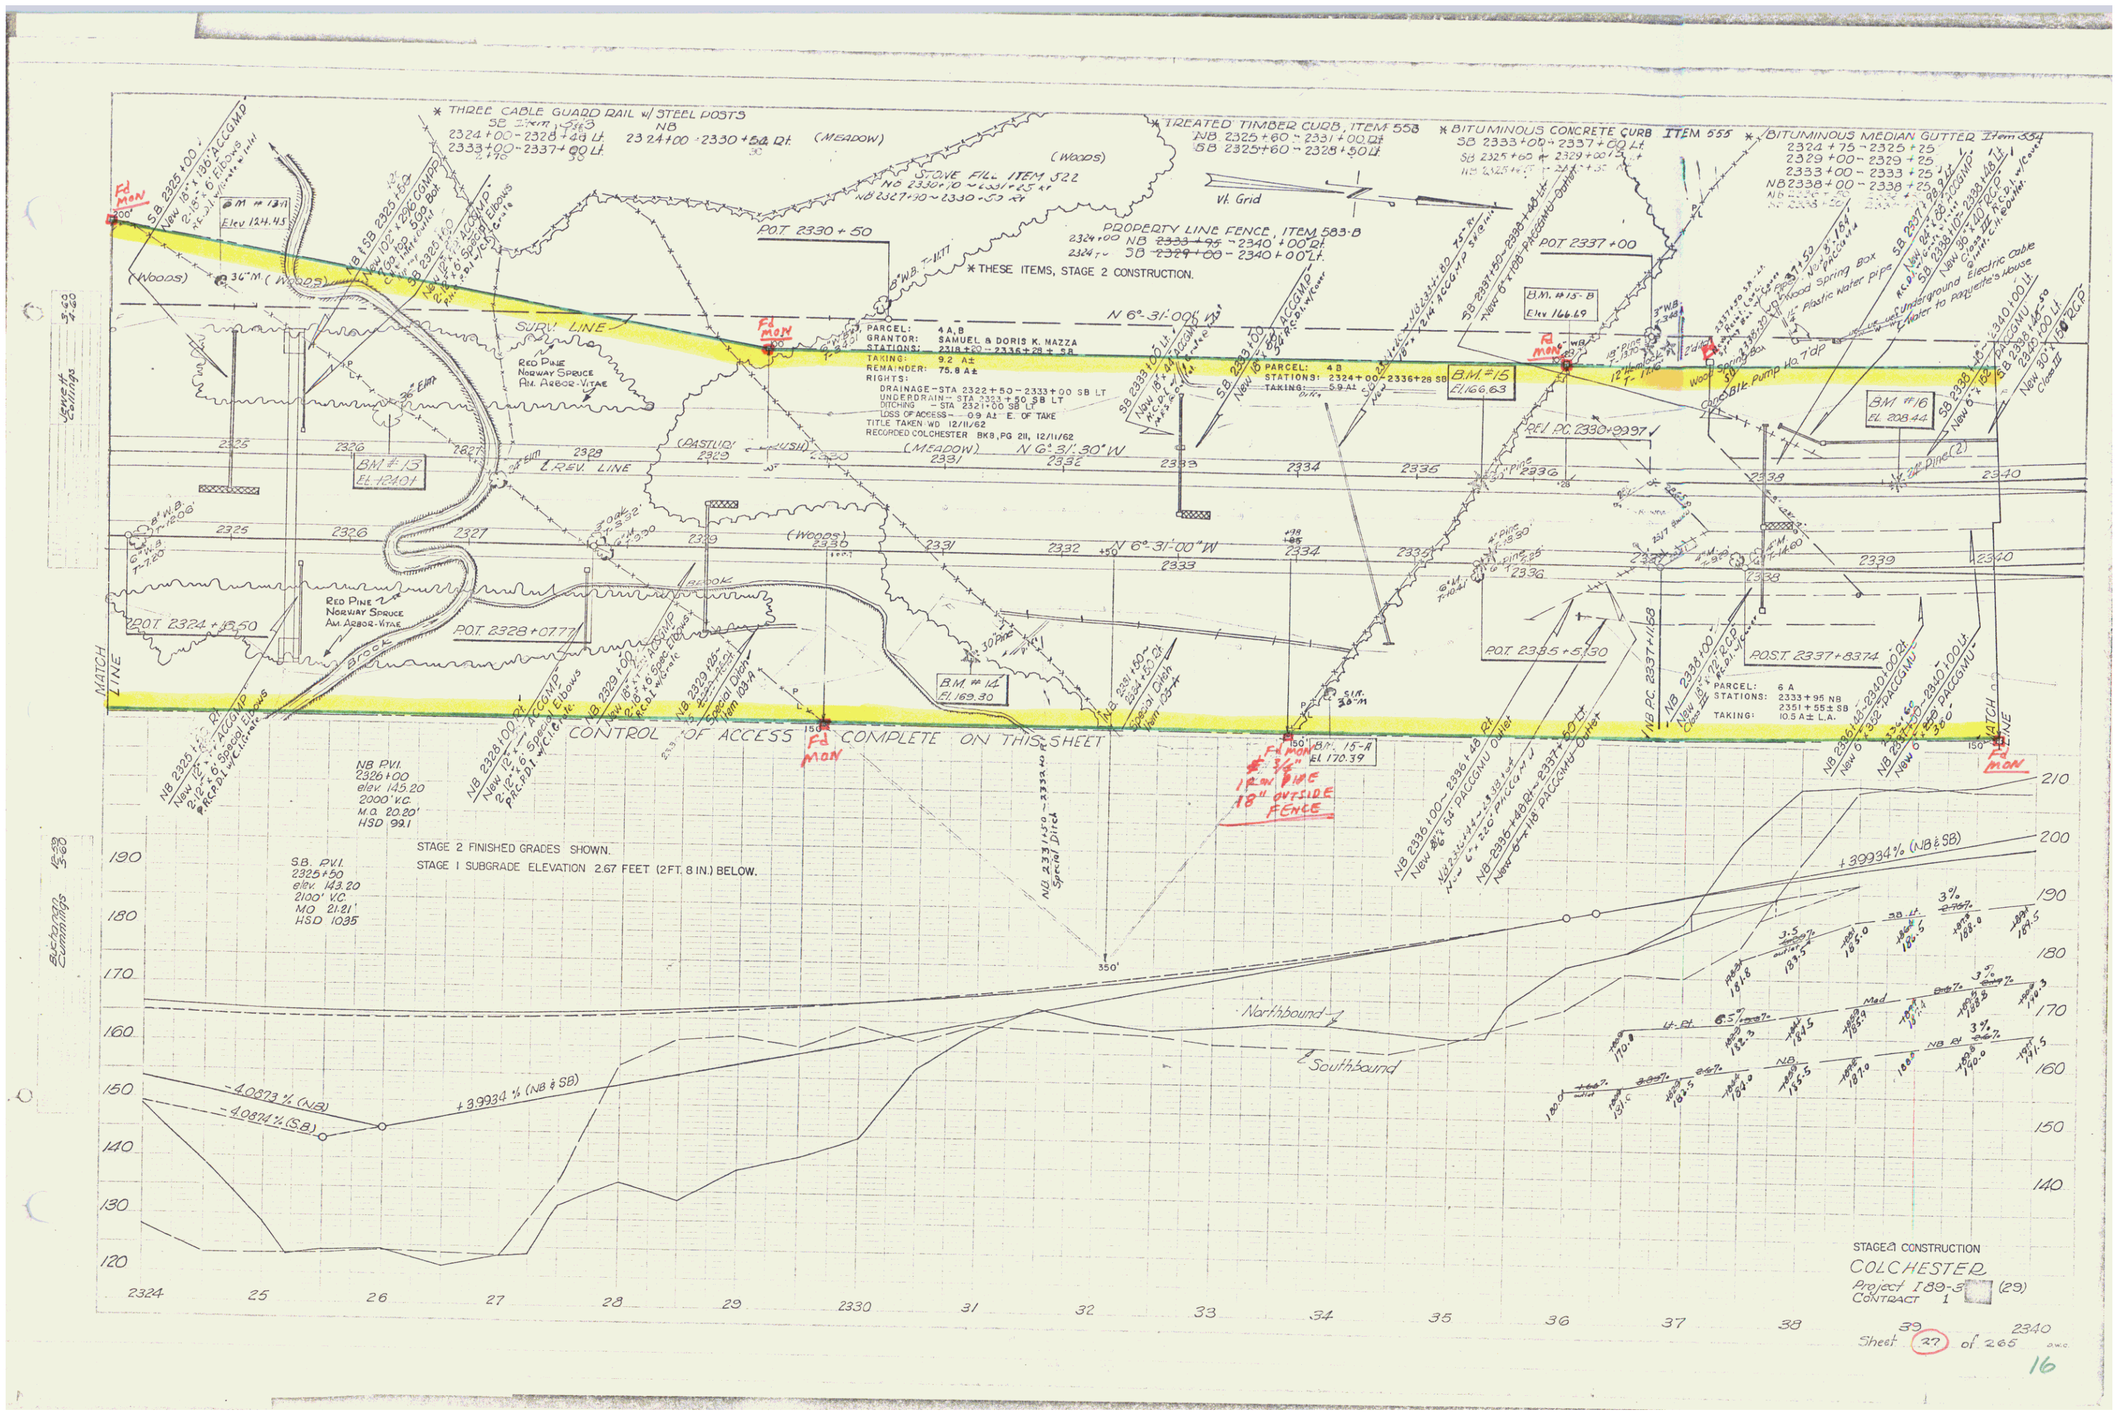
* THREE CABLE GUARD RAIL w/ STEEL POSTS
SB 2324+00 - 2328+48 Lt.
NB 2324+00 - 2330+54 Rt.
2333+00 - 2337+00 Lt.
(MEADOW)
(Woods)
* TREATED TIMBER CURB, ITEM 558
NB 2325+60 - 2331+00 Rt.
SB 2325+60 - 2328+50 Lt.
* BITUMINOUS CONCRETE CURB ITEM 555
SB 2333+00 - 2337+00 Lt.
* BITUMINOUS MEDIAN GUTTER Item 554
2324+75 - 2325+25
2329+00 - 2329+25
2333+00 - 2333+25
NB 2338+00 - 2338+25
STONE FILL ITEM 522
NB 2330+10 - 2331+45 Rt
NB 2327+10 - 2330+50 Rt
Vl. Grid
PROPERTY LINE FENCE, ITEM 583-B
2324+00 NB ~~2333+95~~ - 2340+00 Rt.
2324+00 SB ~~2329+00~~ - 2340+00 Lt.
* THESE ITEMS, STAGE 2 CONSTRUCTION.
P.O.T. 2330+50
P.O.T. 2337+00
PARCEL: 4 A,B
GRANTOR: SAMUEL & DORIS K. MAZZA
STATIONS: 2318+29 - 2336+28 ± SB
TAKING: 9.2 A±
REMAINDER: 75.8 A±
RIGHTS:
DRAINAGE - STA 2322+50 - 2333+00 SB LT
UNDERDRAIN - STA 2333+80 SB LT
DITCHING - STA 2321+00 SB LT
LOSS OF ACCESS - .09 A± E. OF TAKE
TITLE TAKEN WD 12/11/62
RECORDED COLCHESTER BK8, PG 211, 12/11/62
PARCEL: 4B
STATIONS: 2324+00 - 2336+28 SB
TAKING: 5.9 A±
N 6° 31' 00" E
N 6° 31' 00" W
N 6° 31' 30" W
SURV. LINE
L.REV. LINE
REV. P.C. 2330+29.97
B.M. #13 Elev 124.45
B.M. #13 EL 124.01
B.M. #14 EL 169.30
B.M. #15 EL 166.63
B.M. #15-B Elev 166.49
B.M. #16 EL 208.44
B.M. #15-A EL 170.39
Red Pine
Norway Spruce
Am. Arbor-Vitae
Brook
Wood Spring Box
Plastic Water Pipe
Underground Electric Cable
Concrete Pump No. 7 DP
Fd MON
MATCH LINE
CONTROL OF ACCESS COMPLETE ON THIS SHEET
P.O.T. 2324+18.50
P.O.T. 2328+07.77
P.O.T. 2335+51.30
P.O.T. 2337+11.58
P.O.T. 2337+83.74
N.B. P.V.I. 2326+00 elev. 145.20 2000' V.C. M.O. 20.20' HSD 99.1
S.B. P.V.I. 2325+50 elev. 143.20 2100' V.C. MO 21.21' HSD 1095
STAGE 2 FINISHED GRADES SHOWN.
STAGE 1 SUBGRADE ELEVATION 2.67 FEET (2 FT. 8 IN.) BELOW.
PARCEL: 6 A
STATIONS: 2333+95 NB
2351+55 ± SB
TAKING: 10.5 A± L.A.
Iron Pipe 18" OUTSIDE FENCE
+3.9934% (NB & SB)
-4.0873% (NB)
-4.0874% (SB)
Northbound
Southbound
STAGE 2 CONSTRUCTION
COLCHESTER
Project I 89-5 (29)
CONTRACT 1
Sheet 27 of 265

16