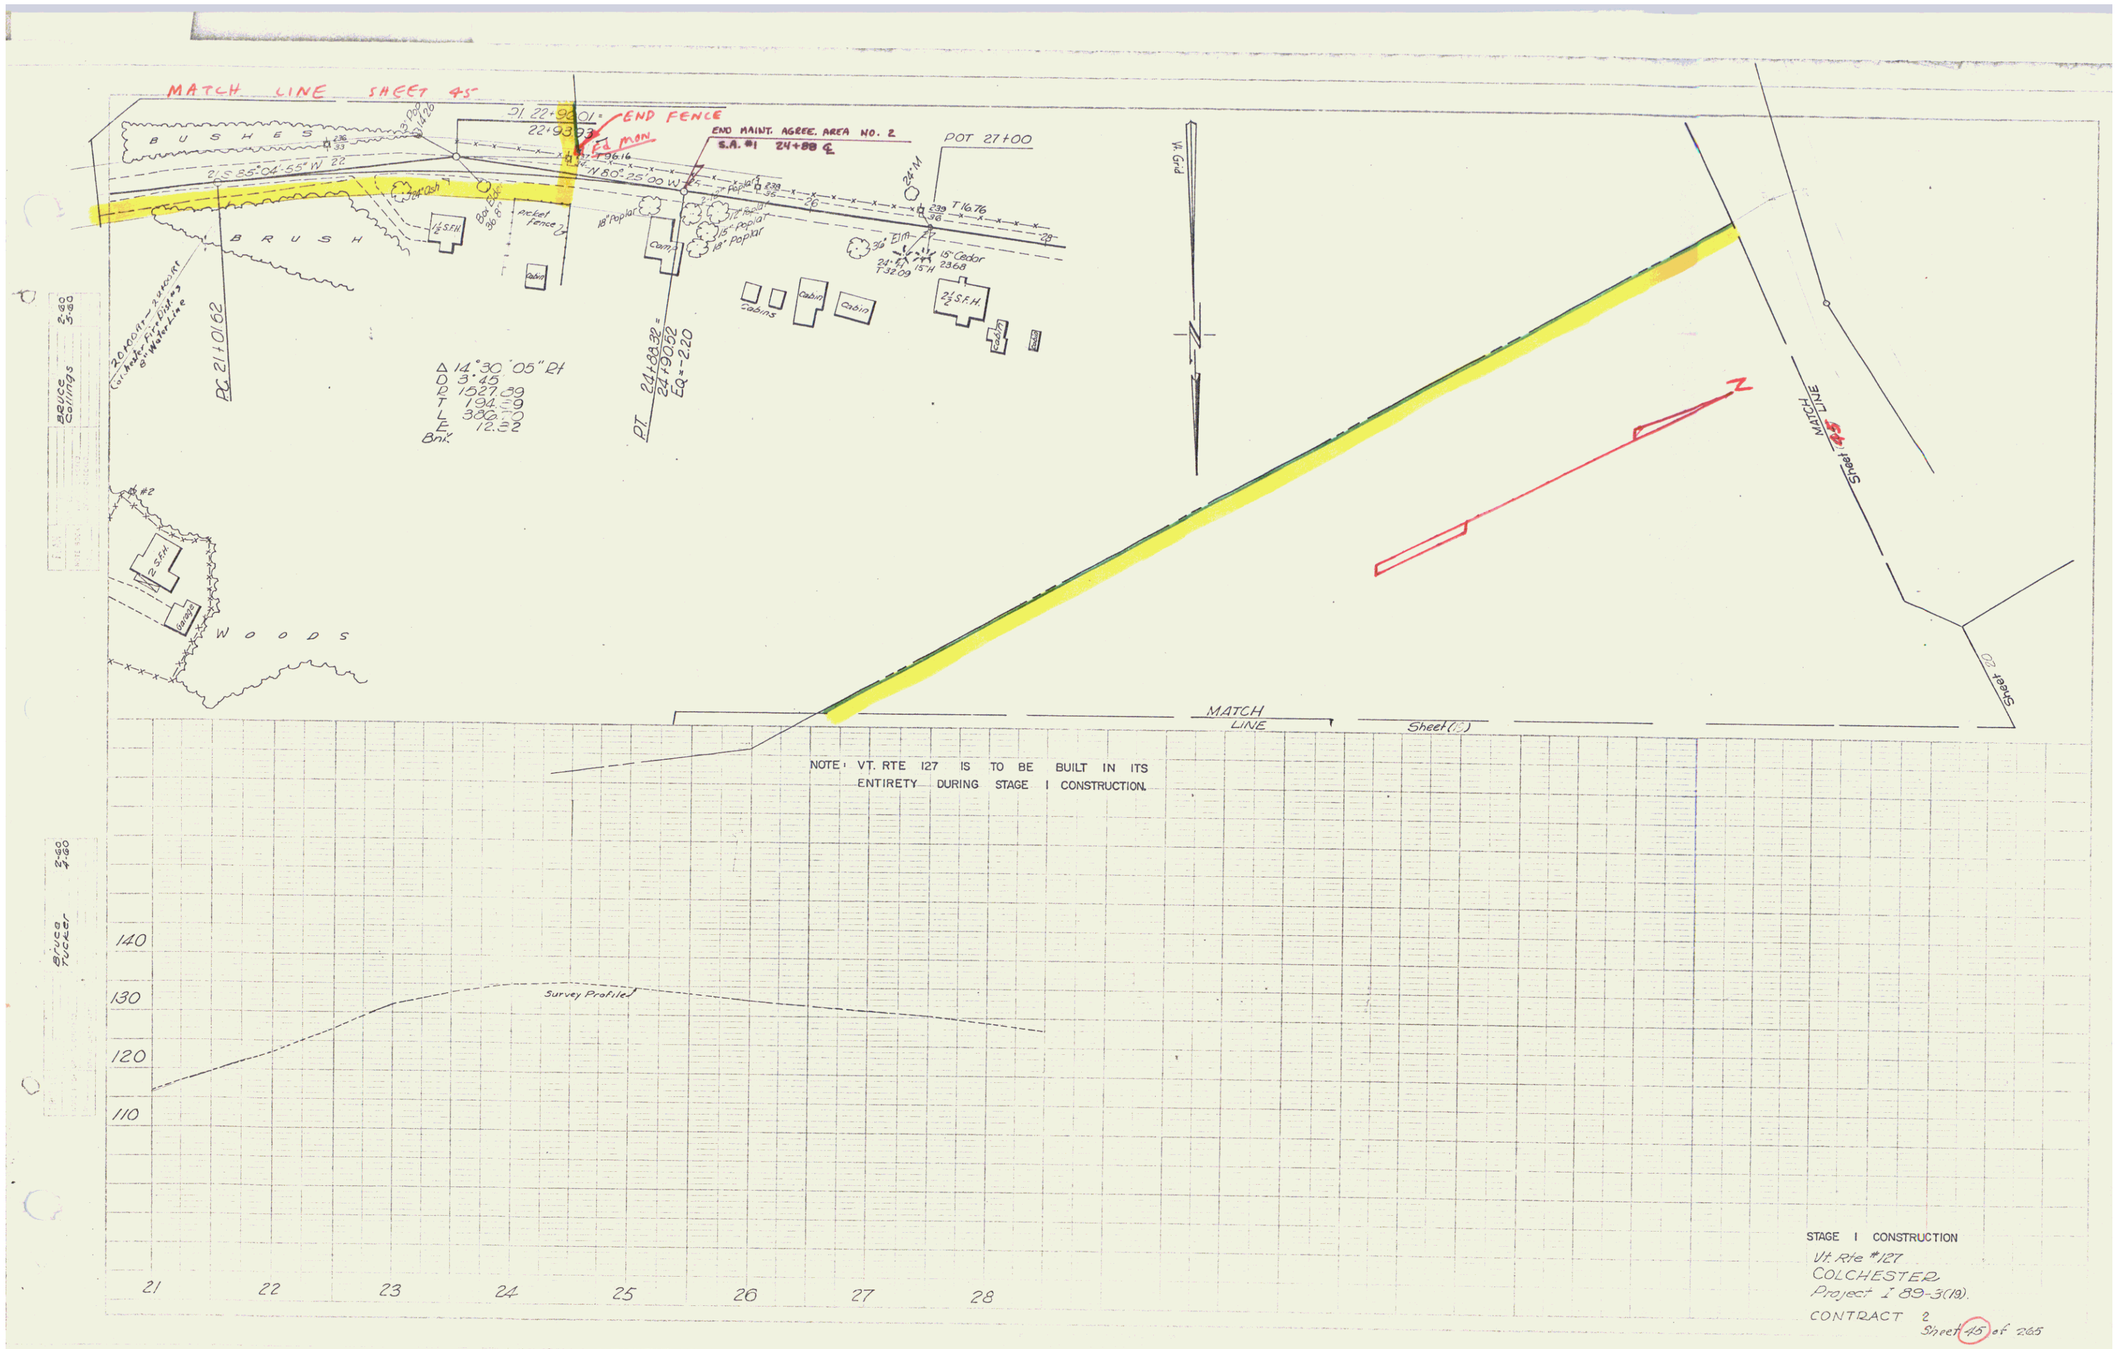
MATCH LINE SHEET 45
BUSHES
BRUSH
WOODS
END FENCE
END MAINT. AGREE. AREA NO. 2
S.A. #1 24+88 ℄
POT 27+00
Picket Fence
18" Poplar
Camp
Cabins
Cabin
15" Cedar
Barn
Garage
Δ 14°30'05" Rt
D 3°45'
R 1527.39
T 194.59
L 386.30
E 12.32
Bnx.
PC 21+01.62
PT 24+88.32
Eq. +2.20
MATCH LINE
Sheet 46
Sheet 20
NOTE: VT. RTE 127 IS TO BE BUILT IN ITS ENTIRETY DURING STAGE I CONSTRUCTION.
Survey Profile
140
130
120
110
21
22
23
24
25
26
27
28
STAGE I CONSTRUCTION
Vt. Rte #127
COLCHESTER
Project I 89-3(19)
CONTRACT 2
Sheet 45 of 265

29