


PLAN
 DATE: 7-29-74
 SHEET NO. 24 OF 236
 PROJECT: COLCHESTER

PLAN
 DATE: 7-29-74
 SHEET NO. 24 OF 236
 PROJECT: COLCHESTER

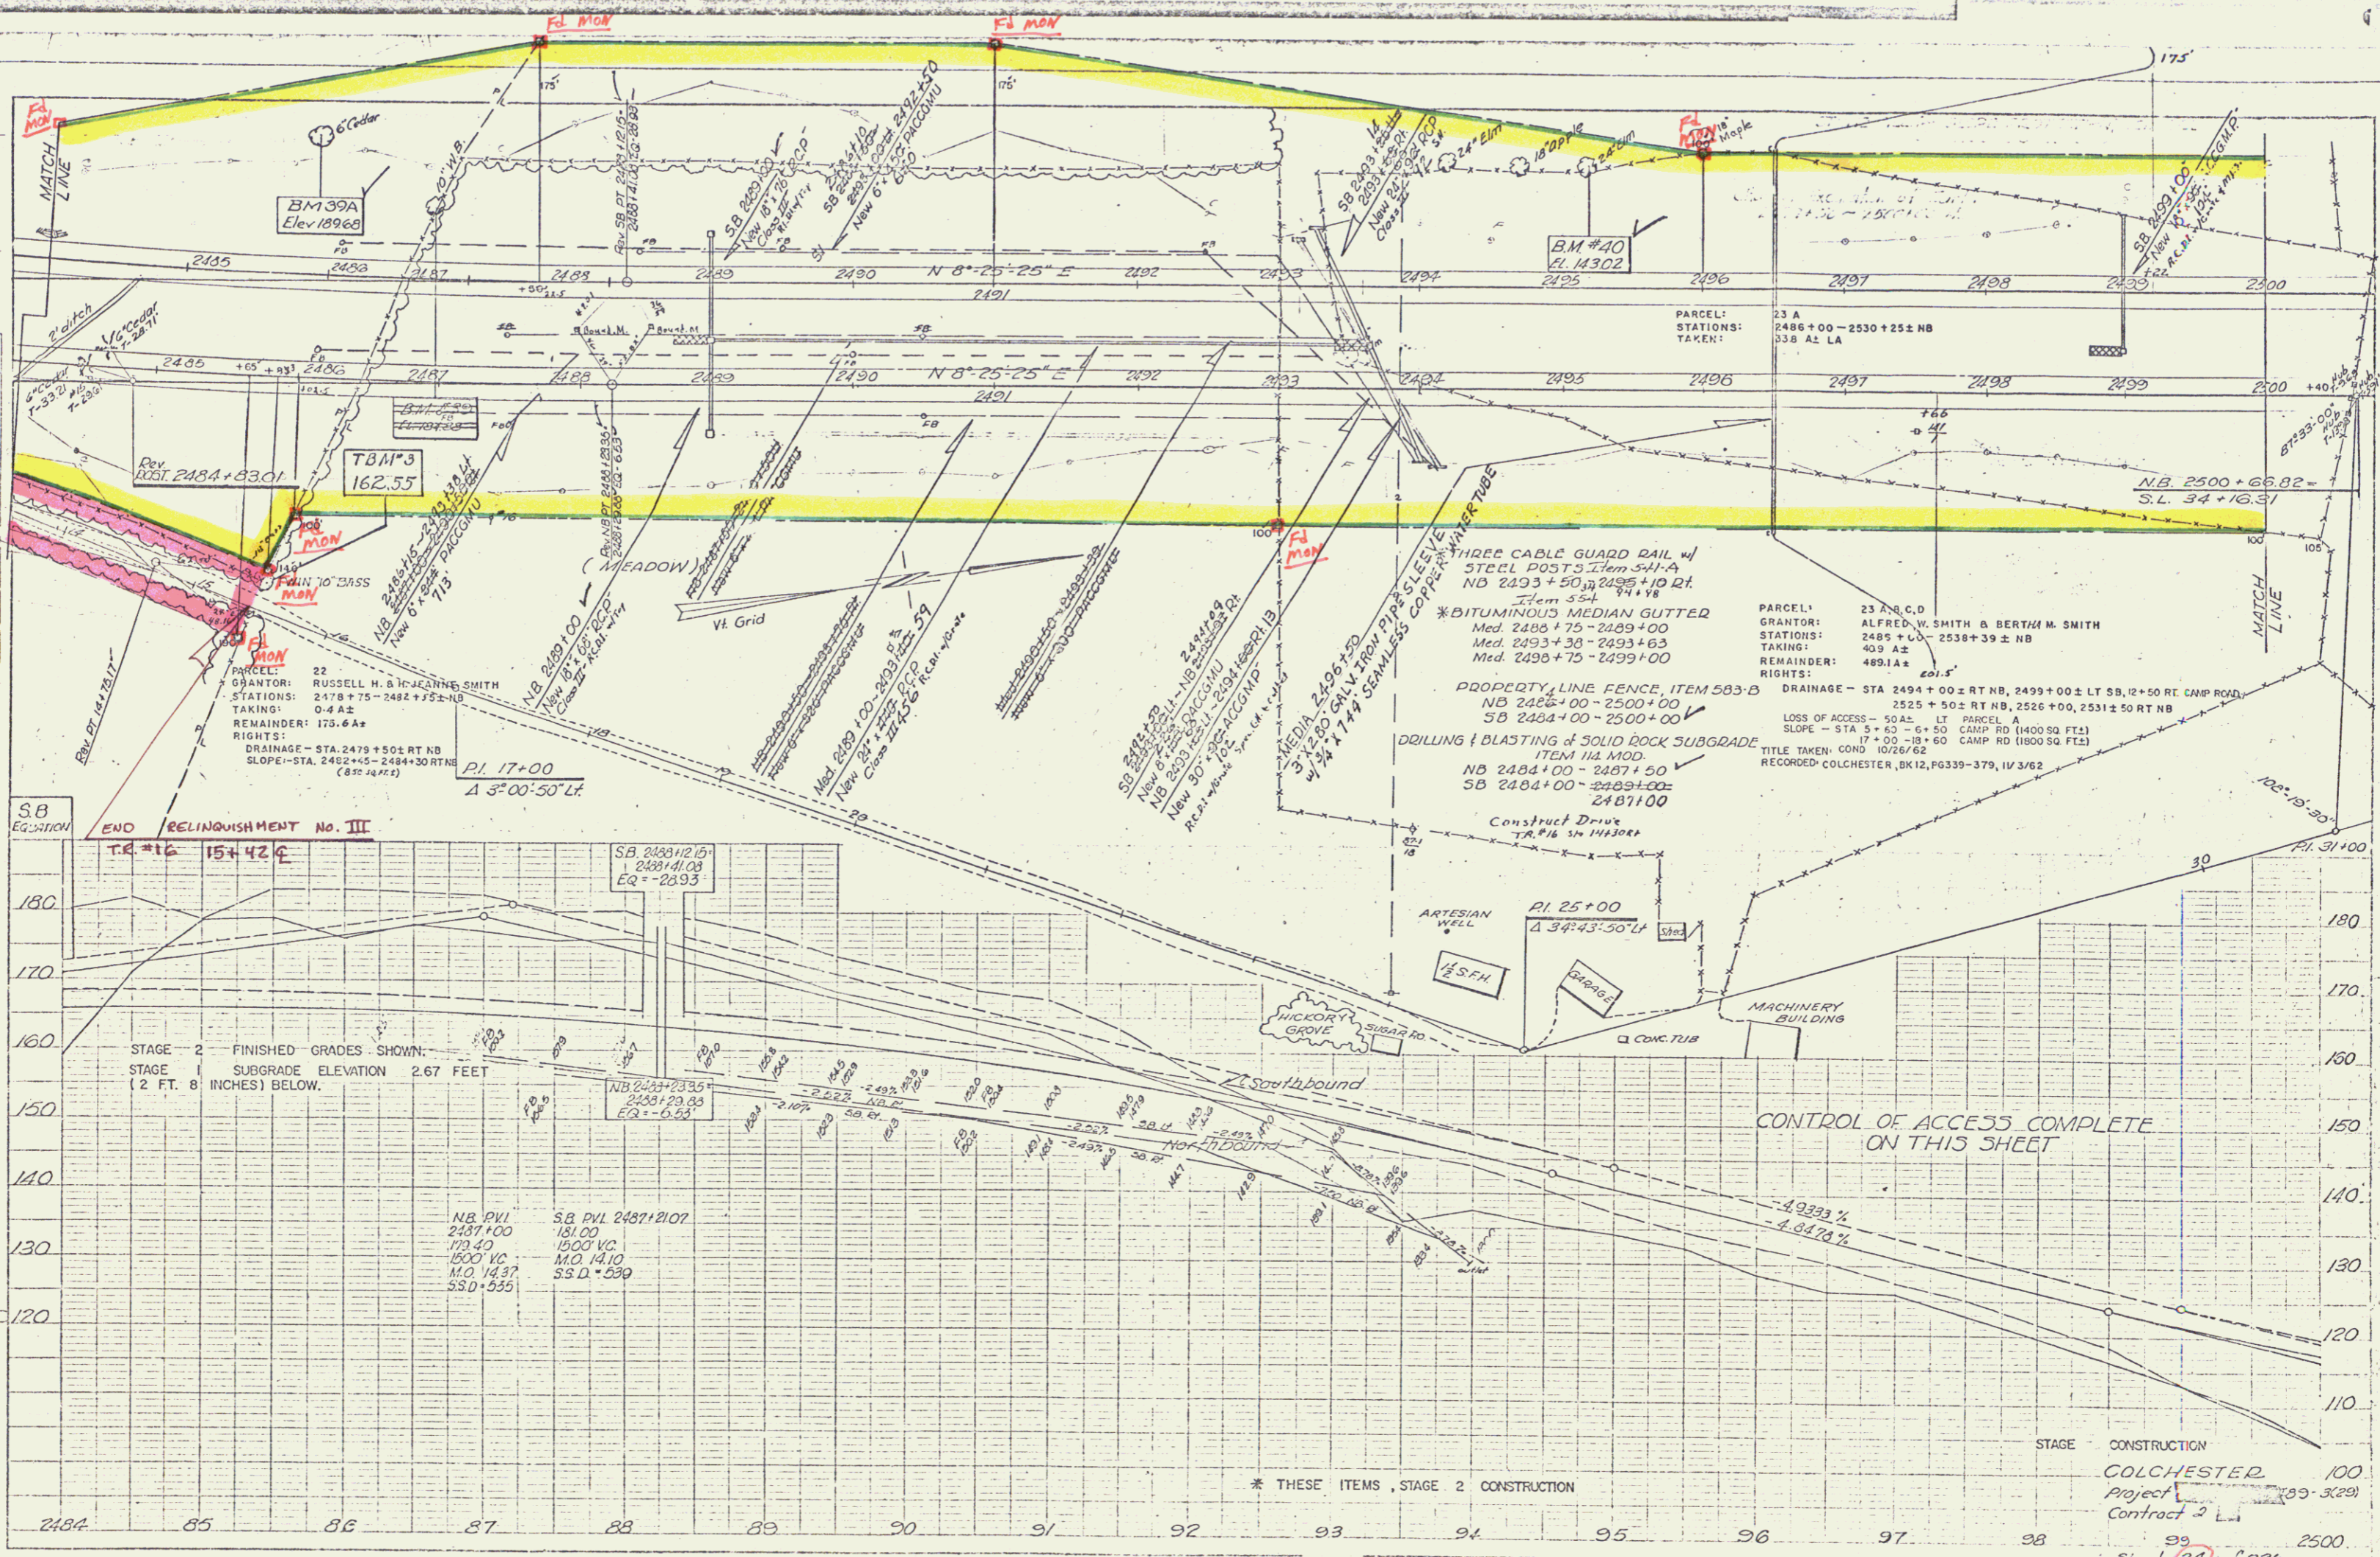

END RELINQUISHMENT No. III
 TR #16 15+42.4

STAGE 2 FINISHED GRADES SHOWN
 SUBGRADE ELEVATION 2.67 FEET
 (2 FT. 8 INCHES) BELOW

CONTROL OF ACCESS COMPLETE
 ON THIS SHEET

* THESE ITEMS, STAGE 2 CONSTRUCTION

STAGE CONSTRUCTION
 COLCHESTER
 Project 89-3(25)
 Contract 2 L

Sheet 24 of 236
 AUG 7 1974

4