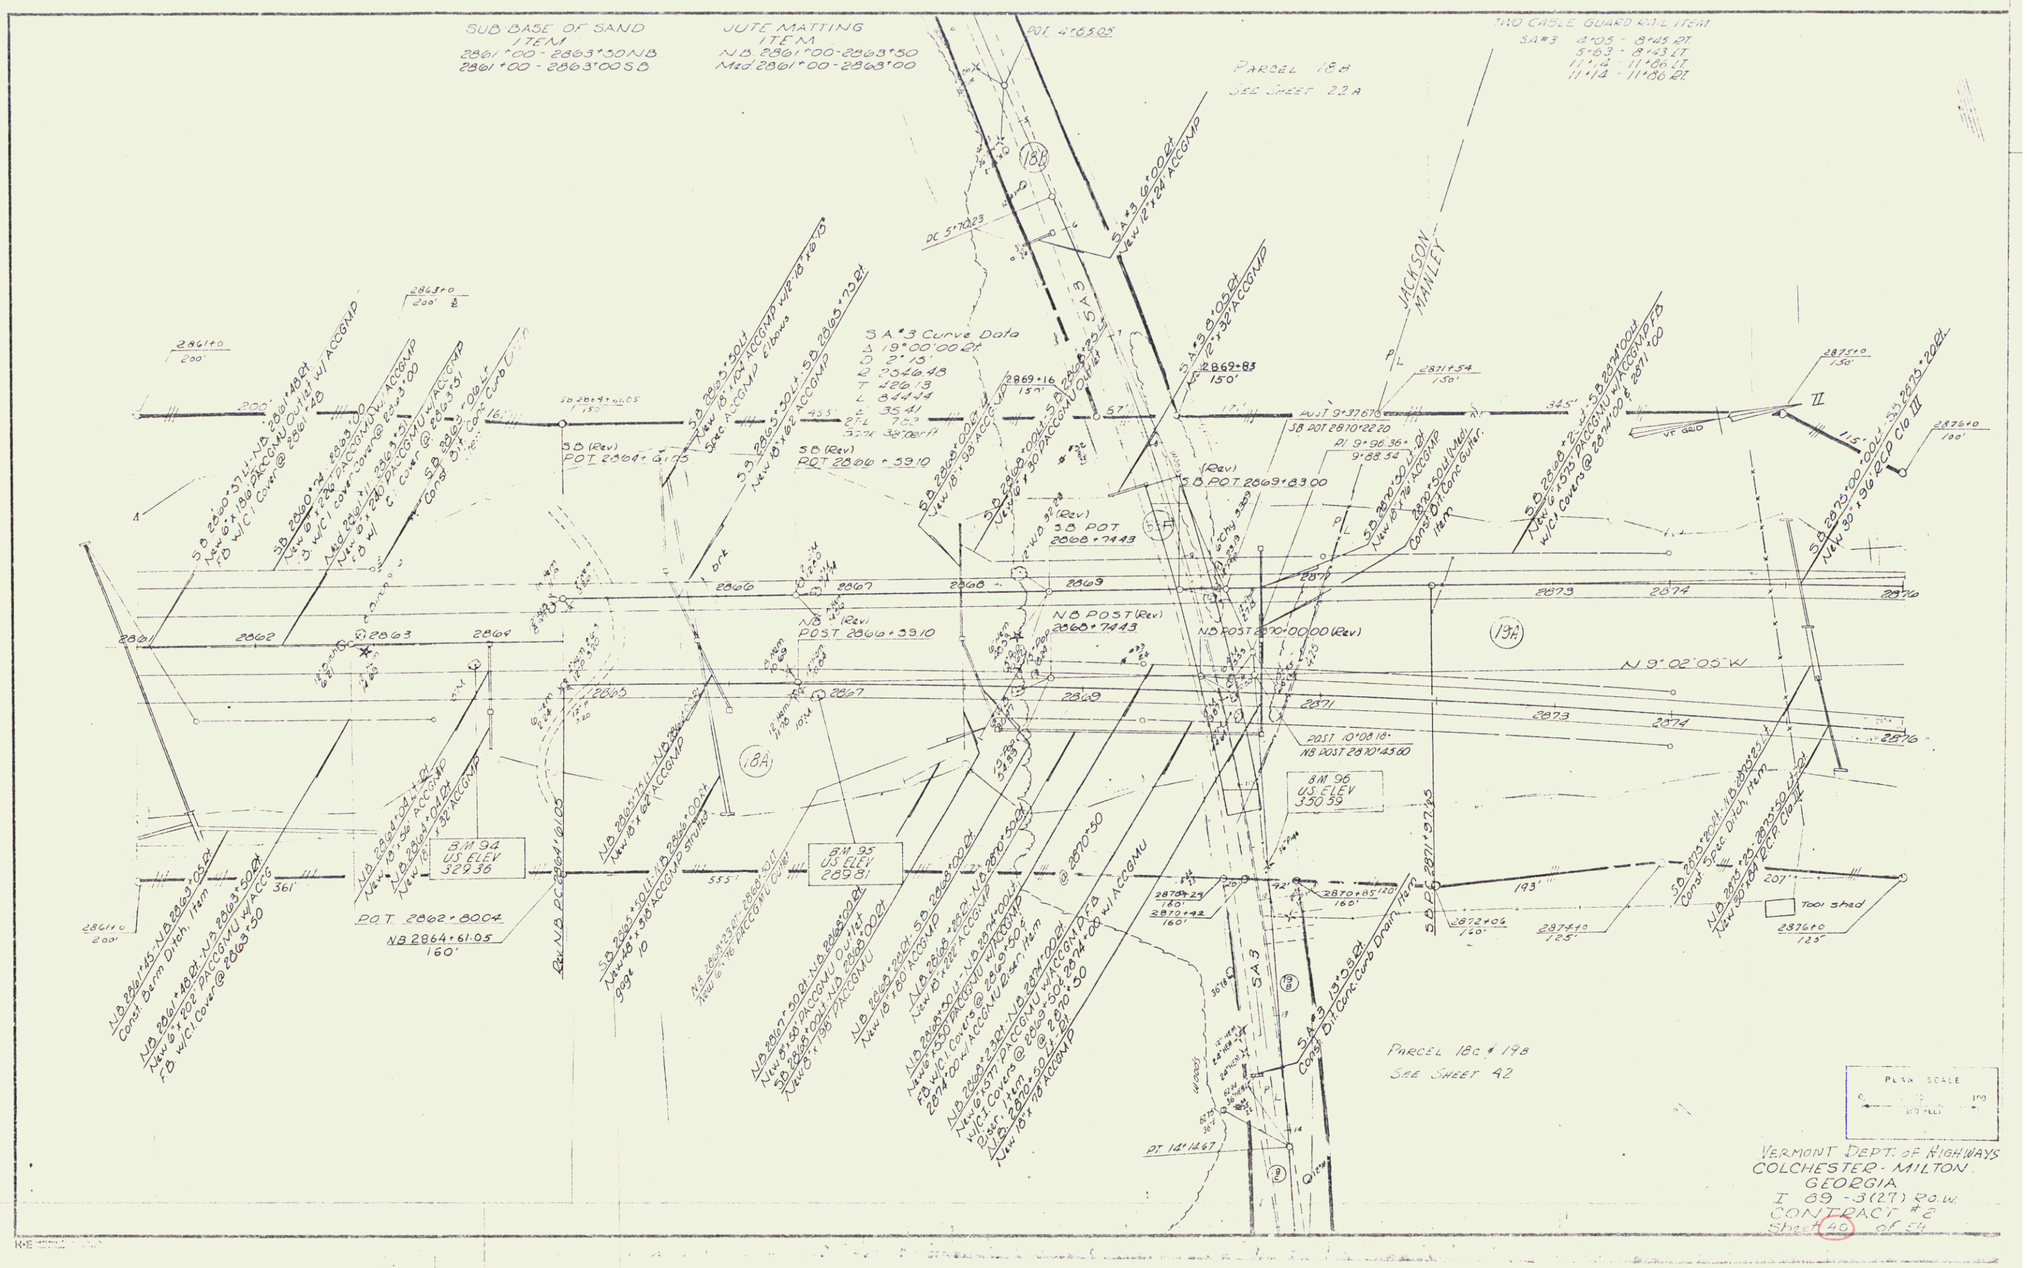
SUB BASE OF SAND ITEM
2861+00 - 2863+50 NB
2861+00 - 2863+00 SB
JUTE MATTING ITEM
NB 2861+00 - 2863+50
Med 2861+00 - 2863+00
PARCEL 18B
SEE SHEET 22A
TWO CABLE GUARD RAIL ITEM
S.A.#3 4+05 - 8+45 RT
5+63 - 8+43 LT
11+14 - 11+86 LT
11+14 - 11+86 RT
S.A.#3 Curve Data
JACKSON MANLEY
PARCEL 18C & 19B
SEE SHEET 42
BM 94 US ELEV 329.36
BM 95 US ELEV 289.81
BM 96 US ELEV 350.59
TOOL Shed
PLAN SCALE
VERMONT DEPT. OF HIGHWAYS
COLCHESTER - MILTON
GEORGIA
I 89 - 3(27) P.G.W.
CONTRACT #2
Sheet 40 of 54

29