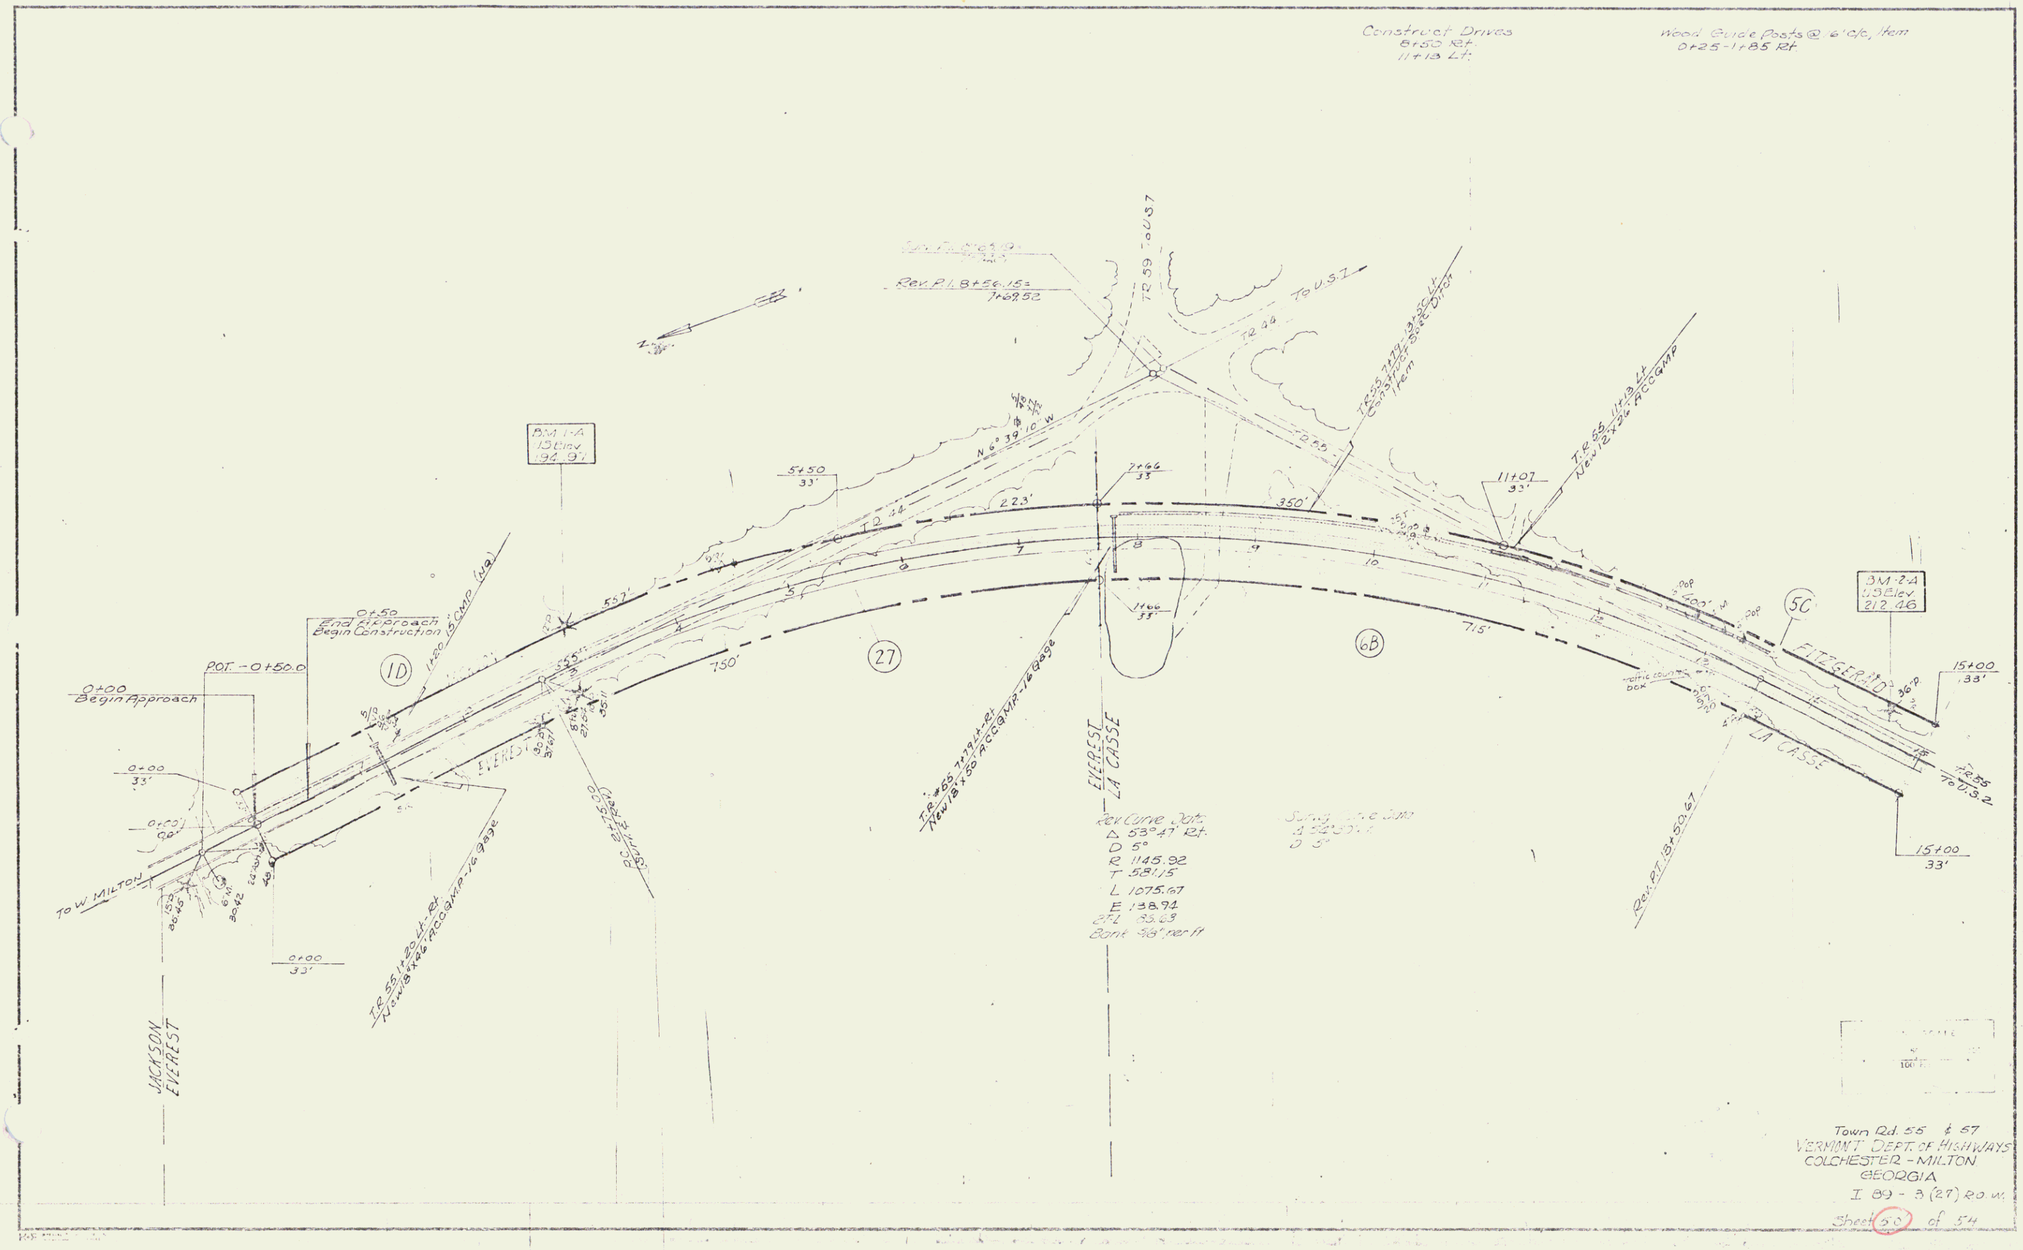
Construct Drives
8+50 Rt.
11+13 Lt.
Wood Guide Posts @ 6' o/c, Item
0+25-1+85 Rt
Rev. P.I. 8+56.15=
7+69.52
To U.S. 7
BM 1-A
13 Elev
194.97
5+50
33'
7+66
33'
11+07
33'
350'
223'
557'
750'
715'
0+50
End Approach
Begin Construction
P.O.T. - 0+50.0
0+00
Begin Approach
0+00
33'
0+00
33'
To W. MILTON
JACKSON
EVEREST
EVEREST
EVEREST
LA CASSE
FITZGERALD
LA CASSE
BM 2-A
U.S. Elev
212.46
5C
6B
27
1D
15+00
33'
15+00
33'
Rev. Curve Data
Δ 53°47' Rt.
D 5°
R 1145.92
T 581.15
L 1075.67
E 138.94
BFL 95.69
Bank 58' per ft
Town Rd. 55 & 57
VERMONT DEPT. OF HIGHWAYS
COLCHESTER - MILTON
GEORGIA
I 89 - 3 (27) R.O.W.
