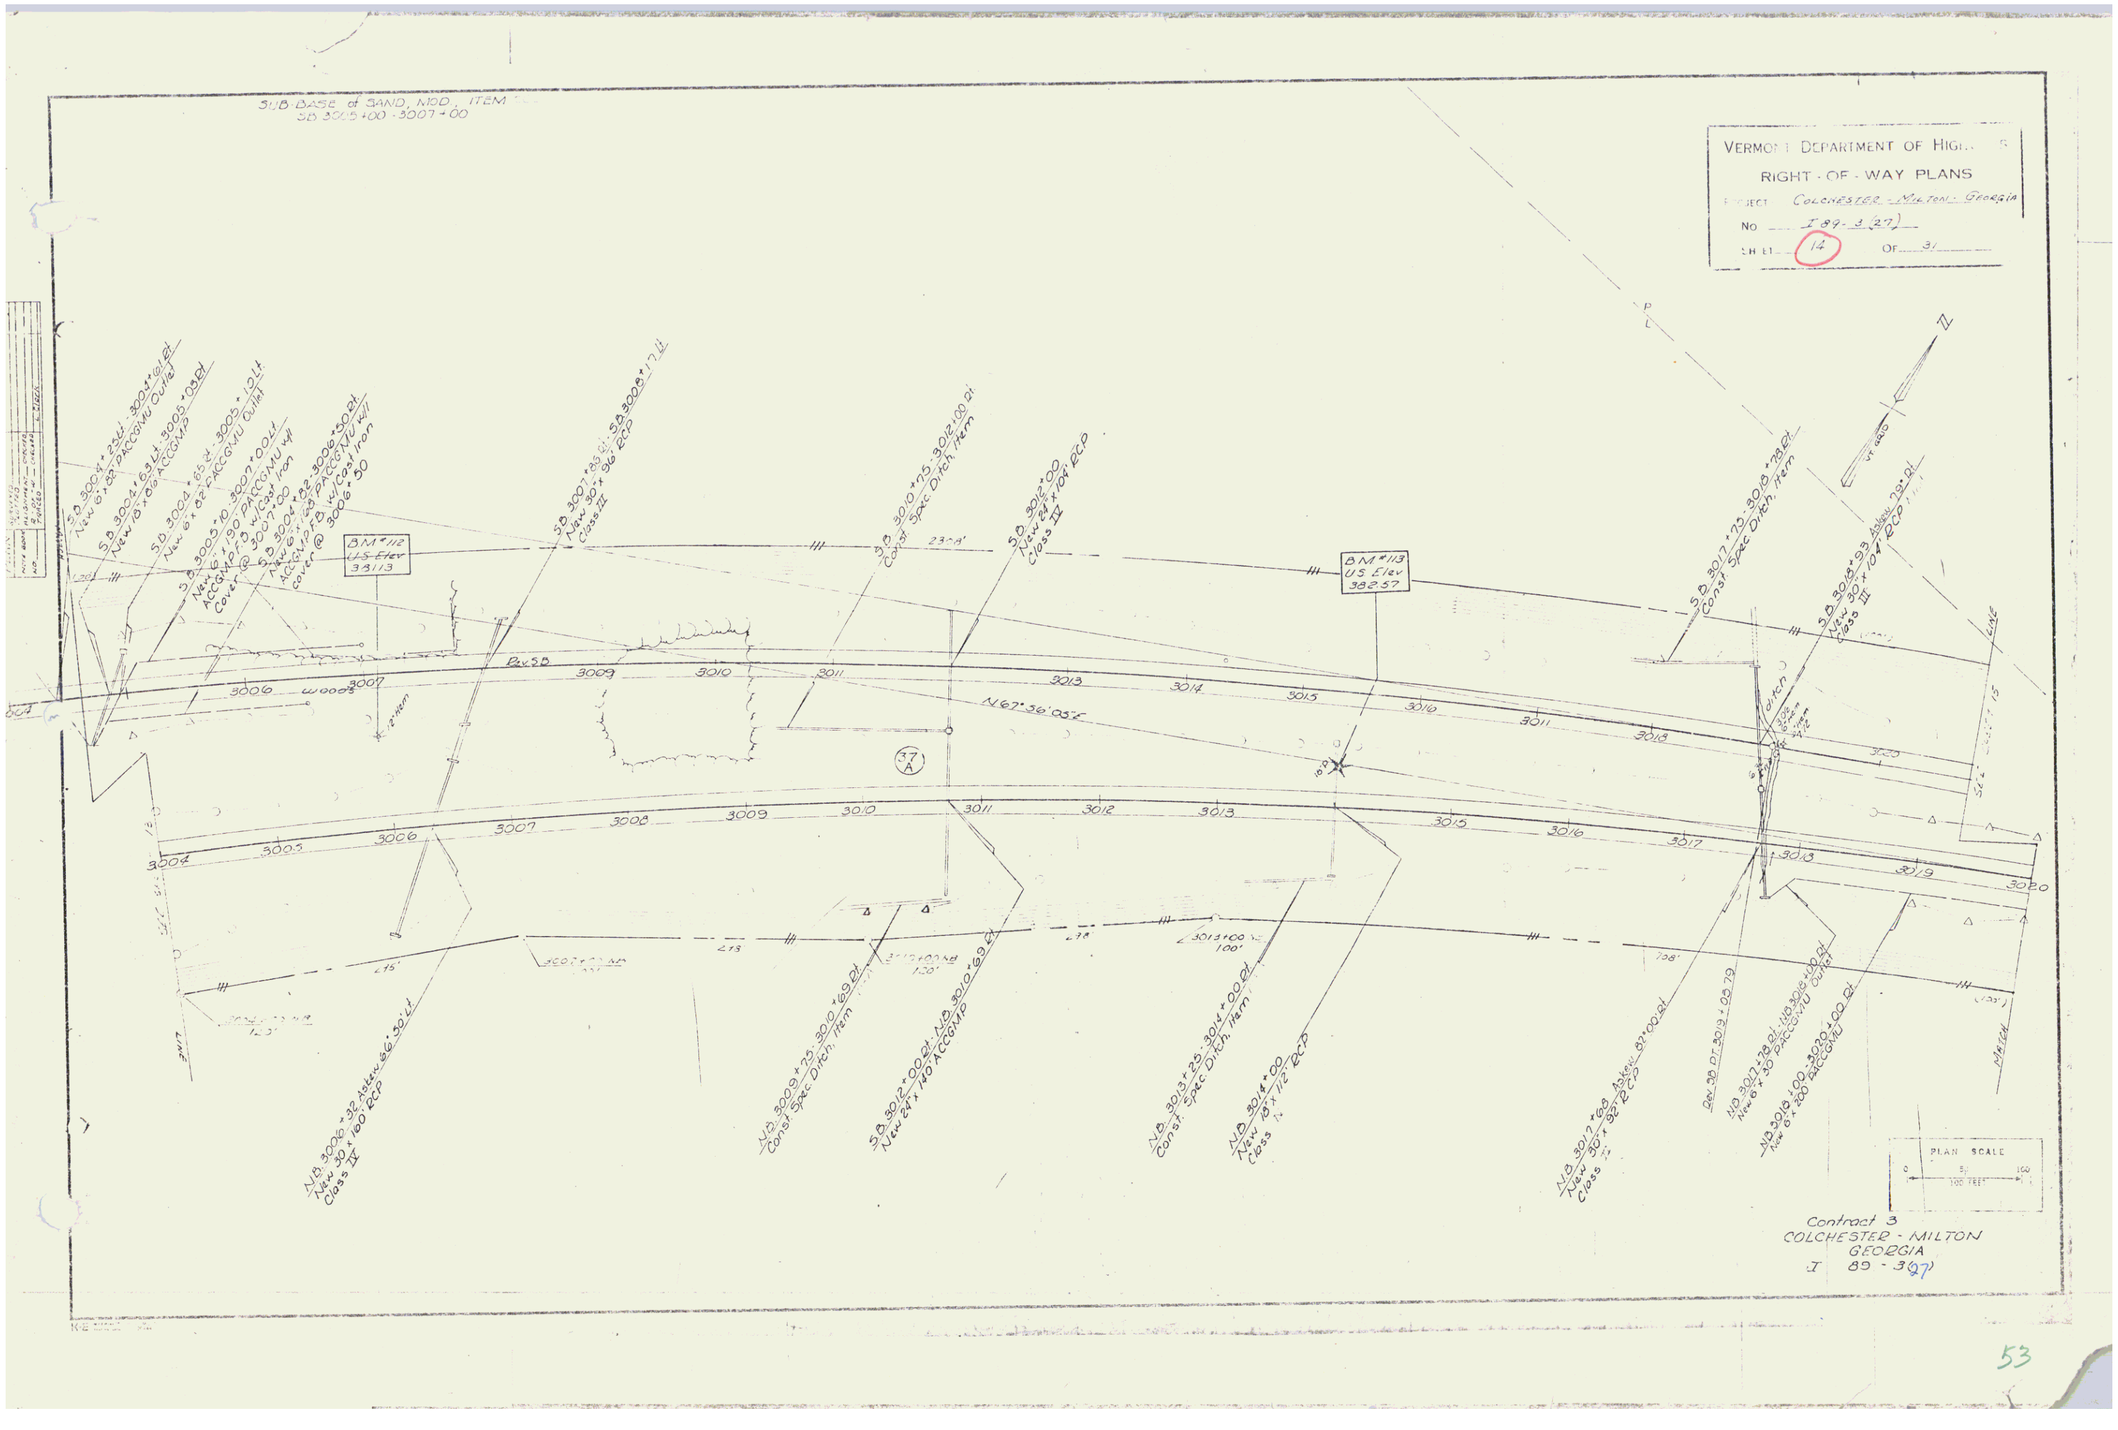
VERMONT DEPARTMENT OF HIGHWAYS
RIGHT - OF - WAY PLANS
PROJECT COLCHESTER - MILTON - GEORGIA
NO I 89-3 (27)
SHEET 14 OF 31
SUB BASE & SAND, NOD, ITEM
SD 3005+00 - 3007+00
BM #112 US Elev 38.13
BM #113 US Elev 38.57
N 67° 36' 05" E
PLAN SCALE
Contract 3
COLCHESTER - MILTON
GEORGIA
I 89 - 3(27)