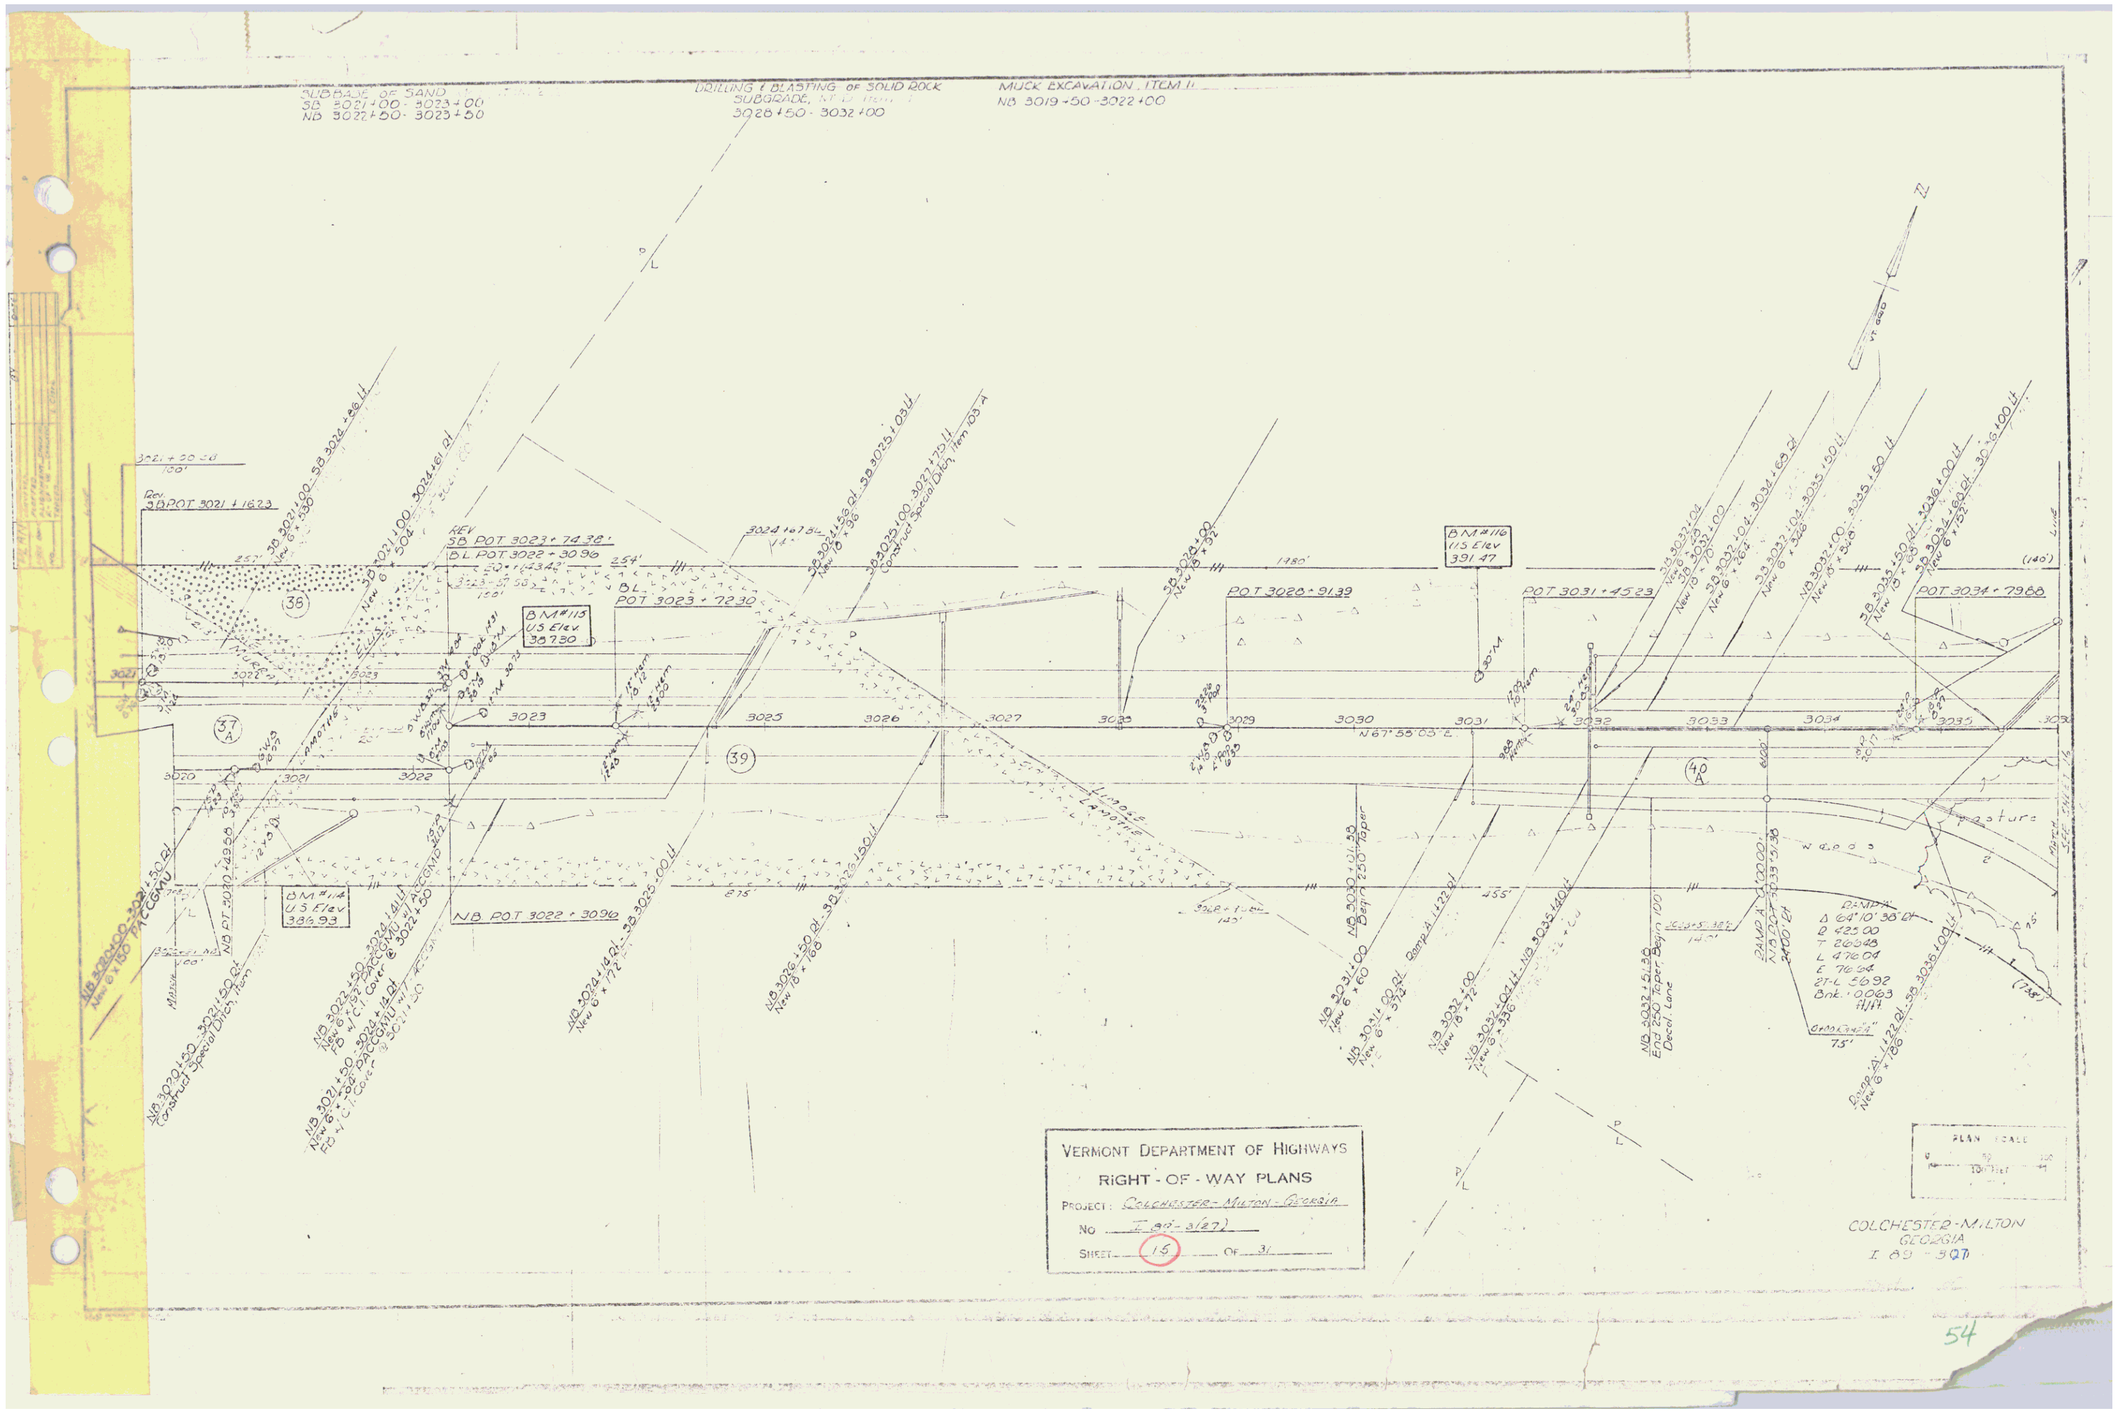
SUBBASE, OF SAND
SB 3021+00 - 3023+00
NB 3022+50 - 3023+50
DRILLING & BLASTING OF SOLID ROCK
SUBGRADE, NB
3028+50 - 3032+00
MUCK EXCAVATION, ITEM 11
NB 3019+50 - 3022+00
BM #115
US Elev.
387.30
BM #116
US Elev
391.47
POT 3028+91.39
POT 3031+45.23
POT 3034+79.88
NB POT 3022+30.96
N 67°55'05" E
Pasture
Woods
Δ 64°10'38"
D 425.00
T 268.48
L 476.04
E 76.64
21-L 56.92
Bnk. 0.063
4/14
Cross Section
75'
VERMONT DEPARTMENT OF HIGHWAYS
RIGHT - OF - WAY PLANS
PROJECT: COLCHESTER - MILTON - GEORGIA
No. I 89-3(27)
SHEET 15 OF 31
PLAN SCALE
COLCHESTER - MILTON
GEORGIA
I 89 - 3(27)

54