DRILLING & BLASTING OF SOLID ROCK SUBGRADE, ITEM 115
NB2694+90-2697+35

*THREE CABLE GUARD RAIL w/ STEEL POSTS, ITEM 542
2697+82 - 2699+94 N.B. Lt.
2698+34 - 2701+38 N.B. Rt.
2703+90 - 2709+00 N.B. Rt.

*BITUMINOUS CONCRETE CURB ITEM 555
2698+00 - 2699+77 N.B. Lt.
2698+50 - 2701+38 N.B. Rt.
2706+00 - 2709+00 N.B. Rt.

*STAGE 2 CONSTRUCTION
Property Line Fence w/ Steel Posts, Mod.
2693+00 — 2709+00 Rt.

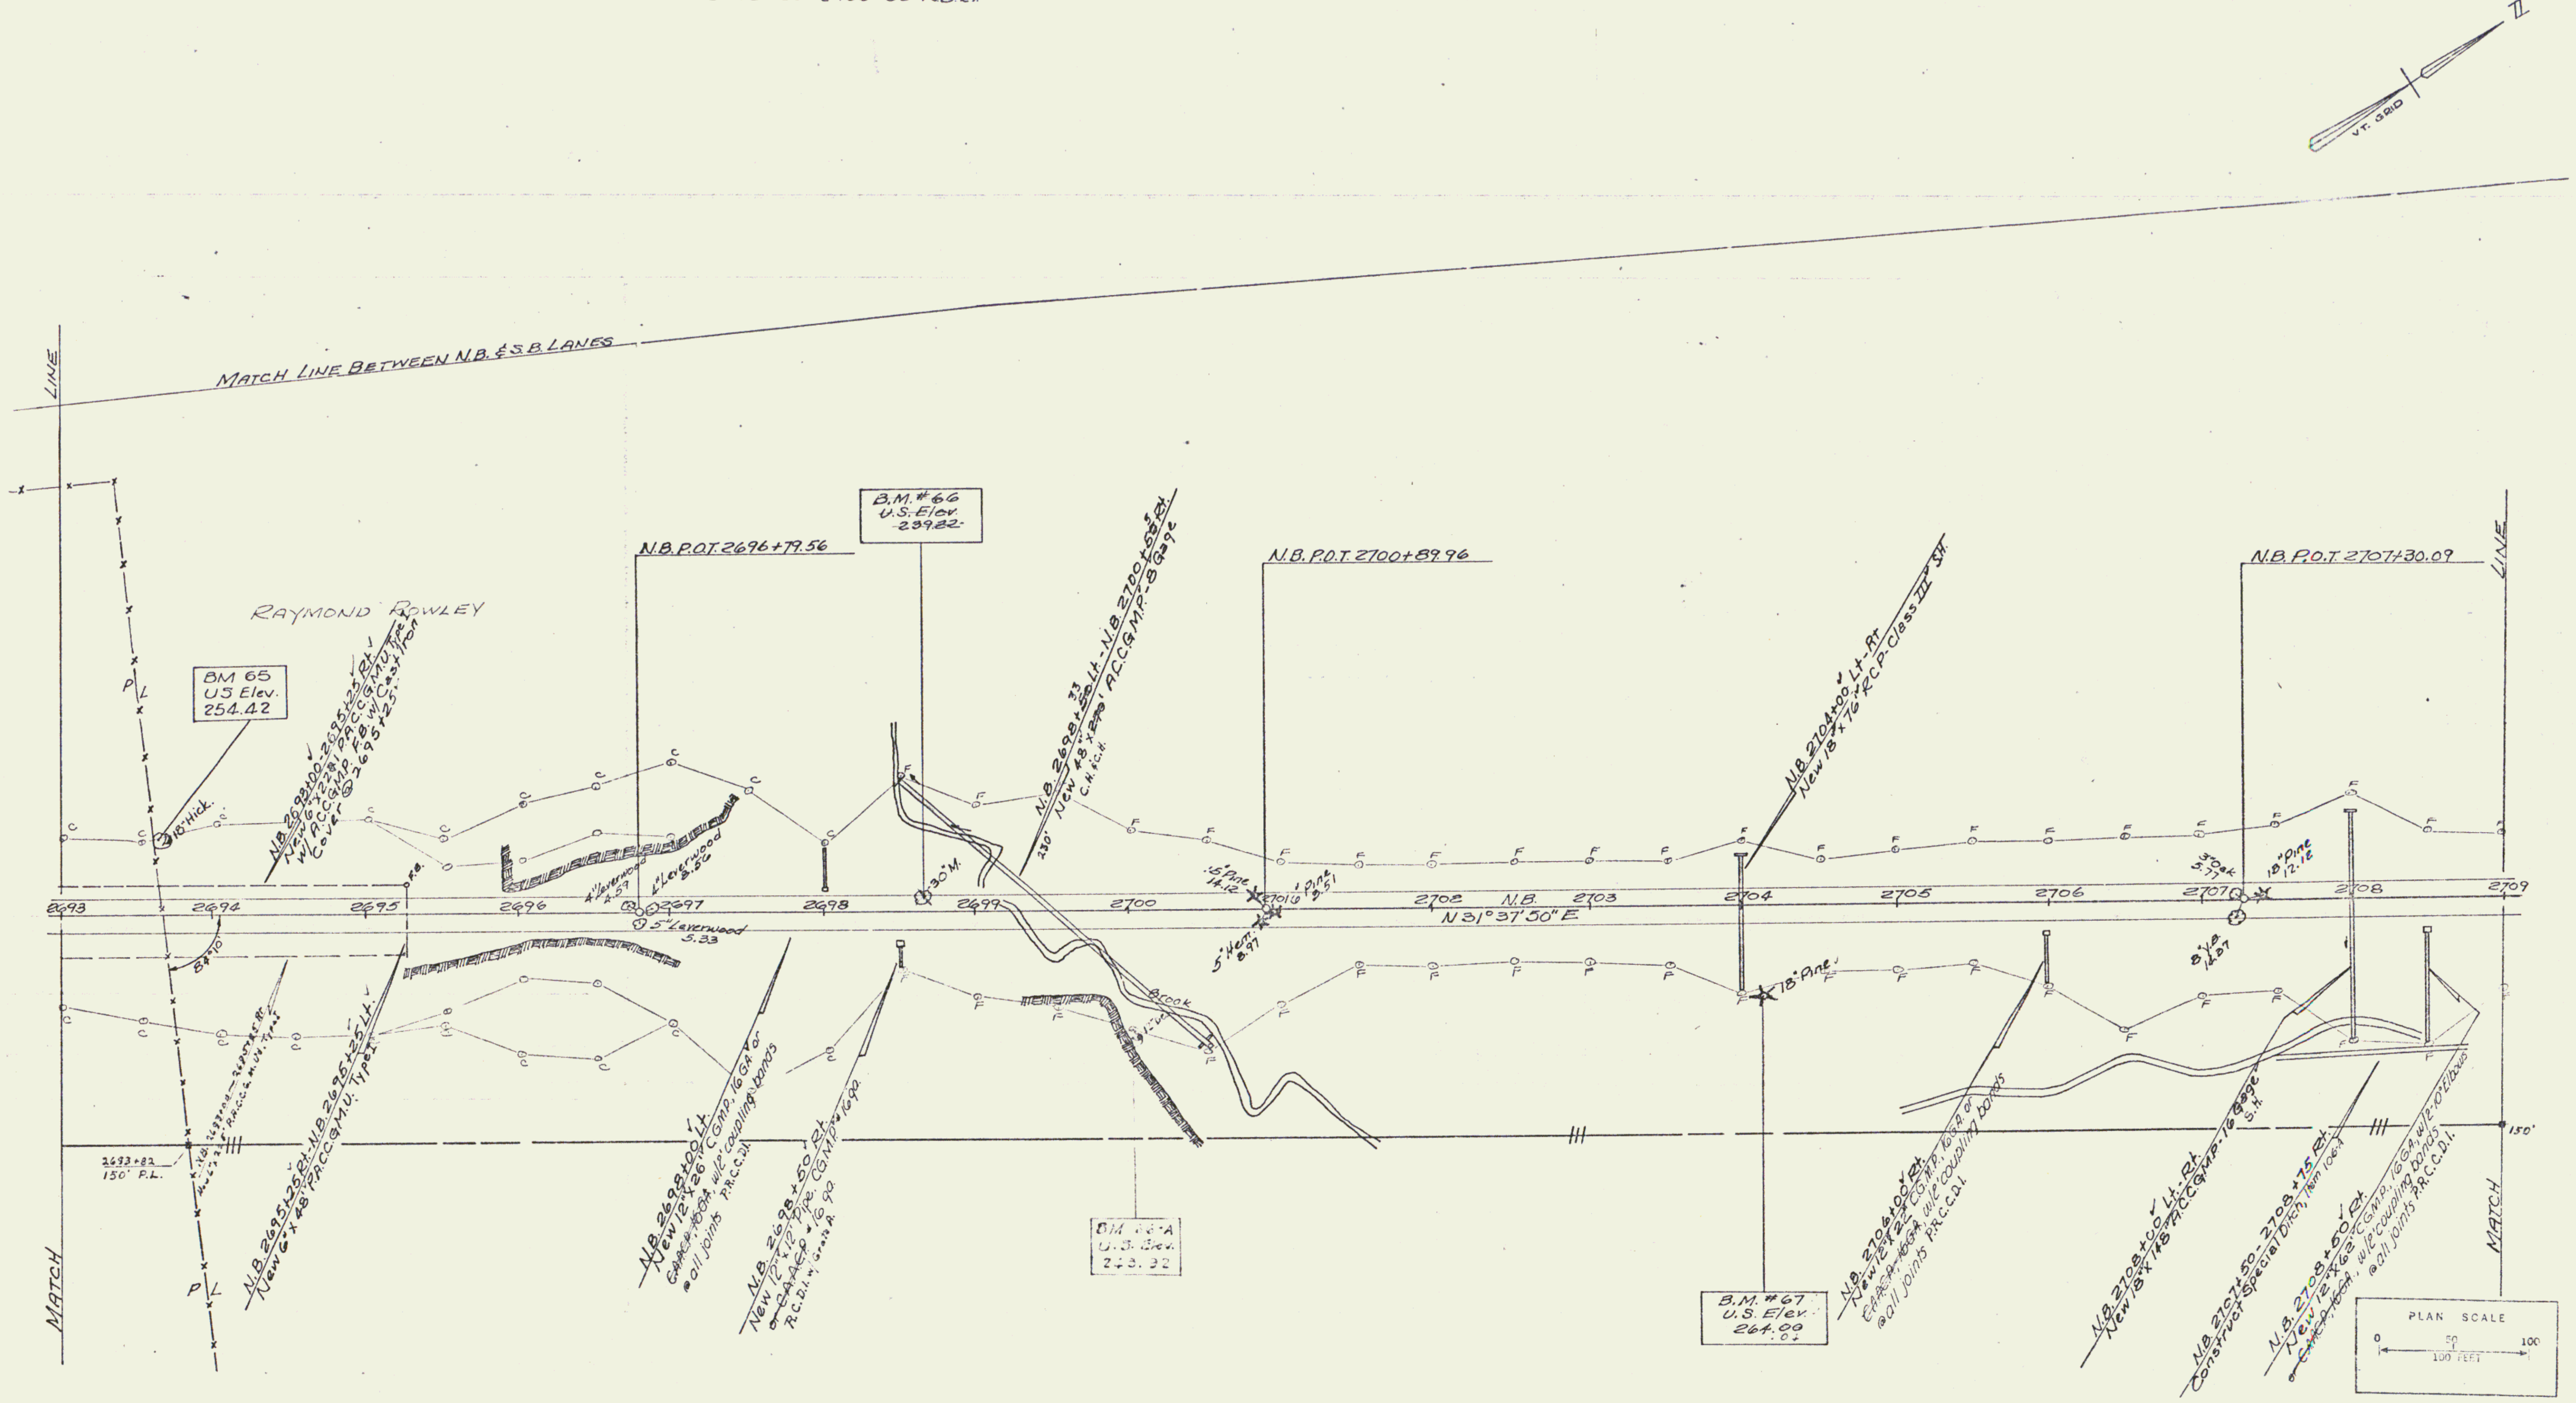

STAGE II CONSTRUCTION

NORTHBOUND LANE
COLCHESTER-MILTON
I89-3(40) I89-3(34)
Sheet 61 of 419
Sheet 62 of 177 Sheets

Control of Access is complete on this sheet.

71