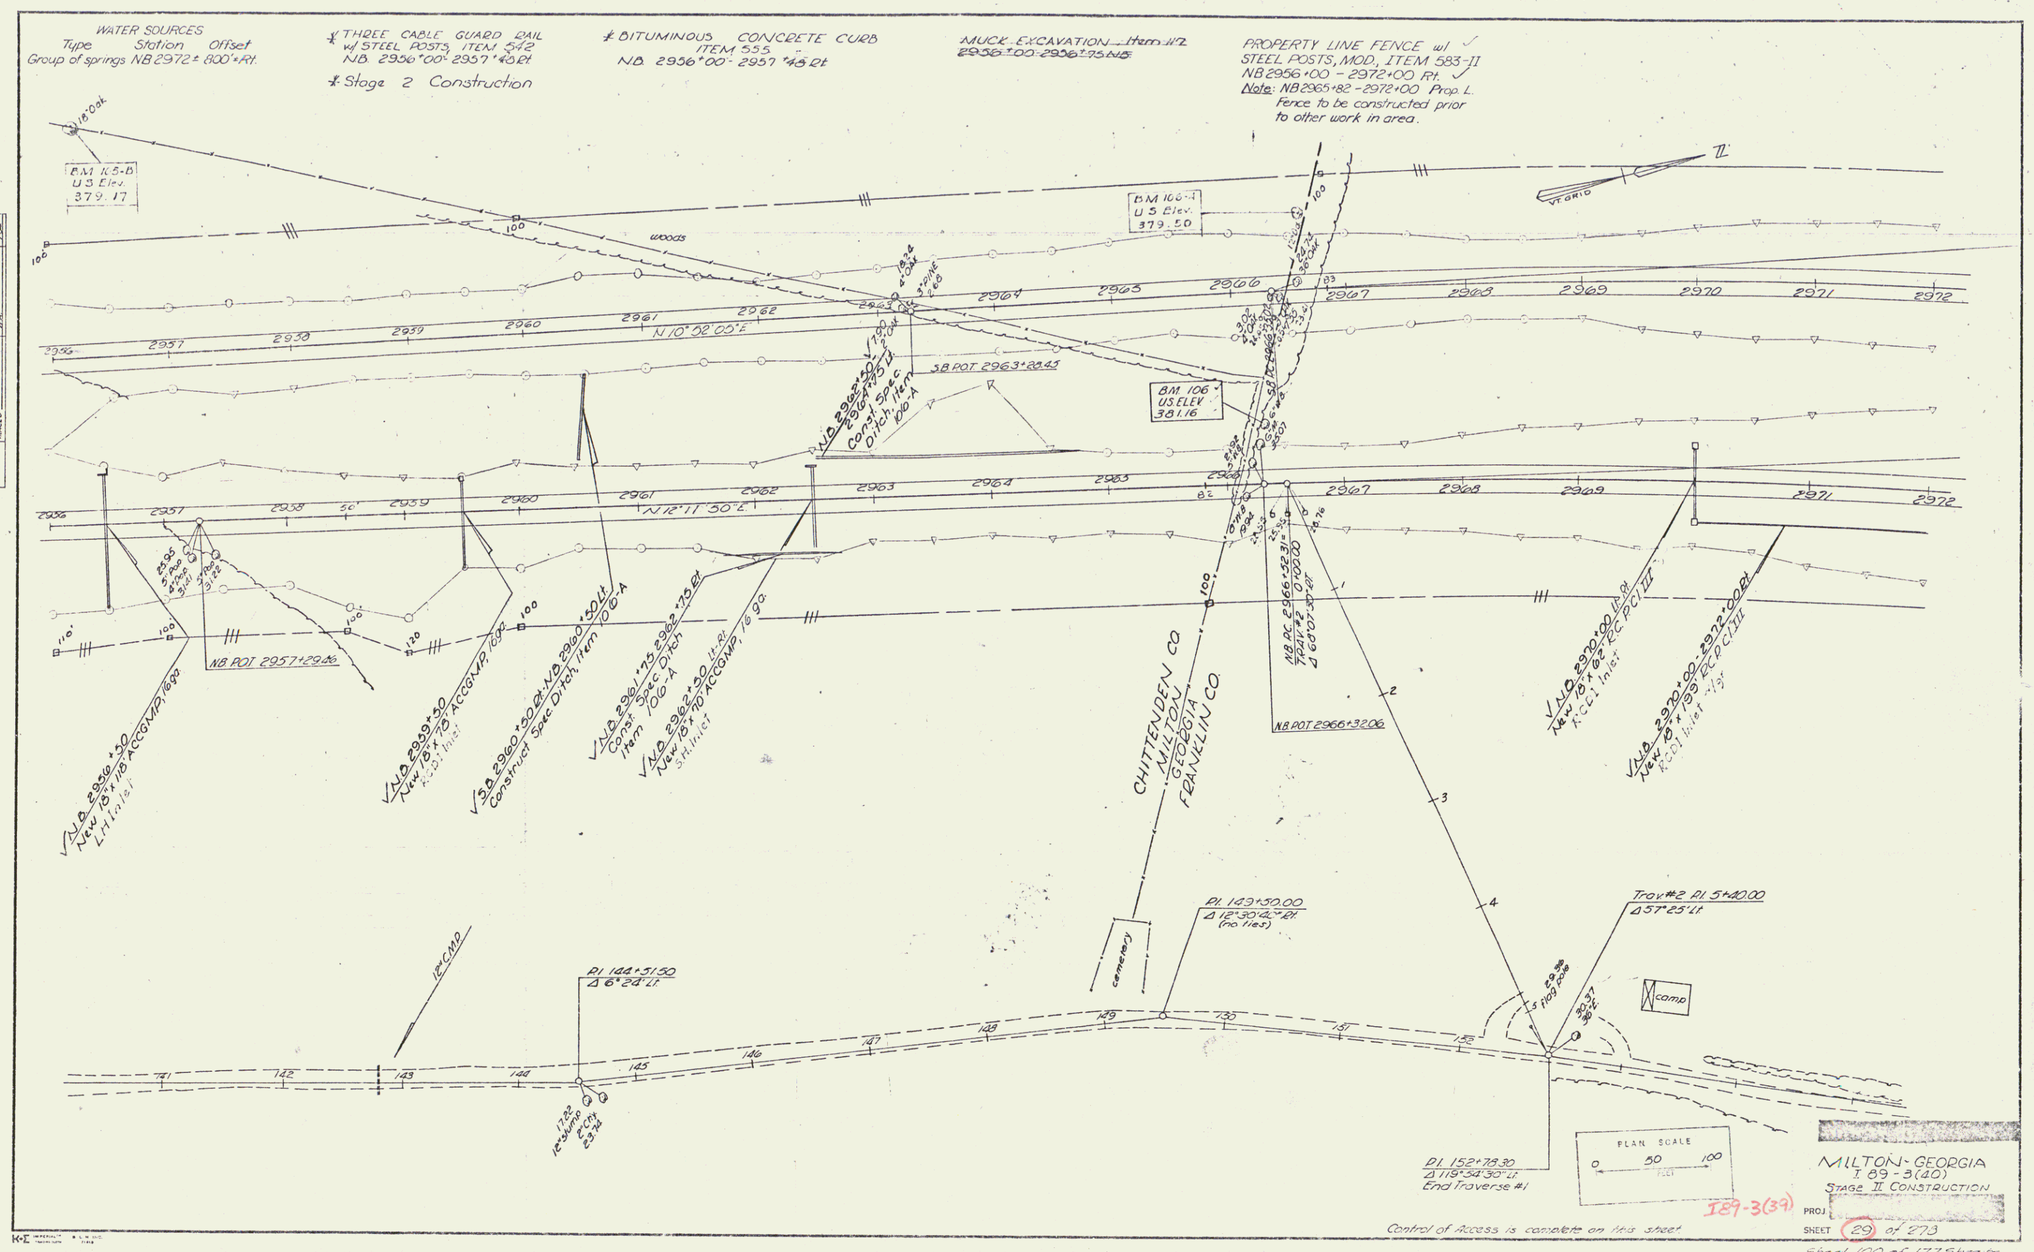
WATER SOURCES
Type Station Offset
Group of springs NB 2972 ± 800' Rt.
* THREE CABLE GUARD RAIL w/ STEEL POSTS, ITEM 542
NB 2956+00 - 2957+45 Rt
* BITUMINOUS CONCRETE CURB ITEM 555
NB 2956+00 - 2957+45 Rt
* Stage 2 Construction
MUCK EXCAVATION Item 112
2956+00-2956+75 NB
PROPERTY LINE FENCE w/ STEEL POSTS, MOD., ITEM 583-II
NB 2956+00 - 2972+00 Rt.
Note: NB 2965+82 - 2972+00 Prop. L. fence to be constructed prior to other work in area.
BM 105-B
US Elev.
379.17
BM 106-A
US Elev.
379.50
BM 106
US ELEV
381.16
WOODS
N 10°52'00"E
N 12°11'50"E
SB POT 2963+20.43
NB POT 2957+29.06
NB POT 2966+32.06
CHITTENDEN CO
MILTON
GEORGIA
FRANKLIN CO
PI 143+50.00
Δ 12°30'42" Rt
(no ties)
PI 144+51.50
Δ 6°24' Lt
Trav #2 PI 5+40.00
Δ 57°25' Lt
PI 152+78.30
Δ 119°54'30" Lt
End Traverse #1
cemetery
camp
12" CMP
PLAN SCALE
0 50 100
FEET
MILTON-GEORGIA
I 89-3(40)
STAGE II CONSTRUCTION
I89-3(39)
PROJ
SHEET 29 of 273
Control of Access is complete on this sheet
Sheet 100 of 177 Sheets
96