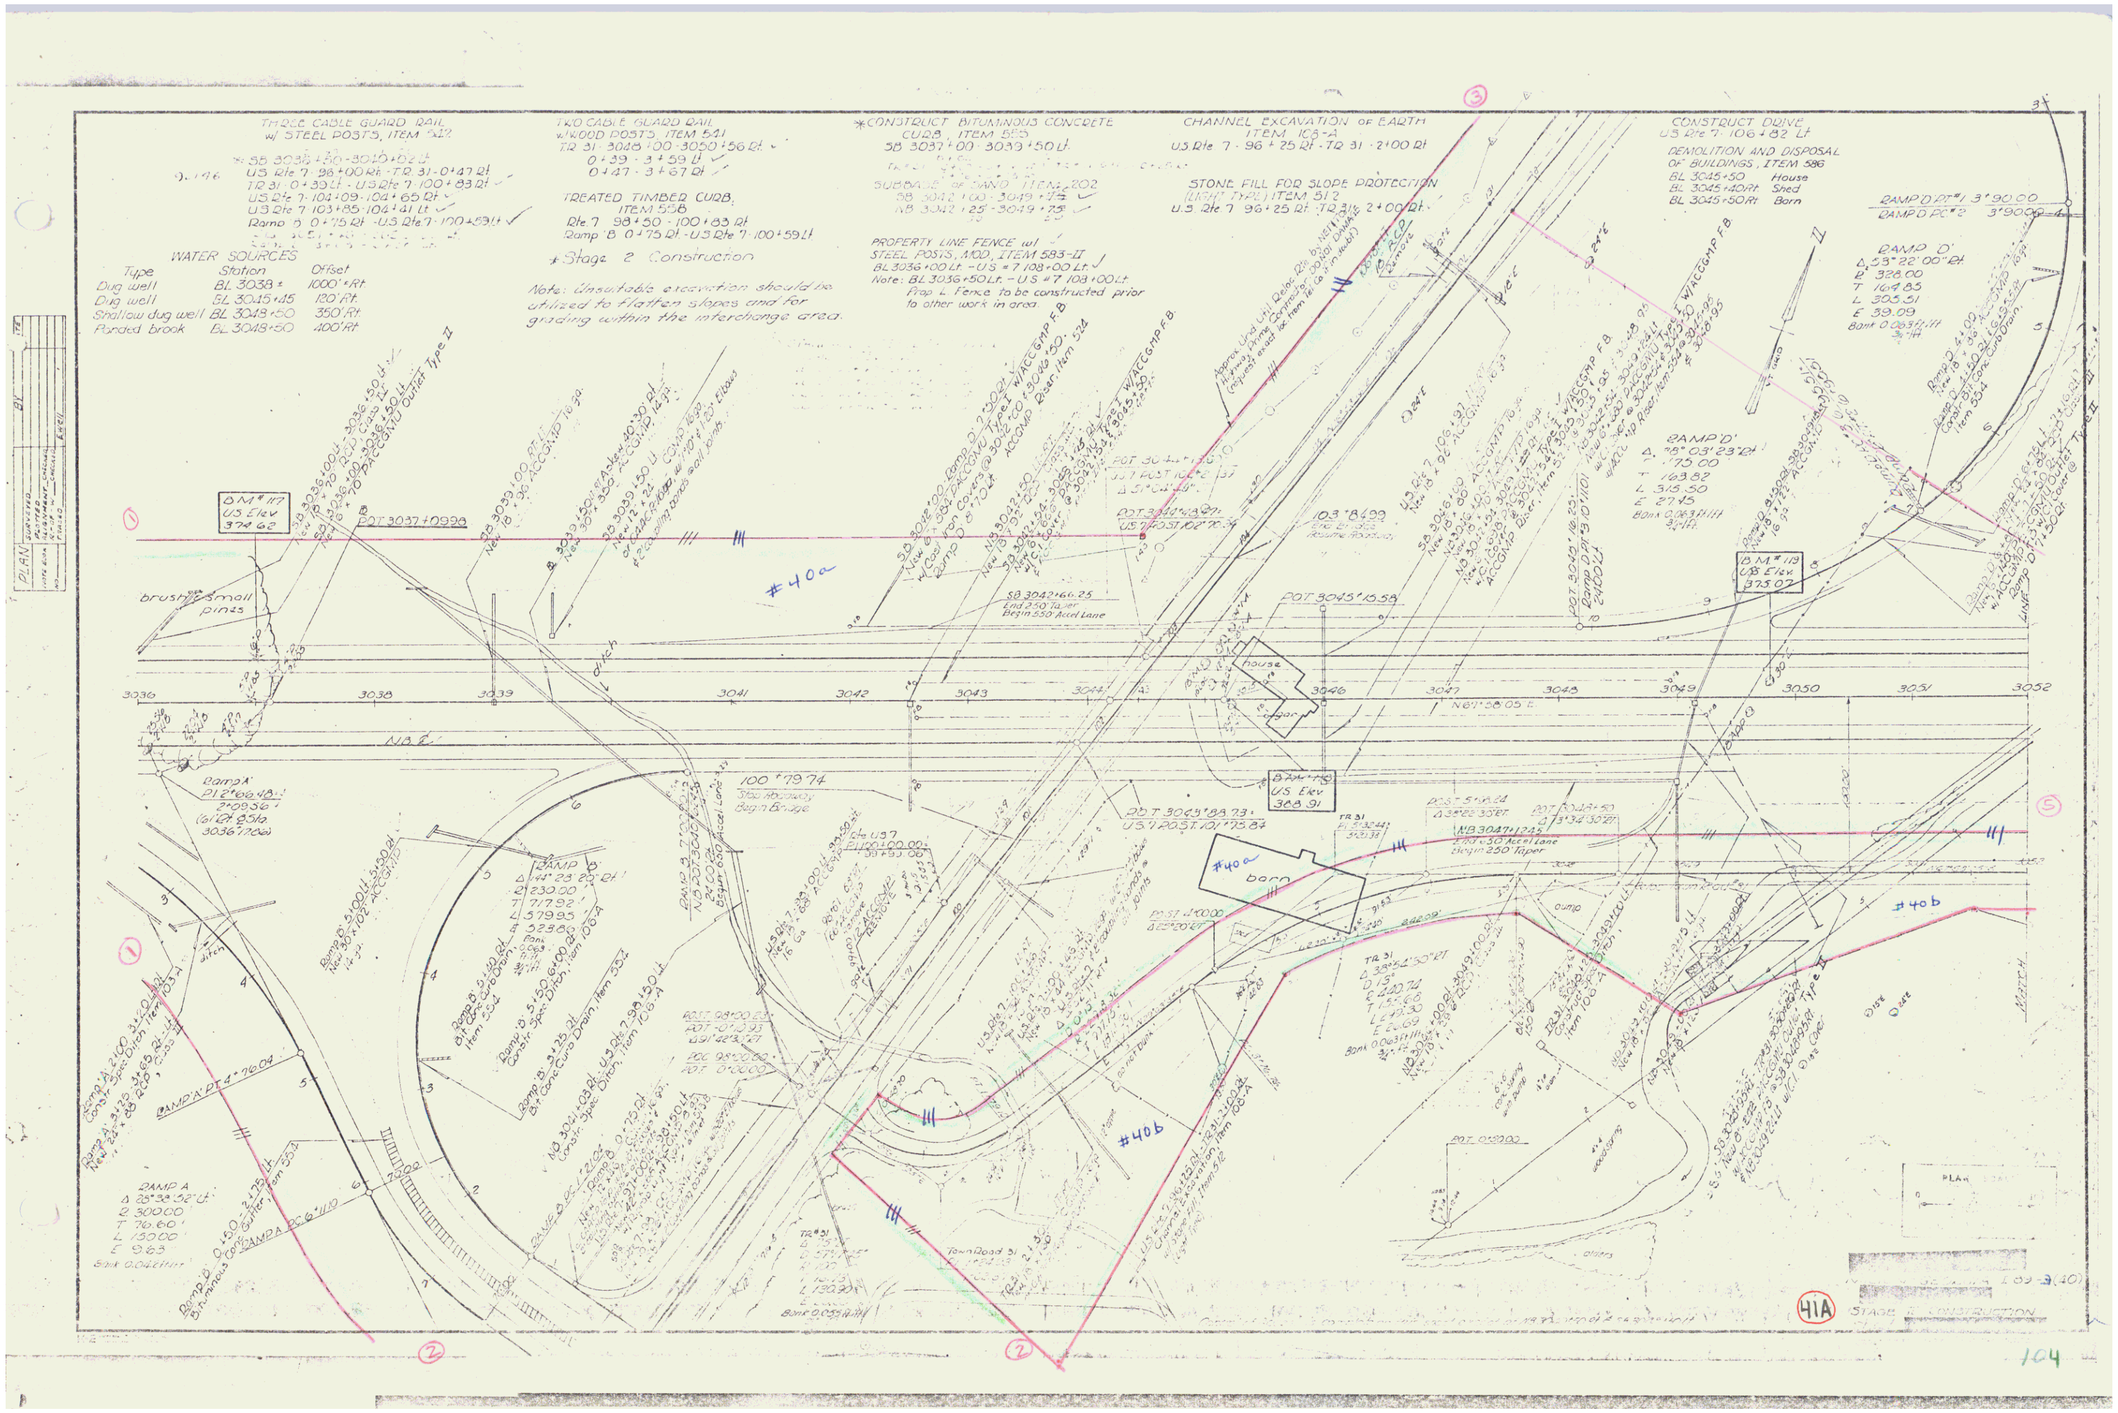
THREE CABLE GUARD RAIL w/ STEEL POSTS, ITEM 541
TWO CABLE GUARD RAIL w/ WOOD POSTS, ITEM 541
TREATED TIMBER CURB, ITEM 558
*CONSTRUCT BITUMINOUS CONCRETE CURB, ITEM 655
CHANNEL EXCAVATION OF EARTH ITEM 105-A
STONE FILL FOR SLOPE PROTECTION (LIGHT TYPE) ITEM 512
CONSTRUCT DRIVE
DEMOLITION AND DISPOSAL OF BUILDINGS, ITEM 586
WATER SOURCES
Type Station Offset
Dug well BL 3038± 1000' Rt
Dug well BL 3045+45 120' Rt
Shallow dug well BL 3048+50 350' Rt
Ponded brook BL 3048+50 400' Rt
* Stage 2 Construction
Note: Unsuitable excavation should be utilized to flatten slopes and for grading within the interchange area.
PROPERTY LINE FENCE w/
STEEL POSTS, MOD, ITEM 583-II
BL 3036+00 Lt. - US #7 108+00 Lt.
Note: BL 3036+50 Lt. - US #7 108+00 Lt.
Prop. L. Fence to be constructed prior to other work in area.
house
barn
#40a
#40b
brush & small pines
ditch
Town Road 31
Begin Bridge
Begin 250' Taper
Begin 550' Accel Lane
End 250' Taper
Begin 250' Accel Lane
PLAN
STAGE 2 CONSTRUCTION
41A
104