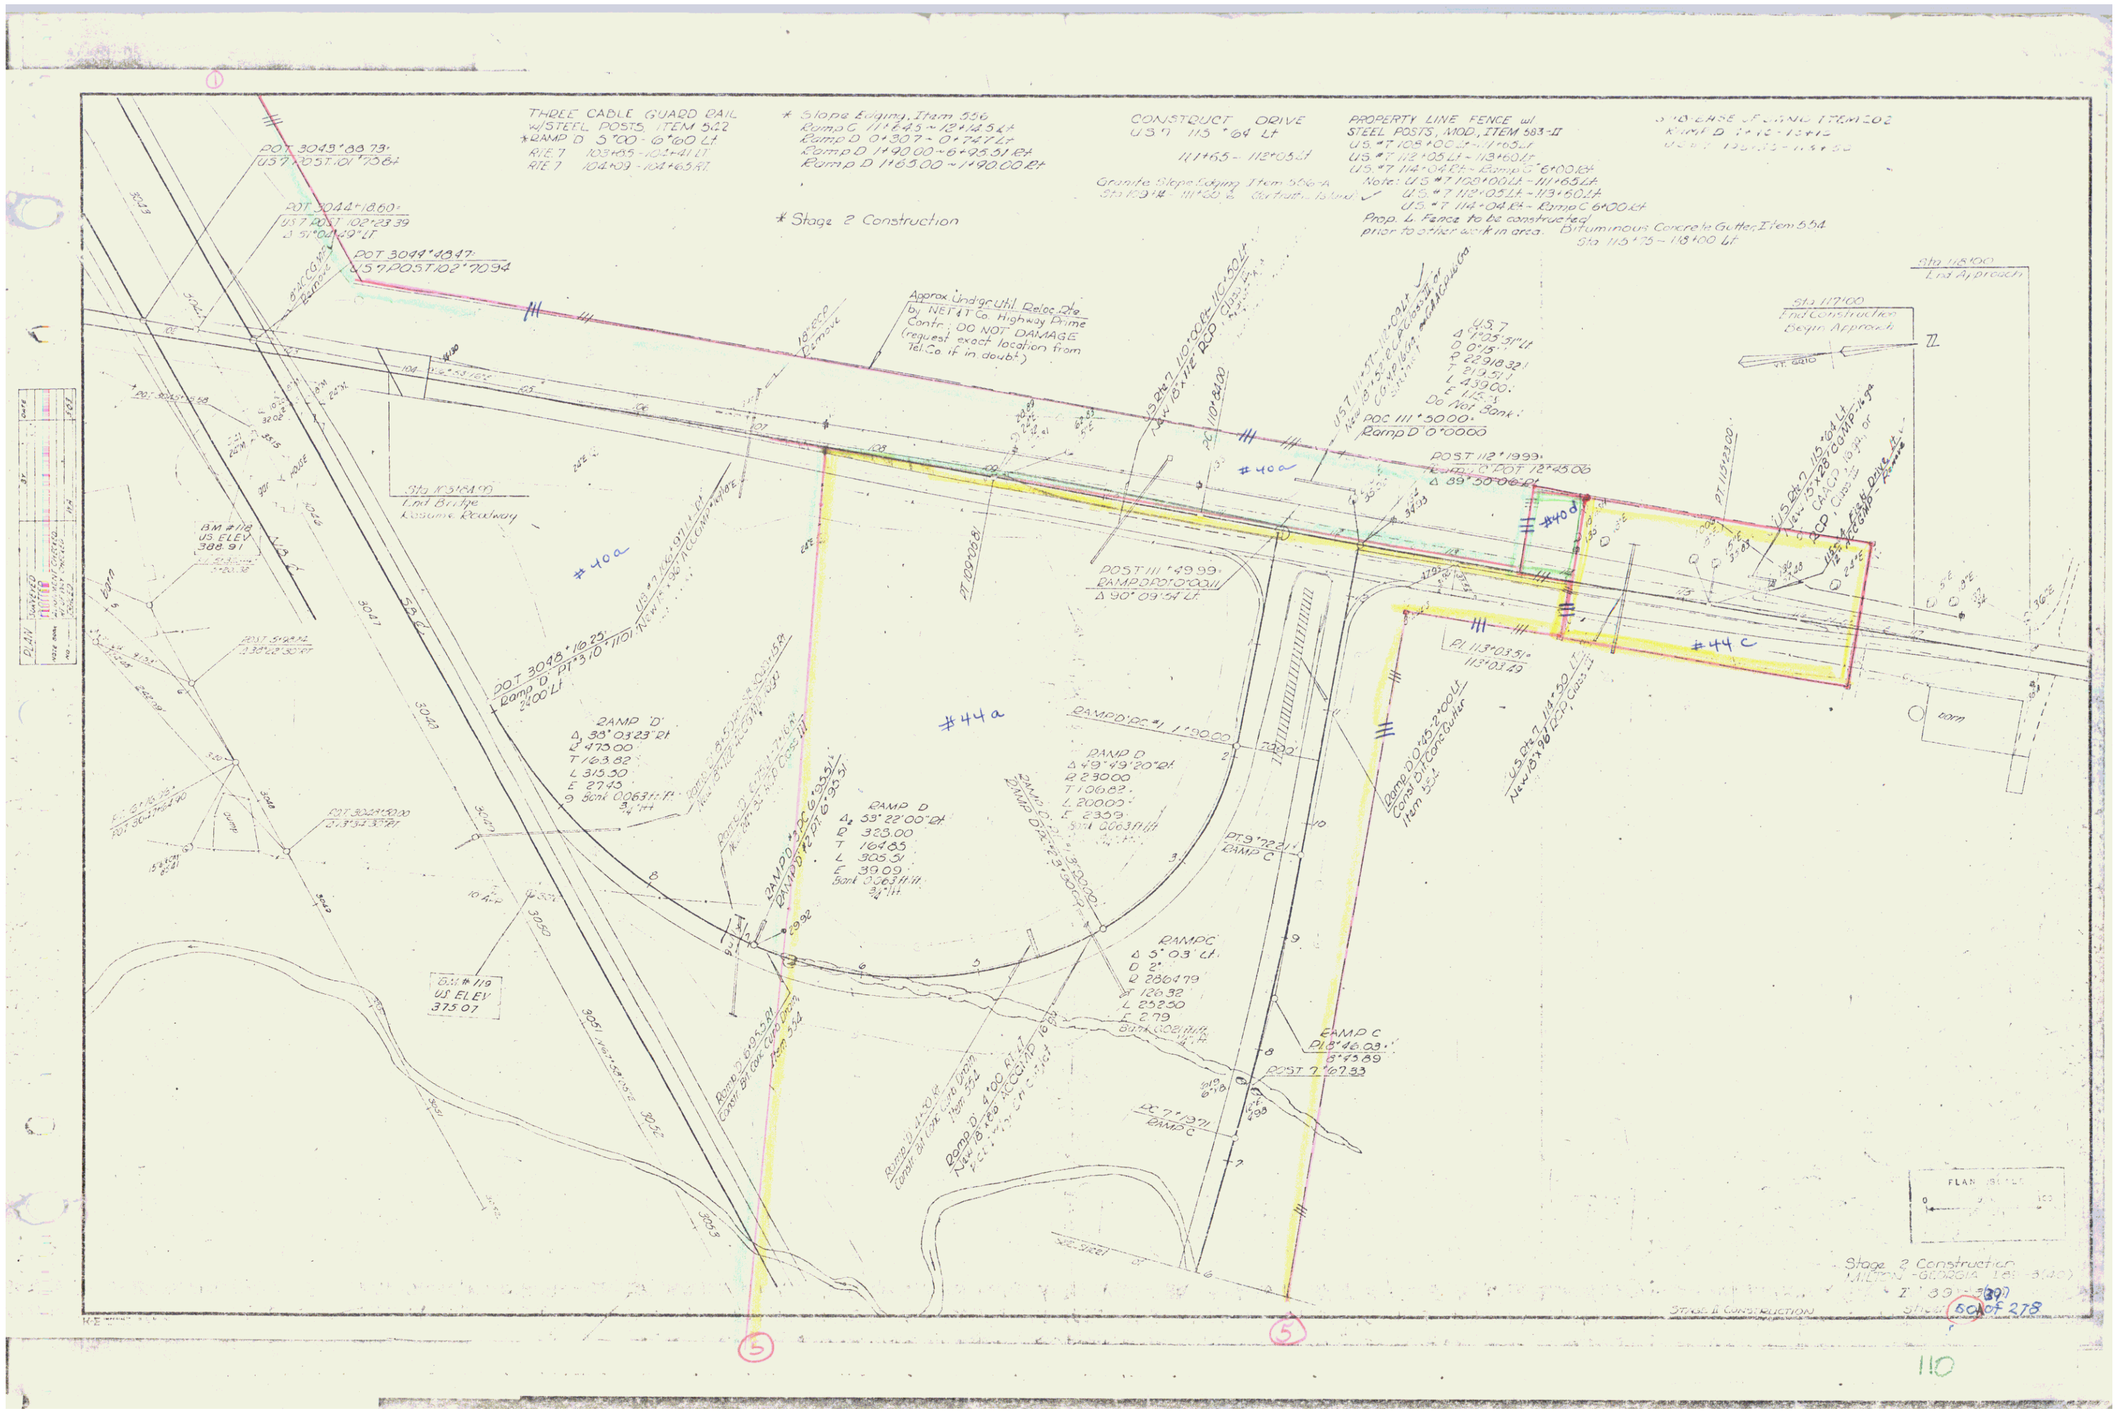
THREE CABLE GUARD RAIL w/STEEL POSTS, ITEM 542
* Slope Edging, Item 536
CONSTRUCT DRIVE
PROPERTY LINE FENCE w/ STEEL POSTS, MOD, ITEM 583-II
* Stage 2 Construction
Prop. L Fence to be constructed prior to other work in area.
Bituminous Concrete Gutter, Item 654
Approx Undgr Util Reloc Rte by NET & T Co. Highway Prime Contr.: DO NOT DAMAGE (request exact location from Tel. Co. if in doubt)
Sta 108100 End Approach
Sta 117100 End Construction Begin Approach
Sta 108+86.90 End Bridge Resume Roadway
#40a
#40d
#44a
#44c
RAMP D
RAMP C
Stage 2 Construction
Stage 2 Construction
Sheet 50 of 278
110