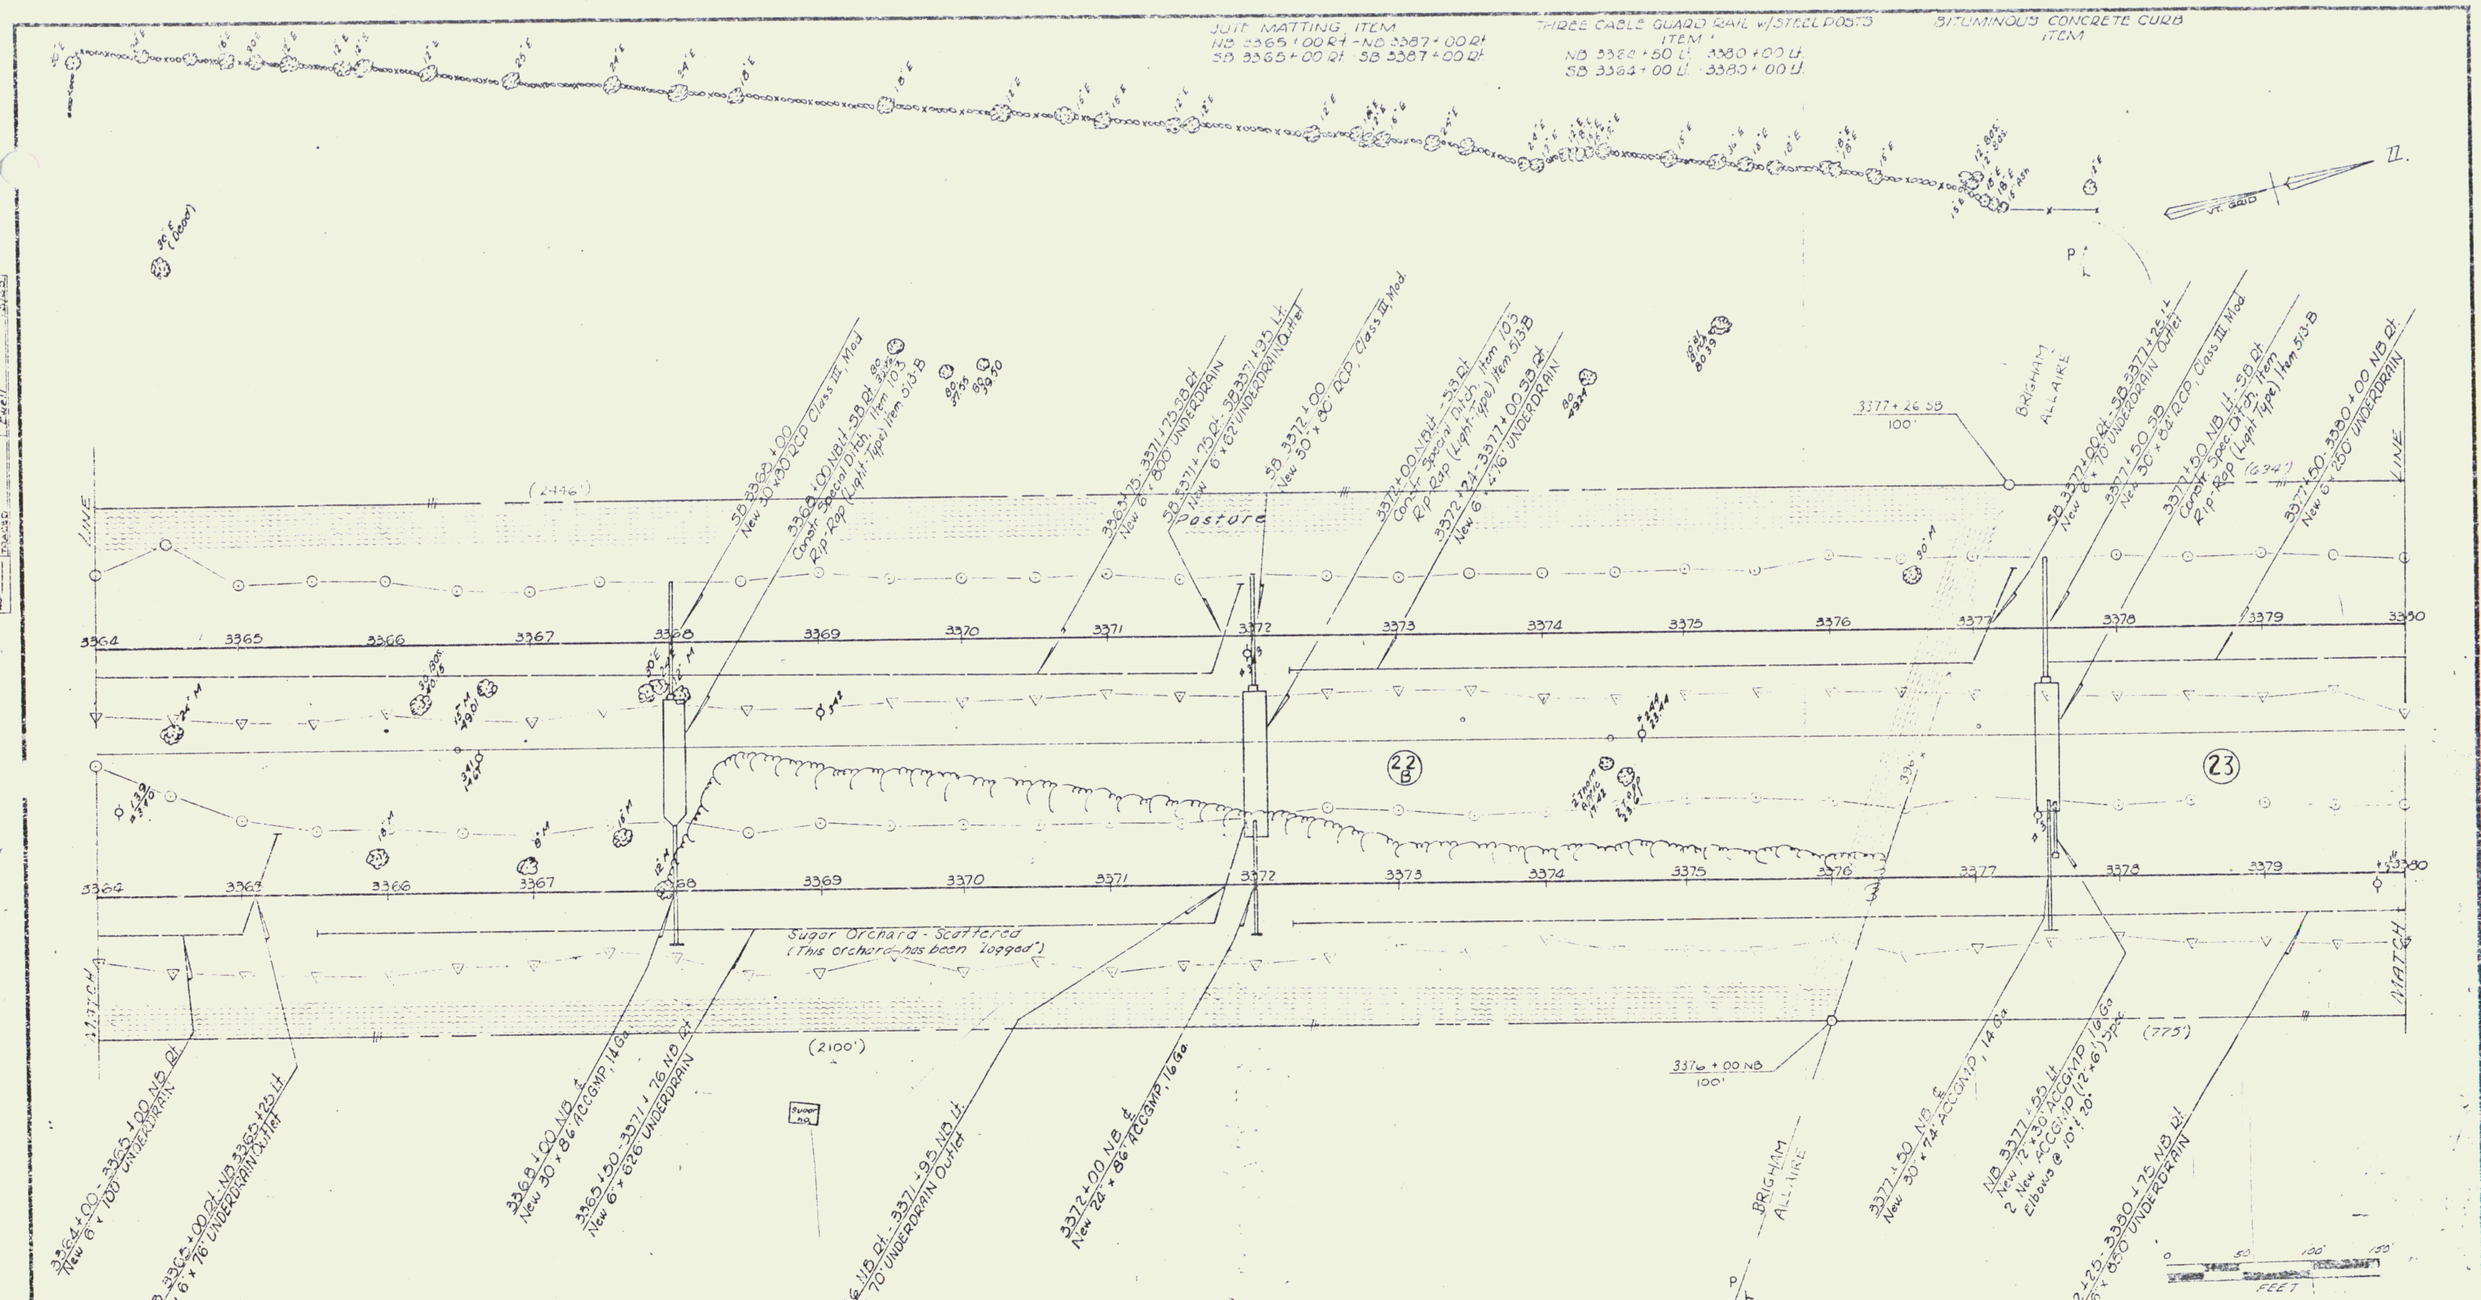

VERMONT DEPARTMENT OF HIGHWAYS
RIGHT - OF - WAY PLANS
PROJECT: GEORGIA - ST. ALBANS
NO: I-89-3(26)
SHEET 38 OF 76

45