 
* Bridge Railing for Bridge Approaches Item 572
SB 3096+94 - 3099+31 Rt.
SB 3096+94 - 3099+31 Lt.
NB 3096+00 - 3097+25 Rt.
NB 3096+00 - 3097+25 Lt.
* THREE CABLE GUARD RAIL w/ LIGHT STEEL POSTS ITEM 538
SB 3099+10 - 3106+07 Lt
DRILLING & BLASTING OF SOLID ROCK SUB GRADE ITEM 115
NB 3096+50 - 3100+00
SB 3097+50 - 3098+00
SB 3071+65 - 3099+75
* JUTE MATTING, ITEM 623
NB 3098+25 - 3102+75 Lt
DRILLING & BLASTING OF SOLID ROCK ITEM 114
SB 3096+87 - 3097+75
3095+00 - 3097+75
* STEEL BEAM GUARD RAIL w/ STEEL POSTS, ITEM 545-A (6'3" c/c)
3095+95 - 3096+89 NB Lt. - SB Rt.
PROPERTY LINE FENCE w/ STEEL POSTS, MOD. ITEM 583-II
SB 3097+00 - 3100+00 Lt.
NB 3094+00 - 3100+00 Rt.
SB 3094+00 - 3100+00 Lt.
* DENOTES STAGE II CONSTRUCTION.
CONTROL OF ACCESS IS COMPLETE ON THIS SHEET.
PI 204+00
Δ 8°04'00" Rt.
PI 194+00
Δ 8°42'00" RT.
Central Vermont RR
197+00 30'x25' Stone Box
3094+15 (SB Lt.) 25'x20' Stone Box
End Bridge - Resume Roadway SB 3096+86.70
End Bridge - Resume Roadway NB 3095+82.89
3096+90 SB Rt. - 3097+30 SB Rt. New 12"x38" CGMP 16 ga. or CACP 16 ga.
3097+50 SB Lt. New 6'x5' Underdrain w/ Flushing Basin
3099+00 SB Lt. New 18"x80' ACCGMP, 16 Ga.
Rev. S.B.
3096+00 - 3096+30 NB Rt. New 12"x38" CGMP, 16 ga. or CACP, 16 ga.
3096+60 NB Lt. New 12"x22' CGMP or CACP, 16 ga.
3096+160 NB Lt. New 6'x50' Underdrain w/ Flushing Basin
3099+00 NB Lt. New 18"x79' ACCGMP, 16 Ga.
Rev. NB P.C.C. 3099+62.25
Subtangent
B.M. #126 ASMD Elev 467.287
B.M. #127 ASMD Elev 482.236
B.M. #128 ASMD Elev 548.157
Curve Data #9
Δ 52° 51' 15" Lt.
D 1° 00'
R 5729.58
T 2847.61
L 5285.42
E 668.06
Bank 5/16" per ft.
N15°06'50"E
MATCH LINE
MATCH
VT. GRID N
PLAN SCALE
Stage 2 Construction
GEORGIA-FAIRFAX-FAIRFIELD-ST. ALBANS
PLAN & PROFILE
NOTE BOOK
NO.
SURVEYED
PLOTTED
ALIGNMENT CHECKED
H.D.V. CHECKED
TRACED
DATE
Spalding County
Enrill