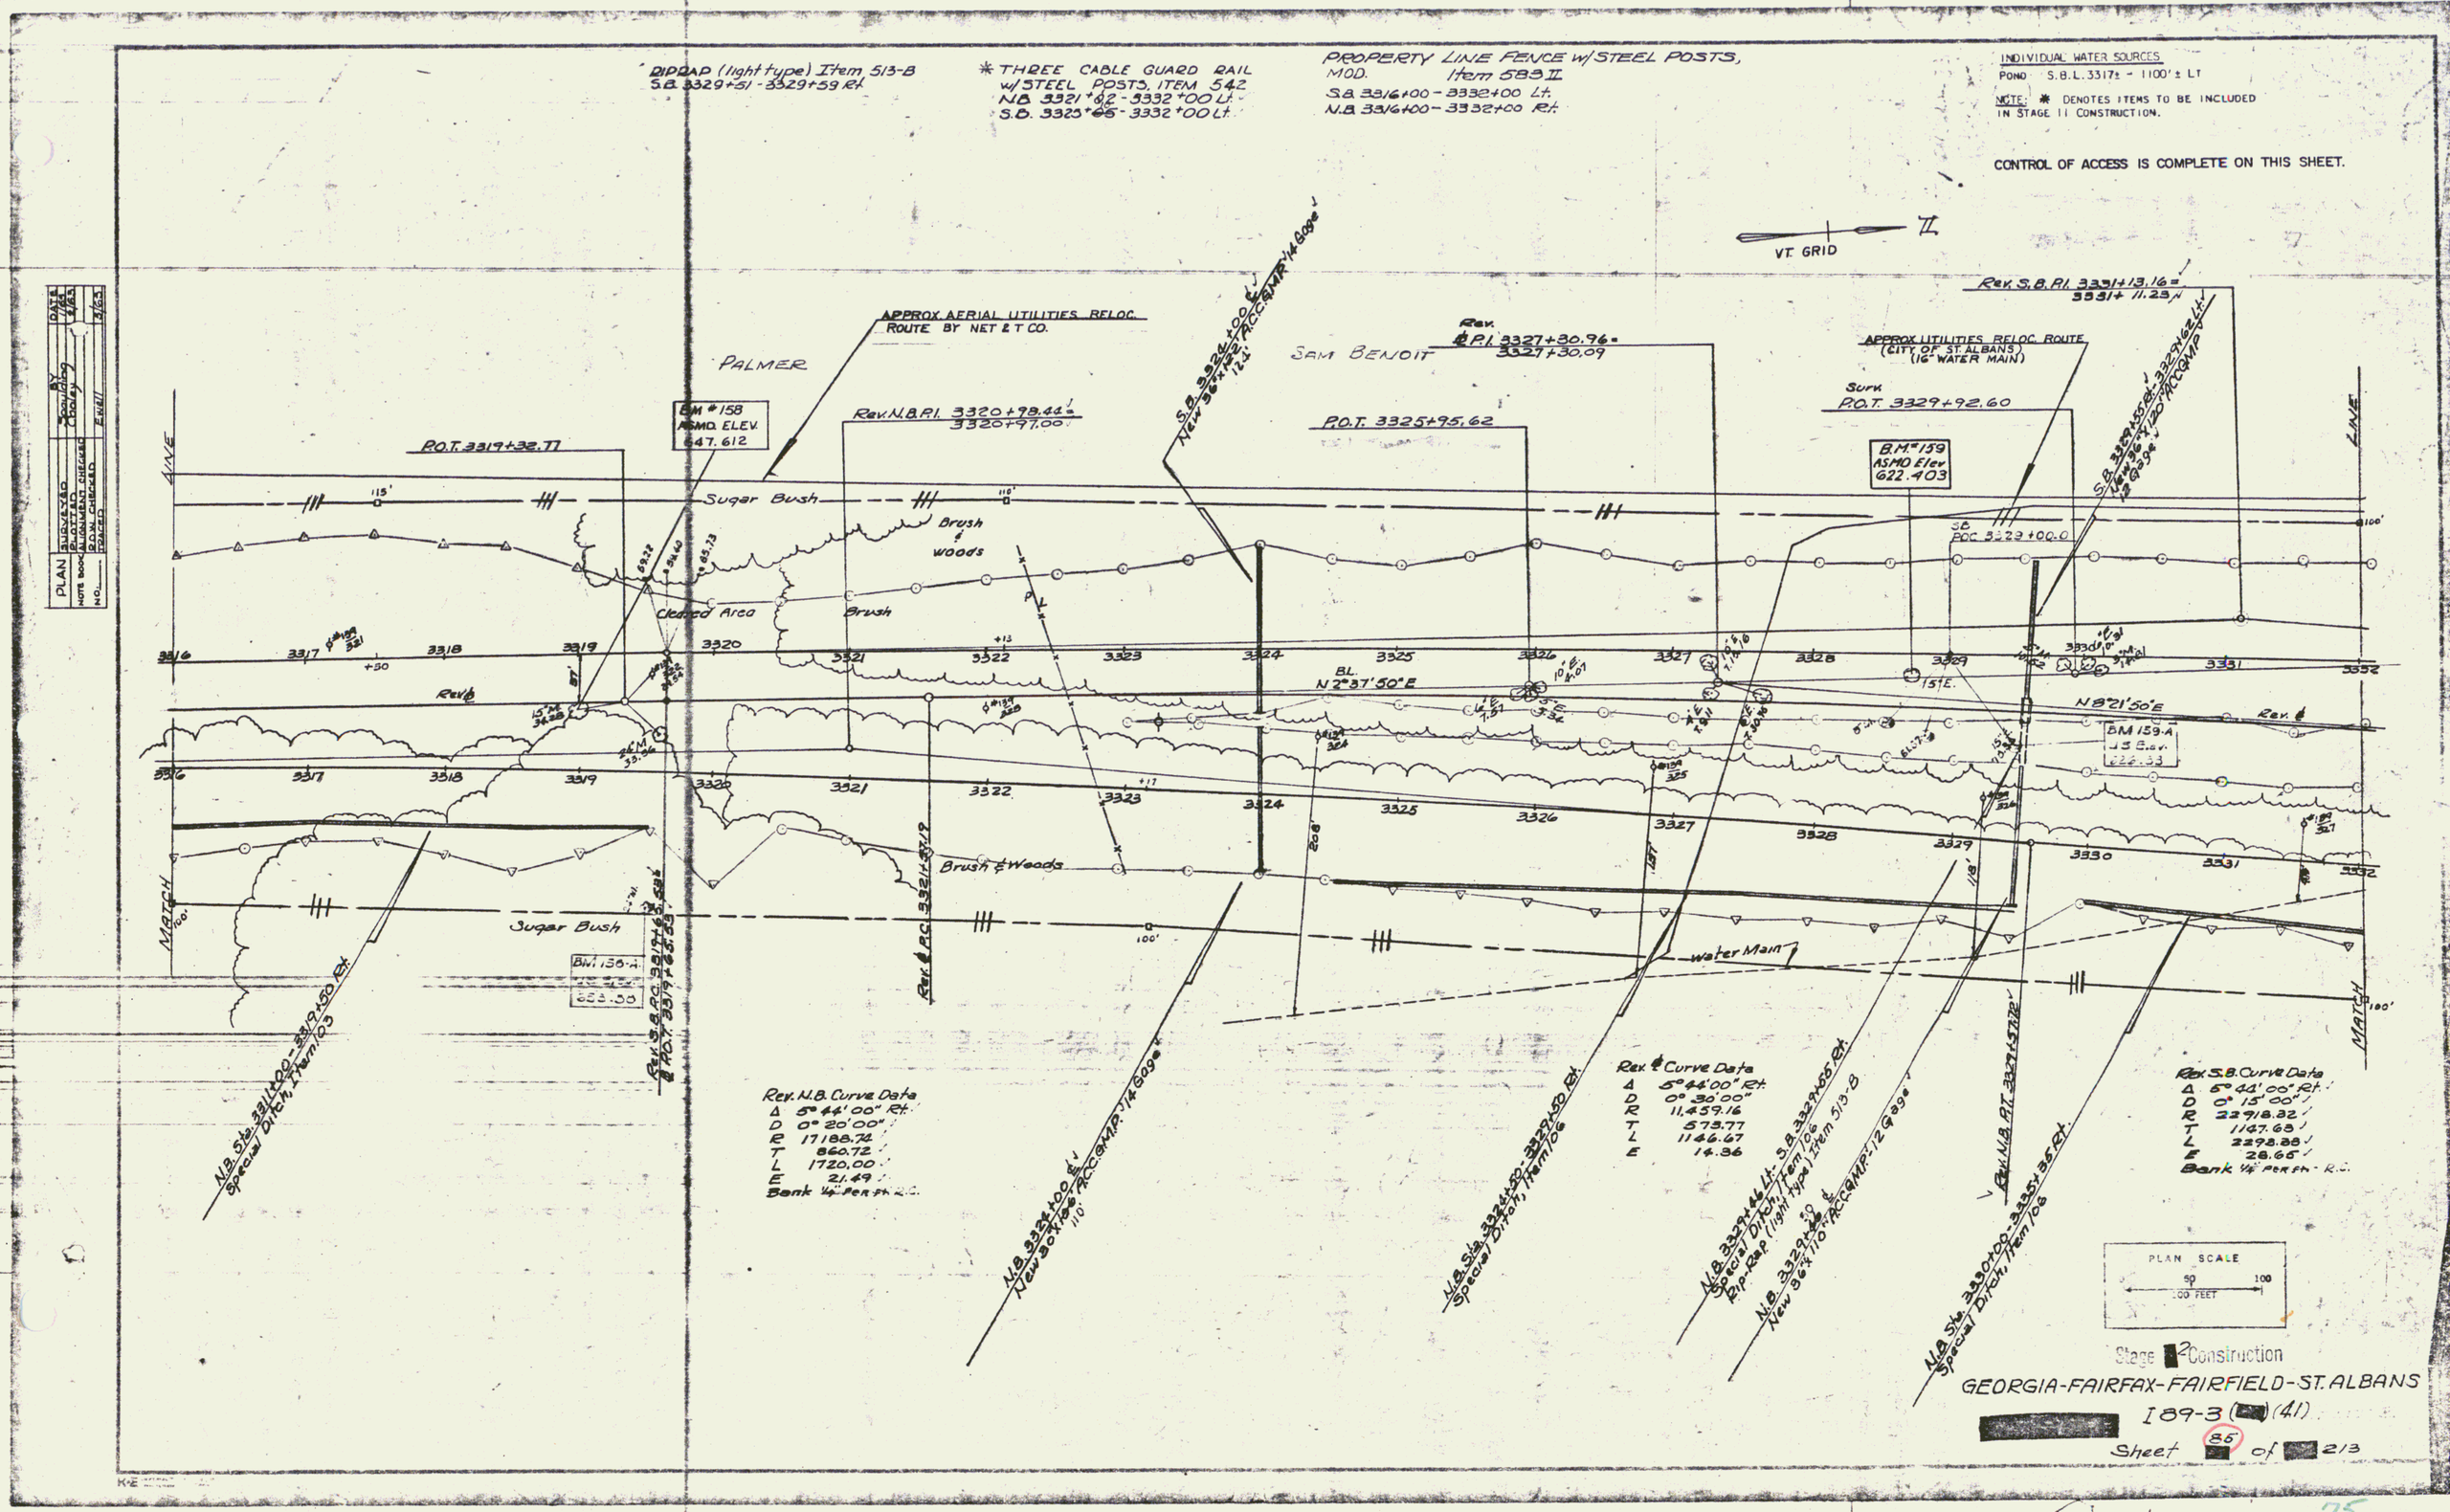
DIPRAP (light type) Item 513-B
S.B. 3329+51 - 3329+59 Rt.
* THREE CABLE GUARD RAIL w/STEEL POSTS, ITEM 542
N.B. 3321+82 - 3332+00 Lt.
S.B. 3325+66 - 3332+00 Lt.
PROPERTY LINE FENCE w/STEEL POSTS, MOD. Item 583 II
S.B. 3316+00 - 3332+00 Lt.
N.B. 3316+00 - 3332+00 Rt.
INDIVIDUAL WATER SOURCES
POND S.B.L. 3317± - 1100'± Lt
NOTE: * DENOTES ITEMS TO BE INCLUDED IN STAGE II CONSTRUCTION.
CONTROL OF ACCESS IS COMPLETE ON THIS SHEET.
VT. GRID
APPROX. AERIAL UTILITIES RELOC. ROUTE BY NET & T CO.
PALMER
SAM BENOIT
APPROX. UTILITIES RELOC. ROUTE (CITY OF ST. ALBANS) (16" WATER MAIN)
Rev. S.B. P.I. 3331+13.16 = 3331+11.23
Rev. N.B. P.I. 3320+98.44 = 3320+97.00
Rev. S.B. P.I. 3327+30.96 = 3327+30.09
P.O.T. 3319+32.77
P.O.T. 3325+95.62
P.O.T. 3329+92.60
B.M. #158 ASMO. ELEV. 647.612
B.M. #159 ASMO. Elev. 622.403
B.M. 159-A
B.M. 158-A
Sugar Bush
Brush & woods
Cleared Area
Brush
Brush & Woods
water Main
MATCH LINE
Rev. N.B. Curve Data
Δ 5° 44' 00" Rt.
D 0° 20' 00"
R 17188.72
T 860.72
L 1720.00
E 21.49
Rev. Curve Data
Δ 5° 44' 00" Rt.
D 0° 30' 00"
R 11,459.16
T 573.77
L 1146.67
E 14.36
Rev. S.B. Curve Data
Δ 5° 44' 00" Rt.
D 0° 15' 00"
R 22918.32
T 1147.68
L 2293.88
E 28.65
Bank 1/4" per ft. - R.C.
N.B. Sta. 3317+00 - 3317+50 Rt. Special Ditch, Item 103
N.B. 3321+00 ℄ New 30"x18" ACCGMP 1/4 Gage
N.B. Sta. 3324+50 - 3327+50 Rt. Special Ditch, Item 106
N.B. 3327+46 Lt. S.B. 3327+65 Rt. Special Ditch, Item 106 Rip-Rap (light type) Item 513-B
N.B. 3327+50 ℄ New 36"x110" ACCGMP 1/2 Gage
N.B. Sta. 3330+00 - 3335+35 Rt. Special Ditch, Item 106
PLAN SCALE 50 100 100 FEET
Stage 2 Construction
GEORGIA-FAIRFAX-FAIRFIELD-ST. ALBANS
I 89-3 (41)
Sheet 85 of 213
PLAN
NOTE BOOK NO.
SURVEYED P.O.T.&D.
DRAWN
R.D.N. CHECKED
TRACED
BY
DATE