

Prop. Item 513-B
 3395+95 - 3396+05 28-ft
PROPERTY LINE FENCE w/ STEEL POSTS MOD. ITEM 583-II
 S.B. 3396+00 - 3412+00 Lt.
 N.B. 3396+00 - 3412+00 Rt.

INDIVIDUAL WATER SOURCES

DUG SPRING	N.B.L. 3400+80	- 475' RT
DUG POND	N.B.L. 3403+50	- 500' RT
DUG SPRING	N.B.L. 3403+50	- 600' RT
DUG POND	N.B.L. 3405	- 35' RT
DUG SPRING	S.B.L. 3408+00	- 215' LT

*** THREE CABLE GUARD RAIL w/ LIGHT STEEL POSTS, item 538**
 NB 3396+00 Lt. - NB 3401+88 Lt.
 NB 3402+28 Lt. - NB 3412+68 Lt.
 SB 3396+00 Lt. - SB 3404+36 Lt.
 Ramp C' 15+55' - 23+28 Rt.

BIRMINGHAM CONCRETE SURFACE FOR GUTTERS AND TRAFFIC ISLANDS, ITEM 554 Mod.
 3414+36 NB Lt. - 3412+15 SB Lt.
APPROX AERIAL UTILITIES RELOC. ROUTE BY CVPS. CORP (TRANSMISSION)
 NOTE: * DENOTES ITEMS TO BE INCLUDED IN STAGE II CONSTRUCTION.


Pasture
TREATED TIMBER TIE, ITEM 558
*** BIFUMINOUS CONCRETE CURB**
ITEM 555 TYPE I
 RAMP C' 15+50 - 17+50 Rt.
*** JUTE MATTING ITEM 623**
 Ramp C' 15+50 - 16+50 Median

Pipe from Spring to farm house

CONTROL OF ACCESS IS COMPLETE ON THIS SHEET.

B.M. #169
 ASMD Elev
 549.33


PLAN	DATE	BY
SUBMITTED		
APPROVED		
REVISIONS		

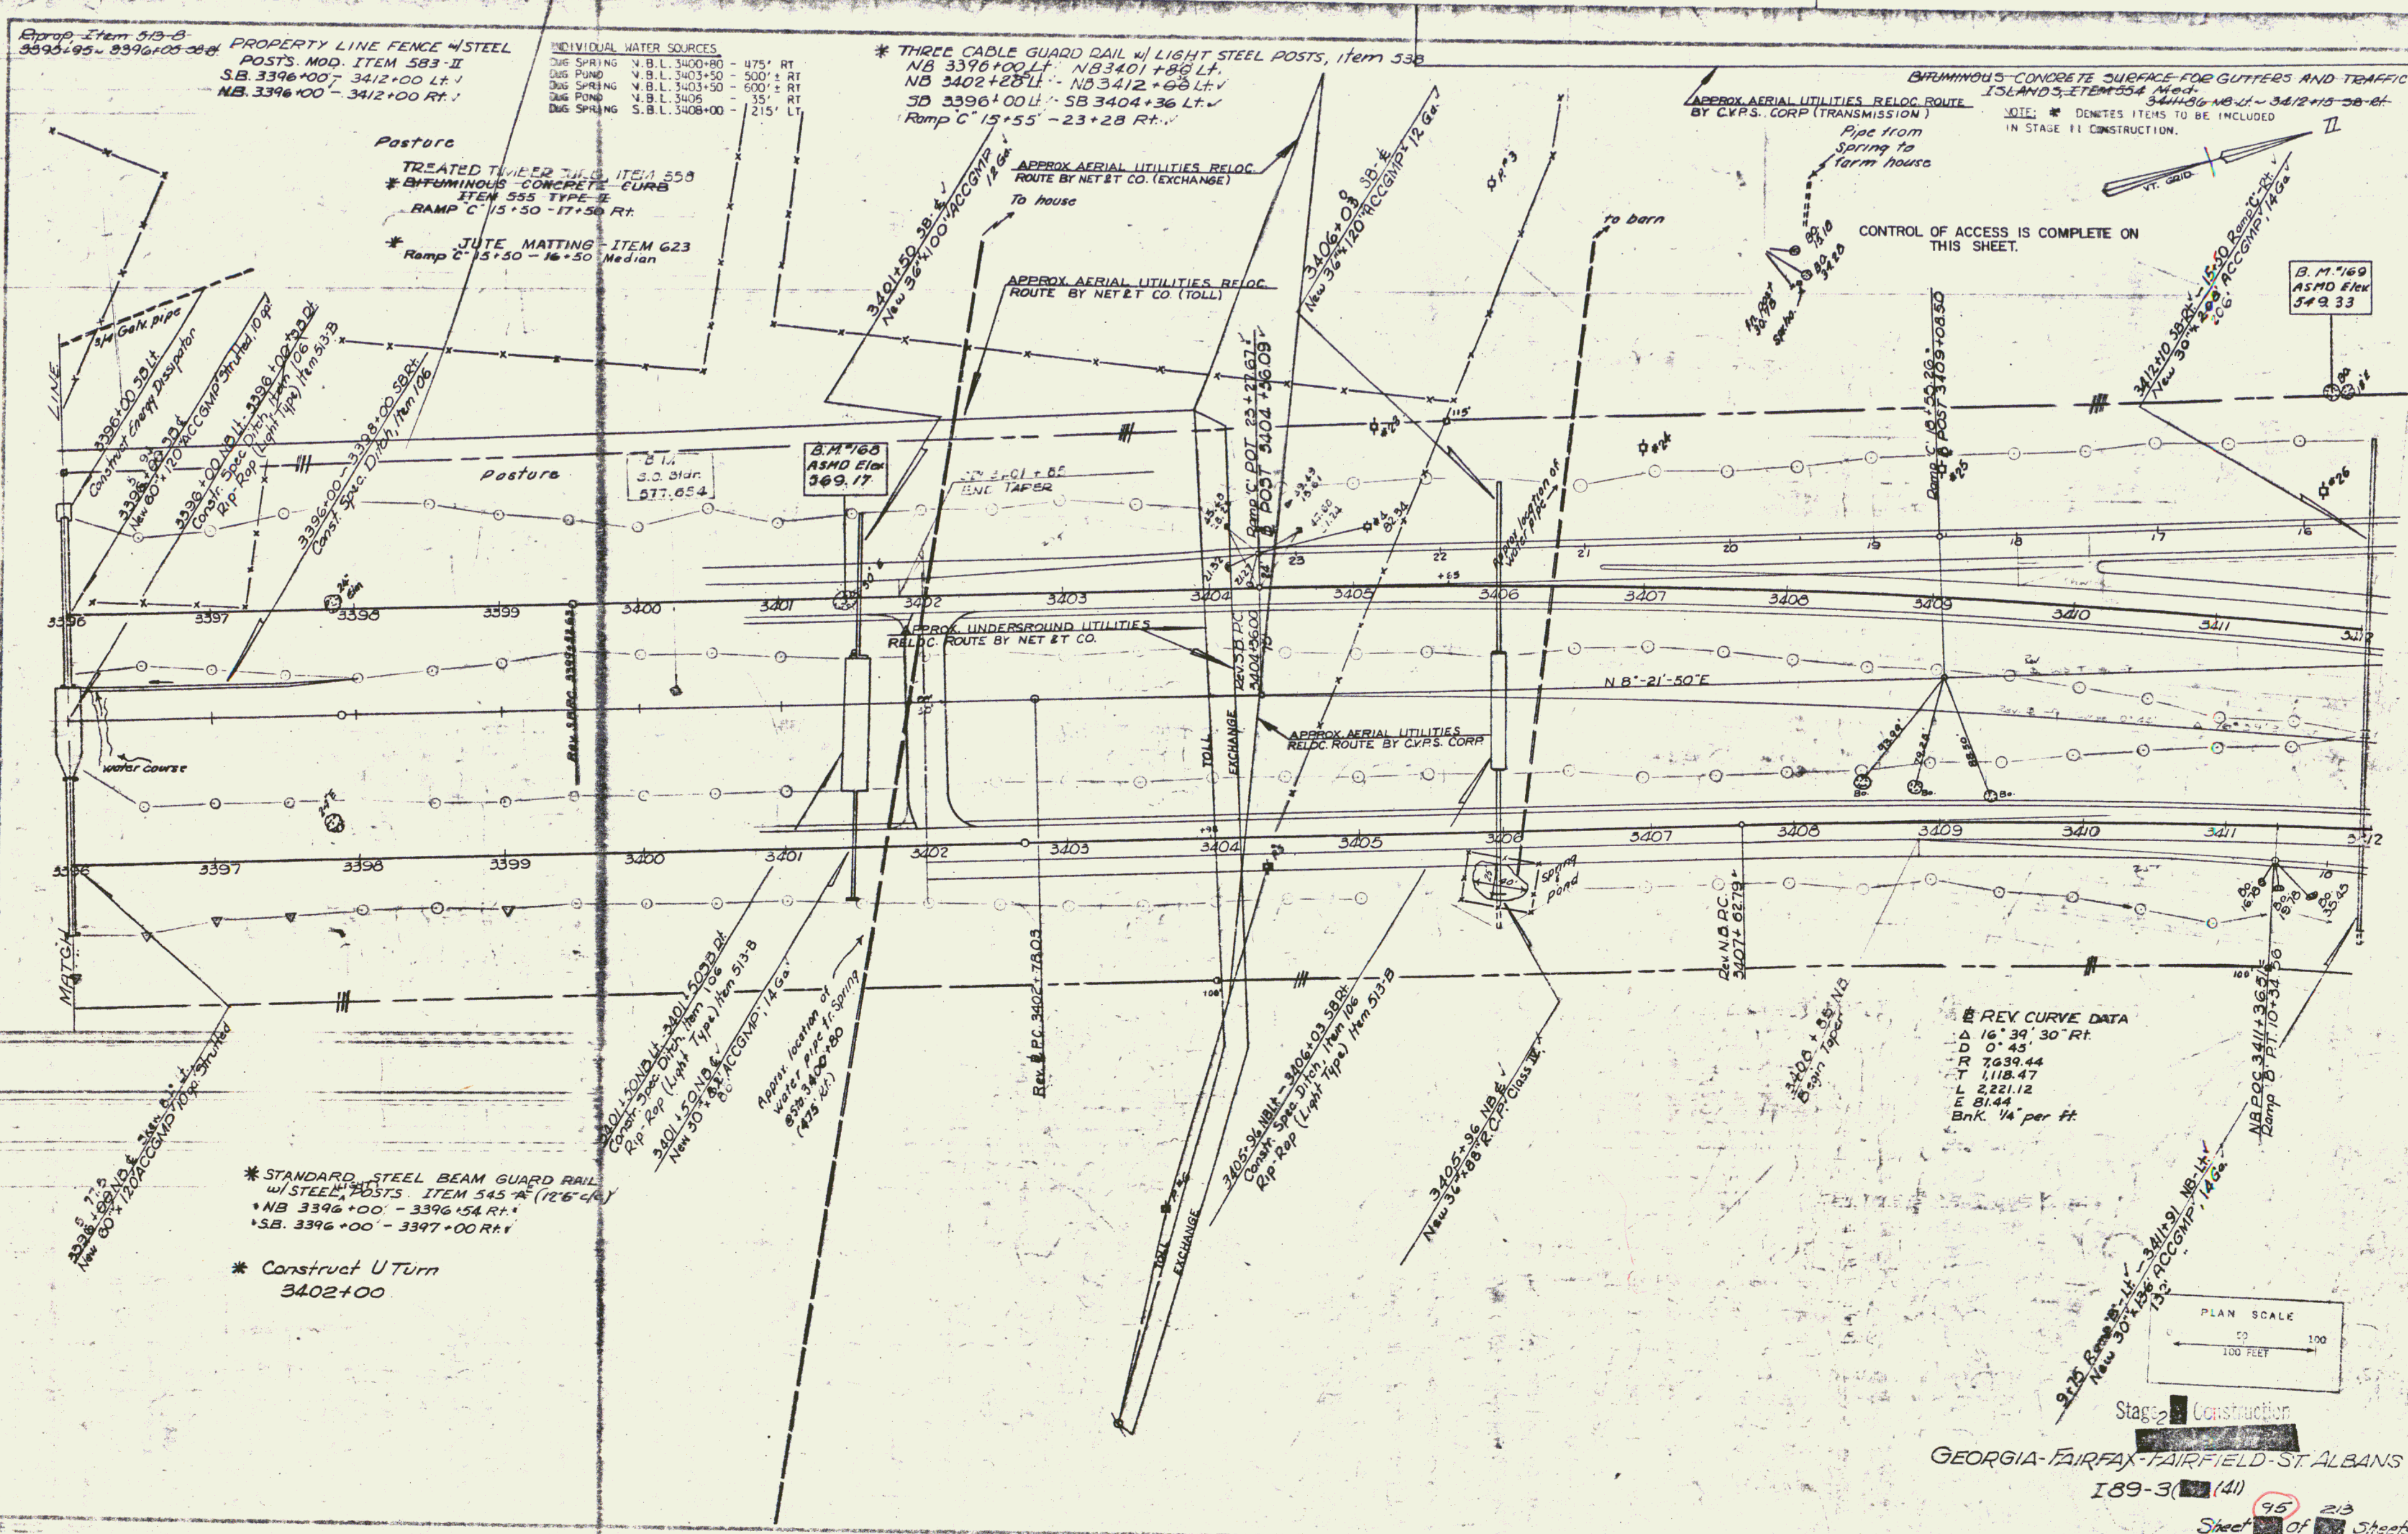

*** STANDARD STEEL BEAM GUARD RAIL w/ STEEL POSTS, ITEM 545-A (12'6" dia)**
 NB 3396+00 - 3396+54 Rt.
 SB 3396+00 - 3397+00 Rt.

*** Construct U Turn 3402+00**

REY CURVE DATA
 Δ 16° 39' 30" Rt.
 D 0' 45"
 R 7639.44
 T 1118.47
 L 2221.12
 E 81.44'
 Bnk. 14 per ft.

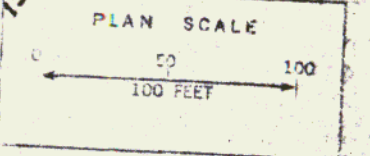

Stage 2 Construction

GEORGIA-FAIRFAX-FAIRFIELD-ST. ALBANS

189-3 (41)

95 of 213 Sheets