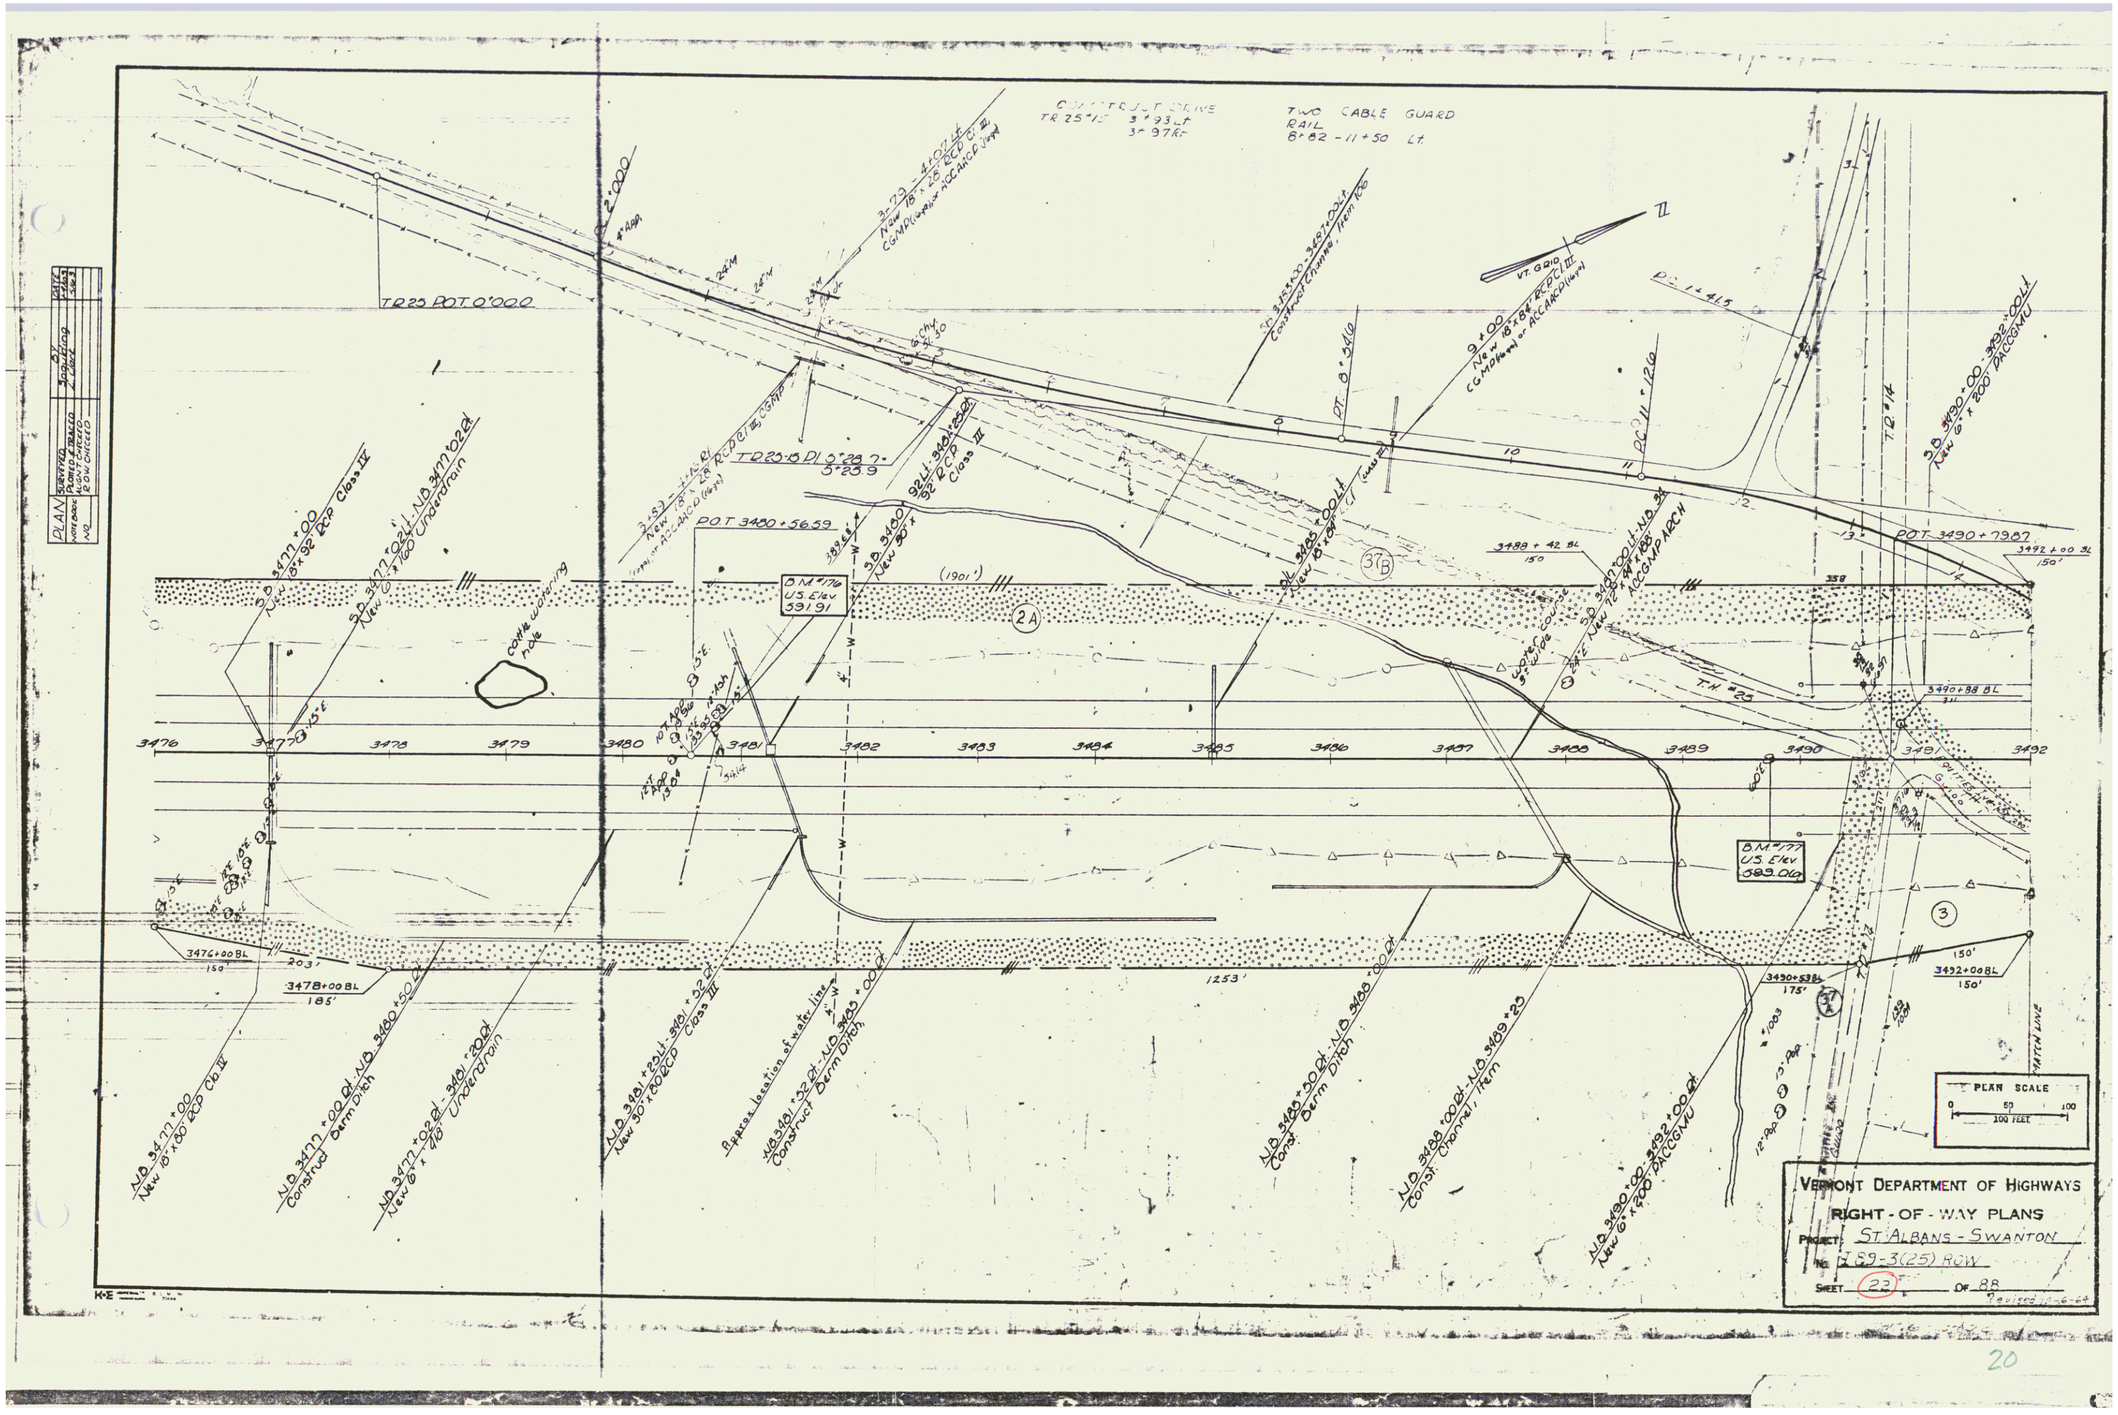
TR 25 POT. 0+000
TWO CABLE GUARD RAIL
8+82 - 11+50 Lt.
POT 3480+56.59
POT 3490+79.87
BM #77
US Elev
589.06
PLAN SCALE
0 50 100
100 FEET
VERMONT DEPARTMENT OF HIGHWAYS
RIGHT-OF-WAY PLANS
PROJECT ST. ALBANS - SWANTON
NO. I-89-3(25) ROW
Revised 10-6-64
PLAN
SURVEYED
PLOTTED
DRAWN
CHECKED
NO.
DATE
1-1-64
3-20-64
4-1-64
5-8-64
K+E