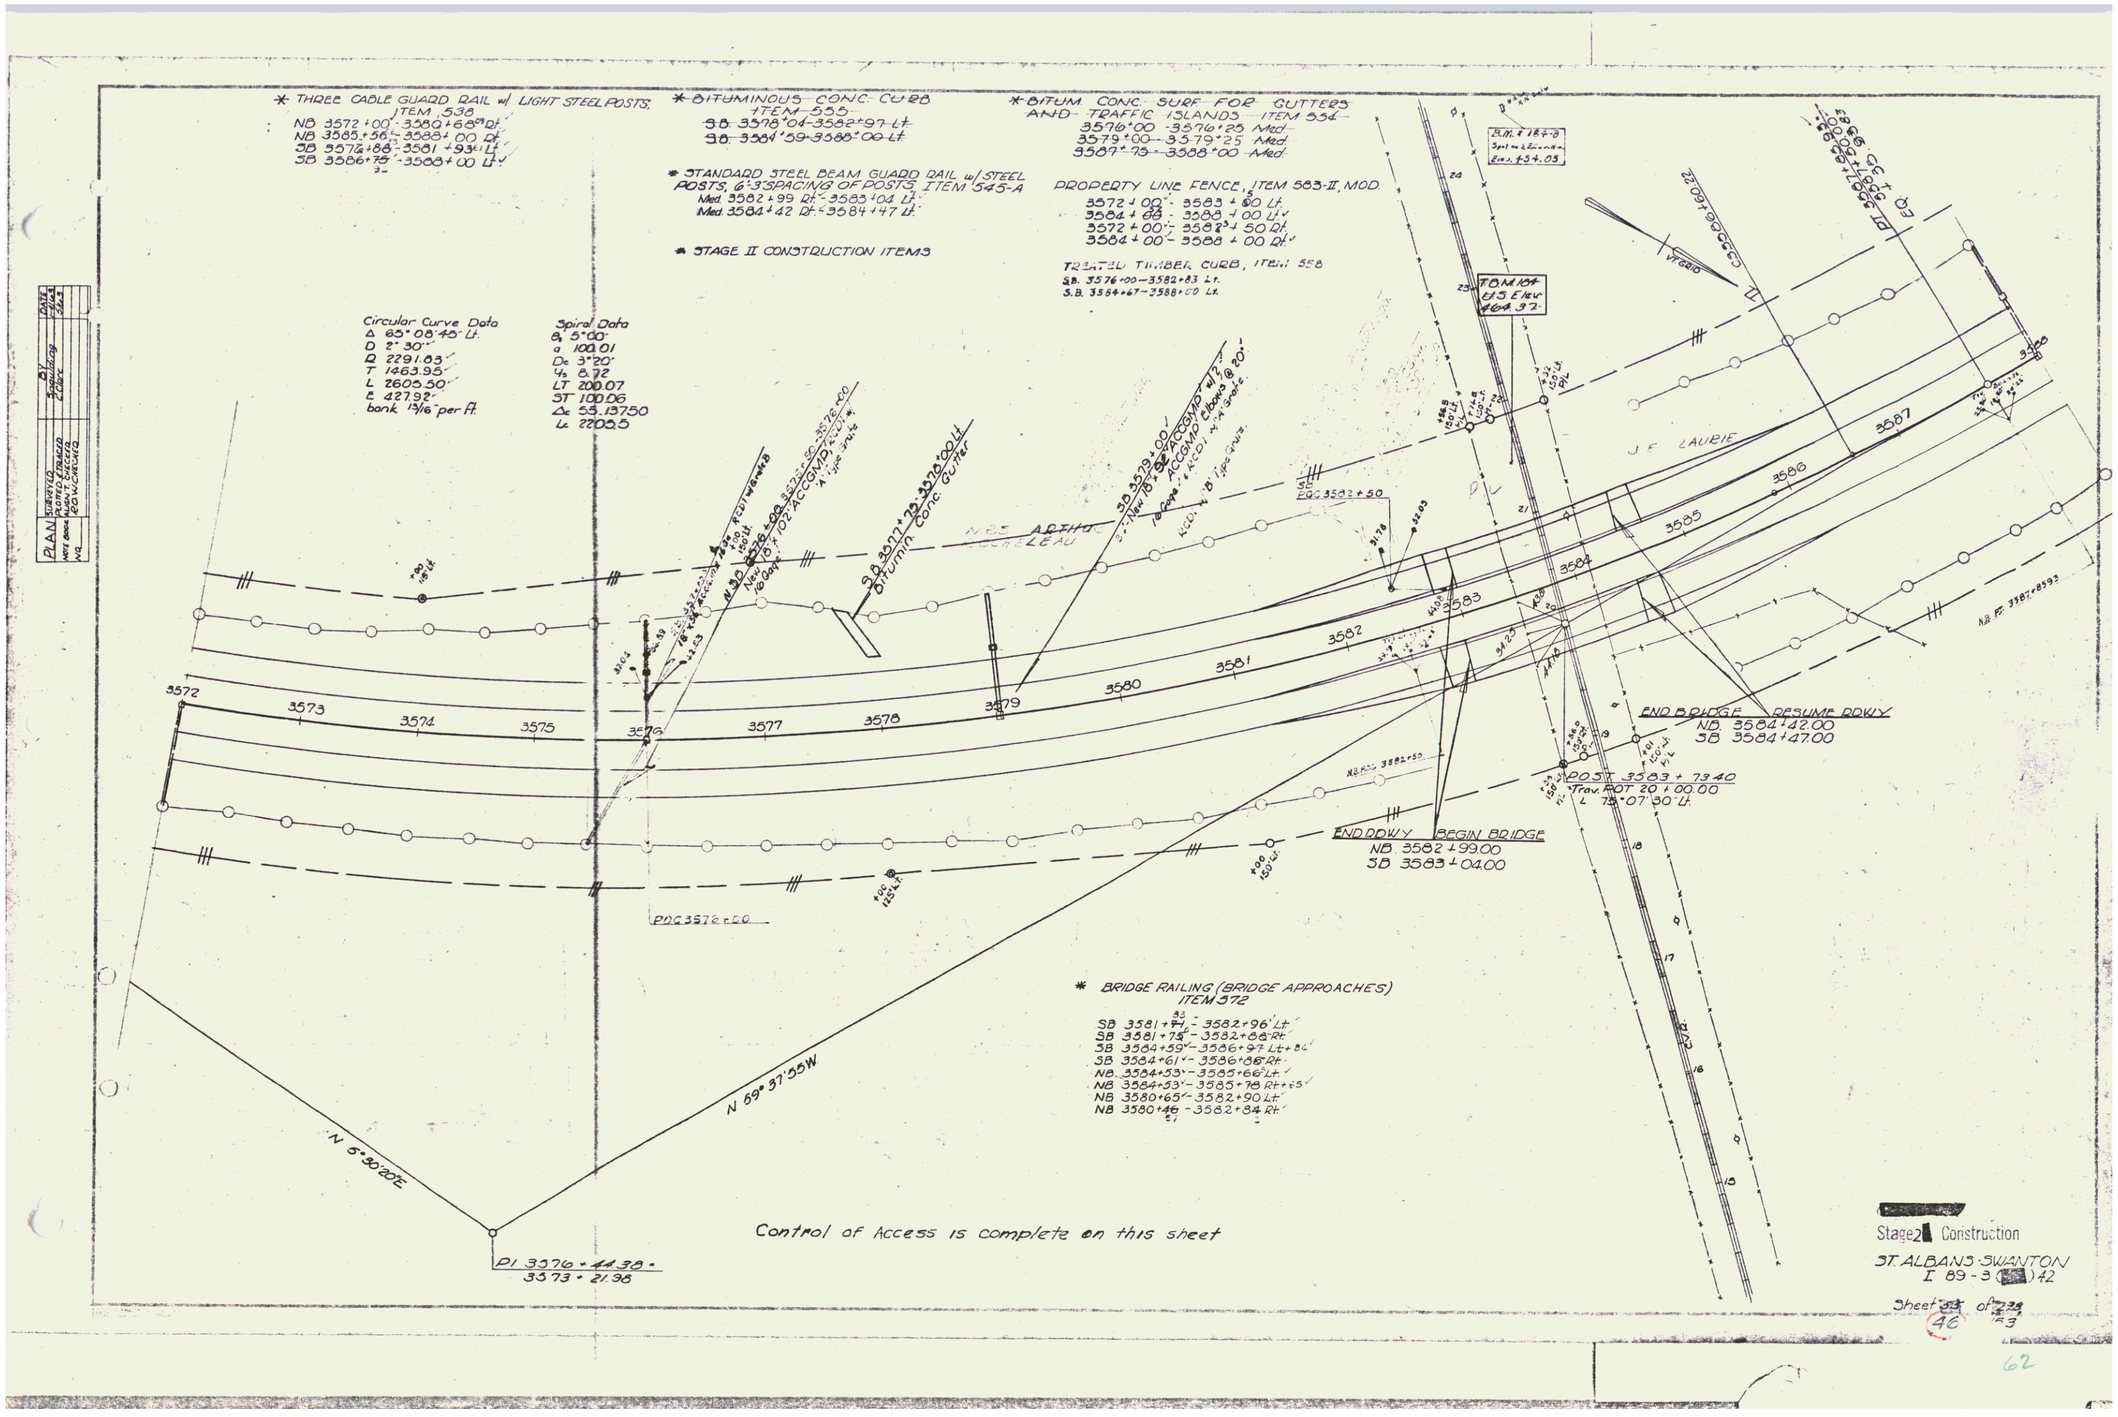
* THREE CABLE GUARD RAIL w/ LIGHT STEEL POSTS, ITEM 538
NB 3572+00 - 3580+68.89 Rt.
NB 3583+56 - 3588+00 Rt.
SB 3576+66 - 3581+93.41 Lt.
SB 3586+75 - 3588+00 Lt.
* BITUMINOUS CONC. CU 28 ITEM 555
S.B. 3578+04 - 3582+97 Lt.
S.B. 3584+09 - 3588+00 Lt.
* BITUM. CONC. SURF. FOR GUTTERS AND TRAFFIC ISLANDS ITEM 534
3576+00 - 3576+25 Med.
3579+00 - 3579+25 Med.
3587+75 - 3588+00 Med.
* STANDARD STEEL BEAM GUARD RAIL w/ STEEL POSTS, 6'-3" SPACING OF POSTS, ITEM 545-A
Med. 3582+99 Rt. - 3583+04 Lt.
Med. 3584+42 Rt. - 3584+47 Lt.
* STAGE II CONSTRUCTION ITEMS
PROPERTY LINE FENCE, ITEM 583-II, MOD.
3572+00 - 3583+60 Lt.
3584+83 - 3588+00 Lt.
3572+00 - 3582+50 Rt.
3584+00 - 3588+00 Rt.
TREATED TIMBER CURB, ITEM 558
S.B. 3576+00 - 3582+83 Lt.
S.B. 3584+67 - 3588+00 Lt.
Circular Curve Data
Δ 65°08'45" Lt.
D 2°30'
R 2291.83
T 1483.95
L 2605.50
E 427.92
bank 13/16" per ft.
Spiral Data
θs 5°00'
a 100.01
Ds 3°20'
ys 8.72
LT 200.07
ST 100.06
Δc 55.13750
Lc 2203.5
S.B. 3577+72 - 3577+00 Lt.
Bituminous Conc. Gutter
S.B. 3579+00
10 Bars
ACCGMD Elbows @ 20'
KCDI w/ 18" Type Grate
POC 3572+00
POC 3582+50
END BRIDGE RESUME RDWY
NB 3584+42.00
SB 3584+47.00
POST 3583+73.40
Trav. ROT 20+00.00
L 75°07'30" Lt.
END RDWY BEGIN BRIDGE
NB 3582+99.00
SB 3583+04.00
POC 3576+00
PI 3576+44.38
3573+21.98
N 5°30'20" E
N 69°37'35" W
* BRIDGE RAILING (BRIDGE APPROACHES) ITEM 372
SB 3581+71.43 - 3582+96 Lt.
SB 3581+75.6 - 3582+88 Rt.
SB 3584+59 - 3586+97 Lt.
SB 3584+61 - 3586+88 Rt.
NB 3584+53 - 3585+66 Lt.
NB 3584+53 - 3585+78 Rt.
NB 3580+65 - 3582+90 Lt.
NB 3580+46.57 - 3582+84 Rt.
Control of Access is complete on this sheet
J. F. LAURIE
3572
3573
3574
3575
3576
3577
3578
3579
3580
3581
3582
3583
3584
3585
3586
3587
Stage 2 Construction
ST. ALBANS-SWANTON
I 89-3 ( ) 42
Sheet 46 of 73

62