


PLAN  
 DATE  
 DRAWN BY  
 CHECKED BY  
 NO.

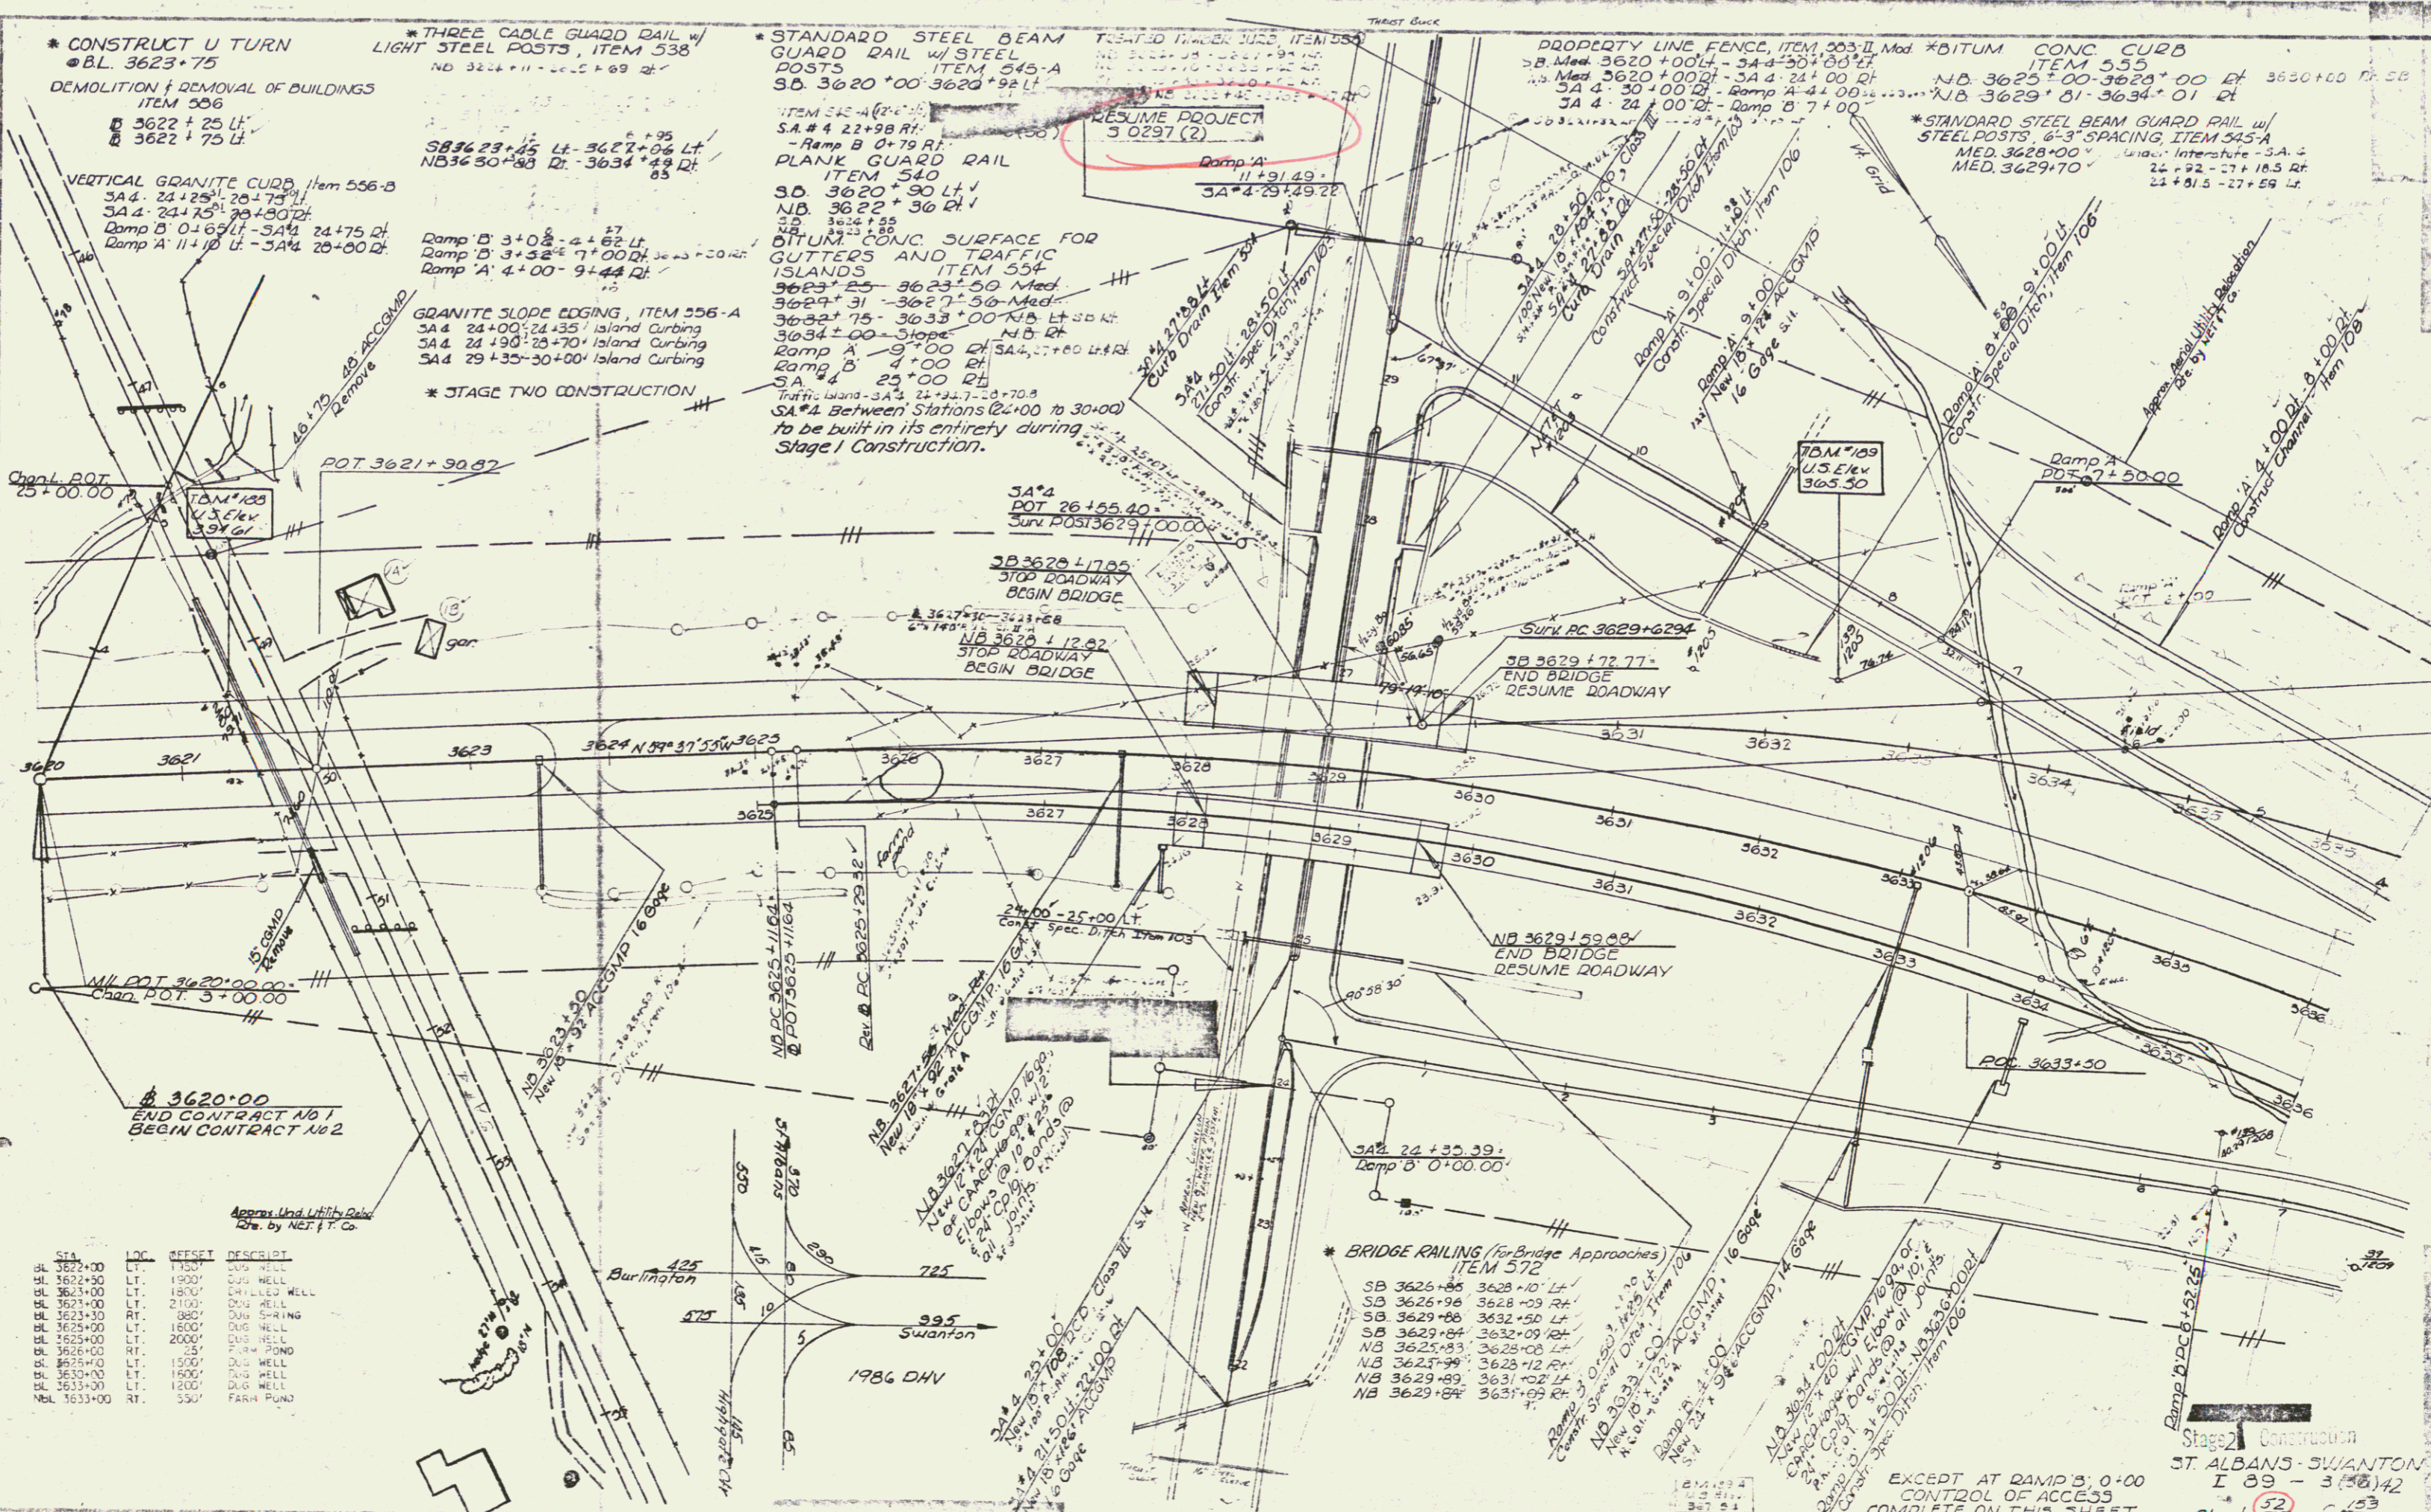

Approx. Und. Utility Data  
 Data by NET, I. T. Co.


ST. ALBANS - SWANTON  
 I 89 - 3 (36)42  
