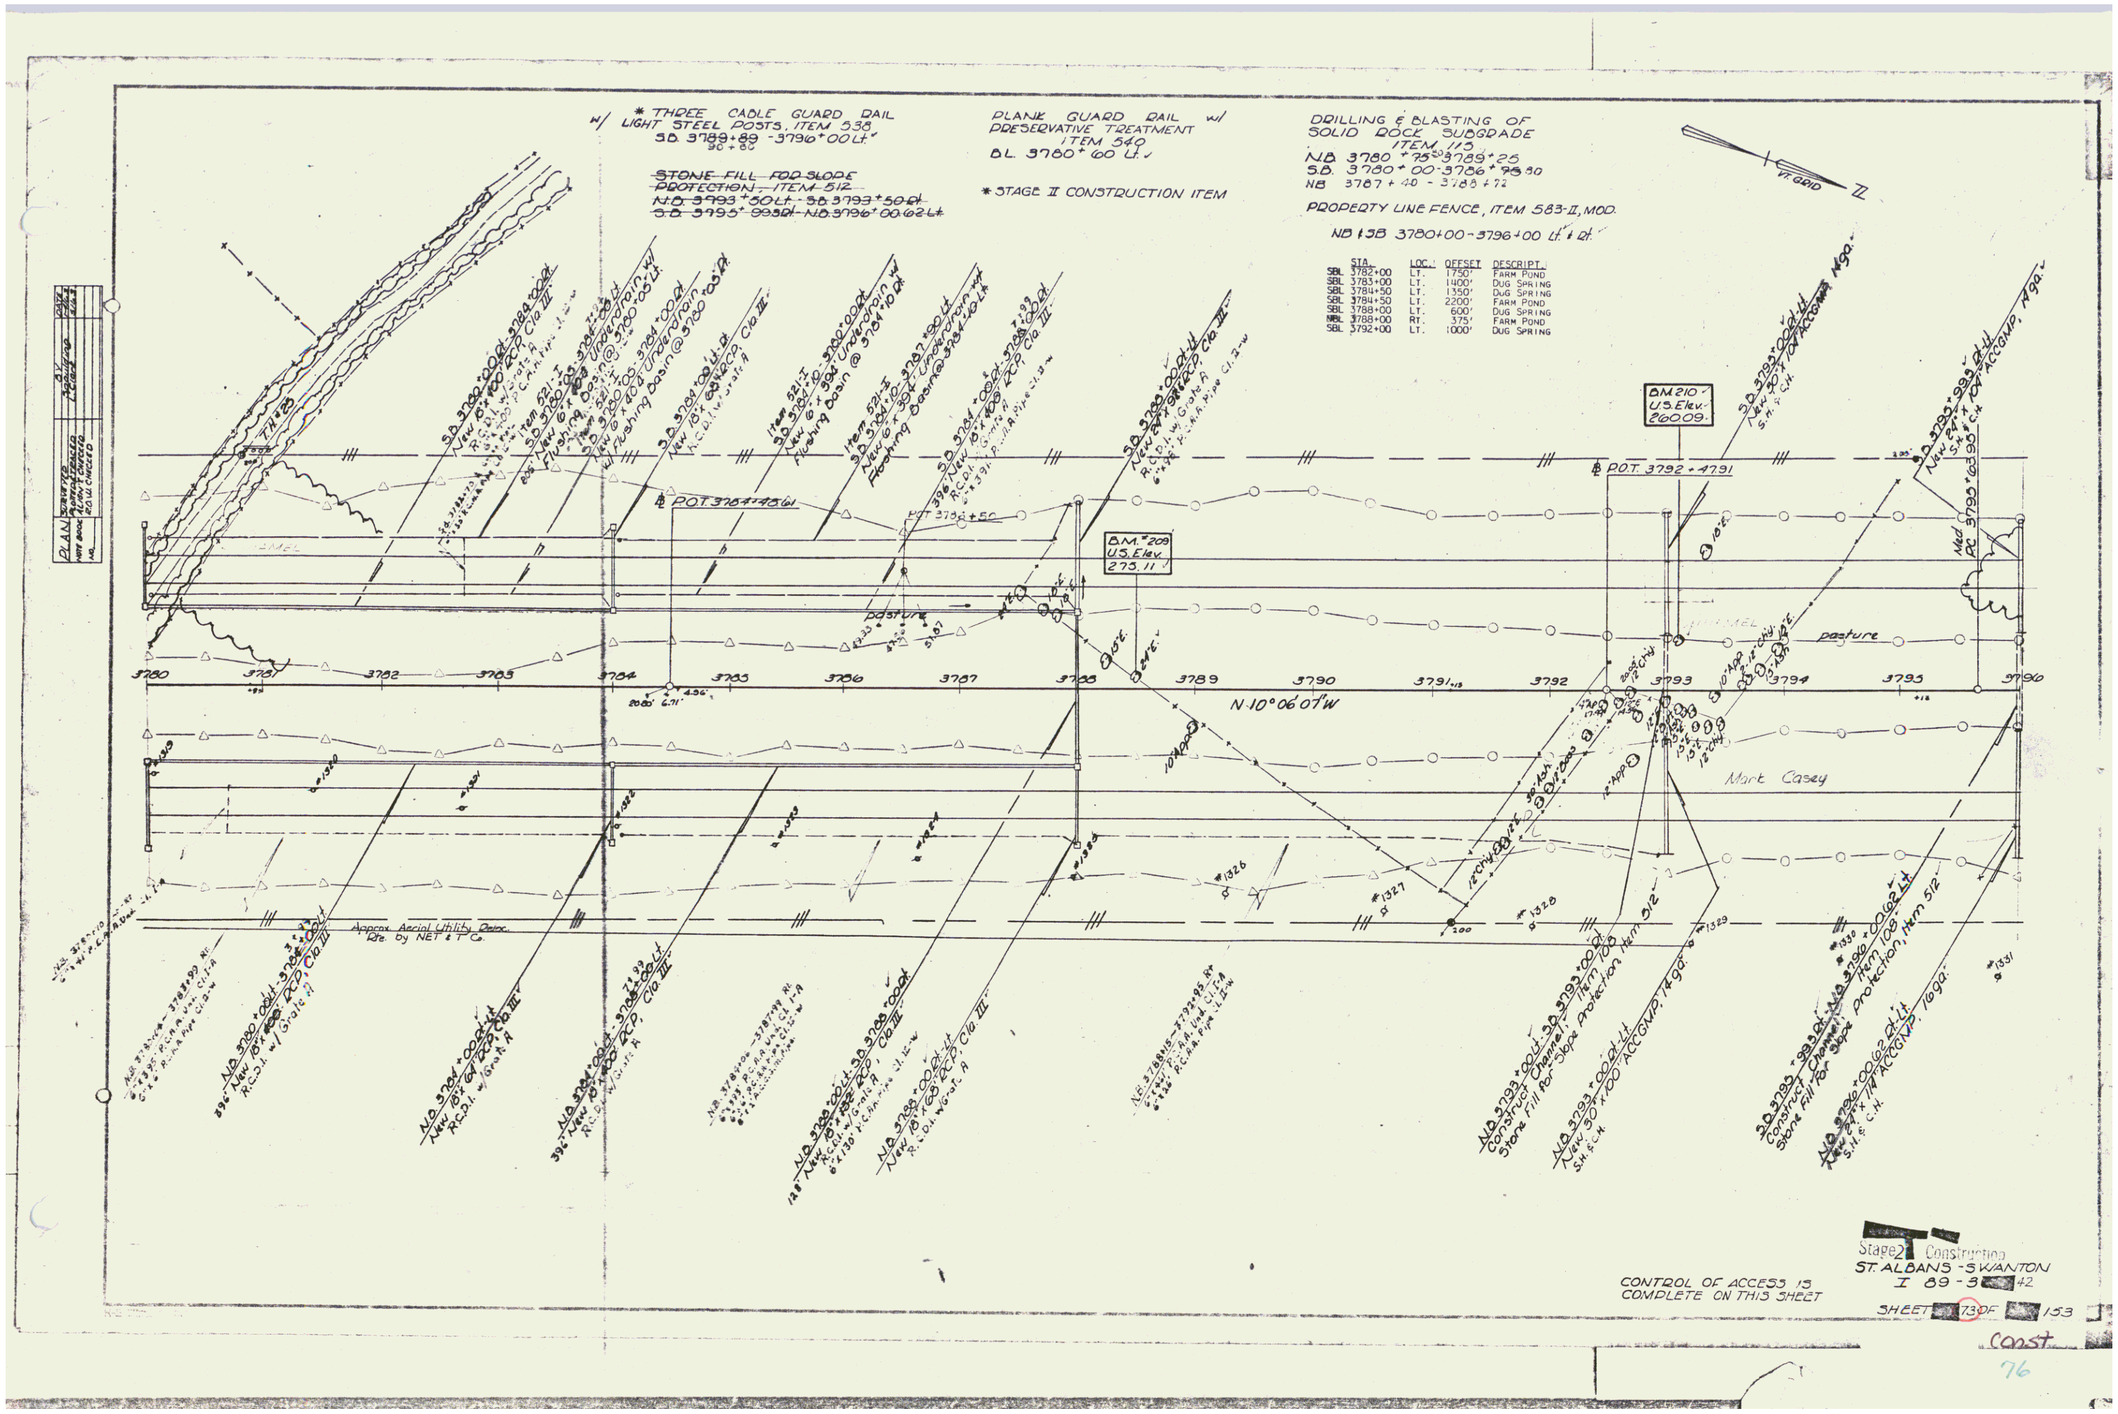

* THREE CABLE GUARD RAIL w/ LIGHT STEEL POSTS, ITEM 538
S.B. 3789+89 - 3796+00 Lt.
STONE FILL FOR SLOPE PROTECTION, ITEM 512
N.B. 3793+50 Lt. - S.B. 3793+50 Rt.
S.B. 3795+99.3 Rt. - N.B. 3796+00.62 Lt.
PLANK GUARD RAIL w/ PRESERVATIVE TREATMENT ITEM 540
B.L. 3780+60 Lt.
* STAGE II CONSTRUCTION ITEM
DRILLING & BLASTING OF SOLID ROCK SUBGRADE ITEM 115
N.B. 3780+75 - 3789+25
S.B. 3780+00 - 3786+80
NB 3787+40 - 3788+72
PROPERTY LINE FENCE, ITEM 583-II, MOD.
NB & SB 3780+00 - 3796+00 Lt. & Rt.
STA. LOC. OFFSET DESCRIPT.
SBL 3782+00 LT. 1750' FARM POND
SBL 3783+00 LT. 1400' DUG SPRING
SBL 3784+50 LT. 1350' DUG SPRING
SBL 3784+50 LT. 2200' FARM POND
SBL 3788+00 LT. 600' DUG SPRING
NBL 3788+00 RT. 375' FARM POND
SBL 3792+00 LT. 1000' DUG SPRING
VT. GRID
BM 210 U.S. Elev. 260.09
BM 209 U.S. Elev. 275.11
P.O.T. 3784+48.61
P.O.T. 3792+47.91
N 10°06'07" W
pasture
Mark Casey
Approx. Aerial Utility Detoc. Rte. by NET & T Co.
CONTROL OF ACCESS IS COMPLETE ON THIS SHEET
Stage 2 Construction
ST. ALBANS - SWANTON
I 89-3 42
SHEET 73 OF 153
Const.
76