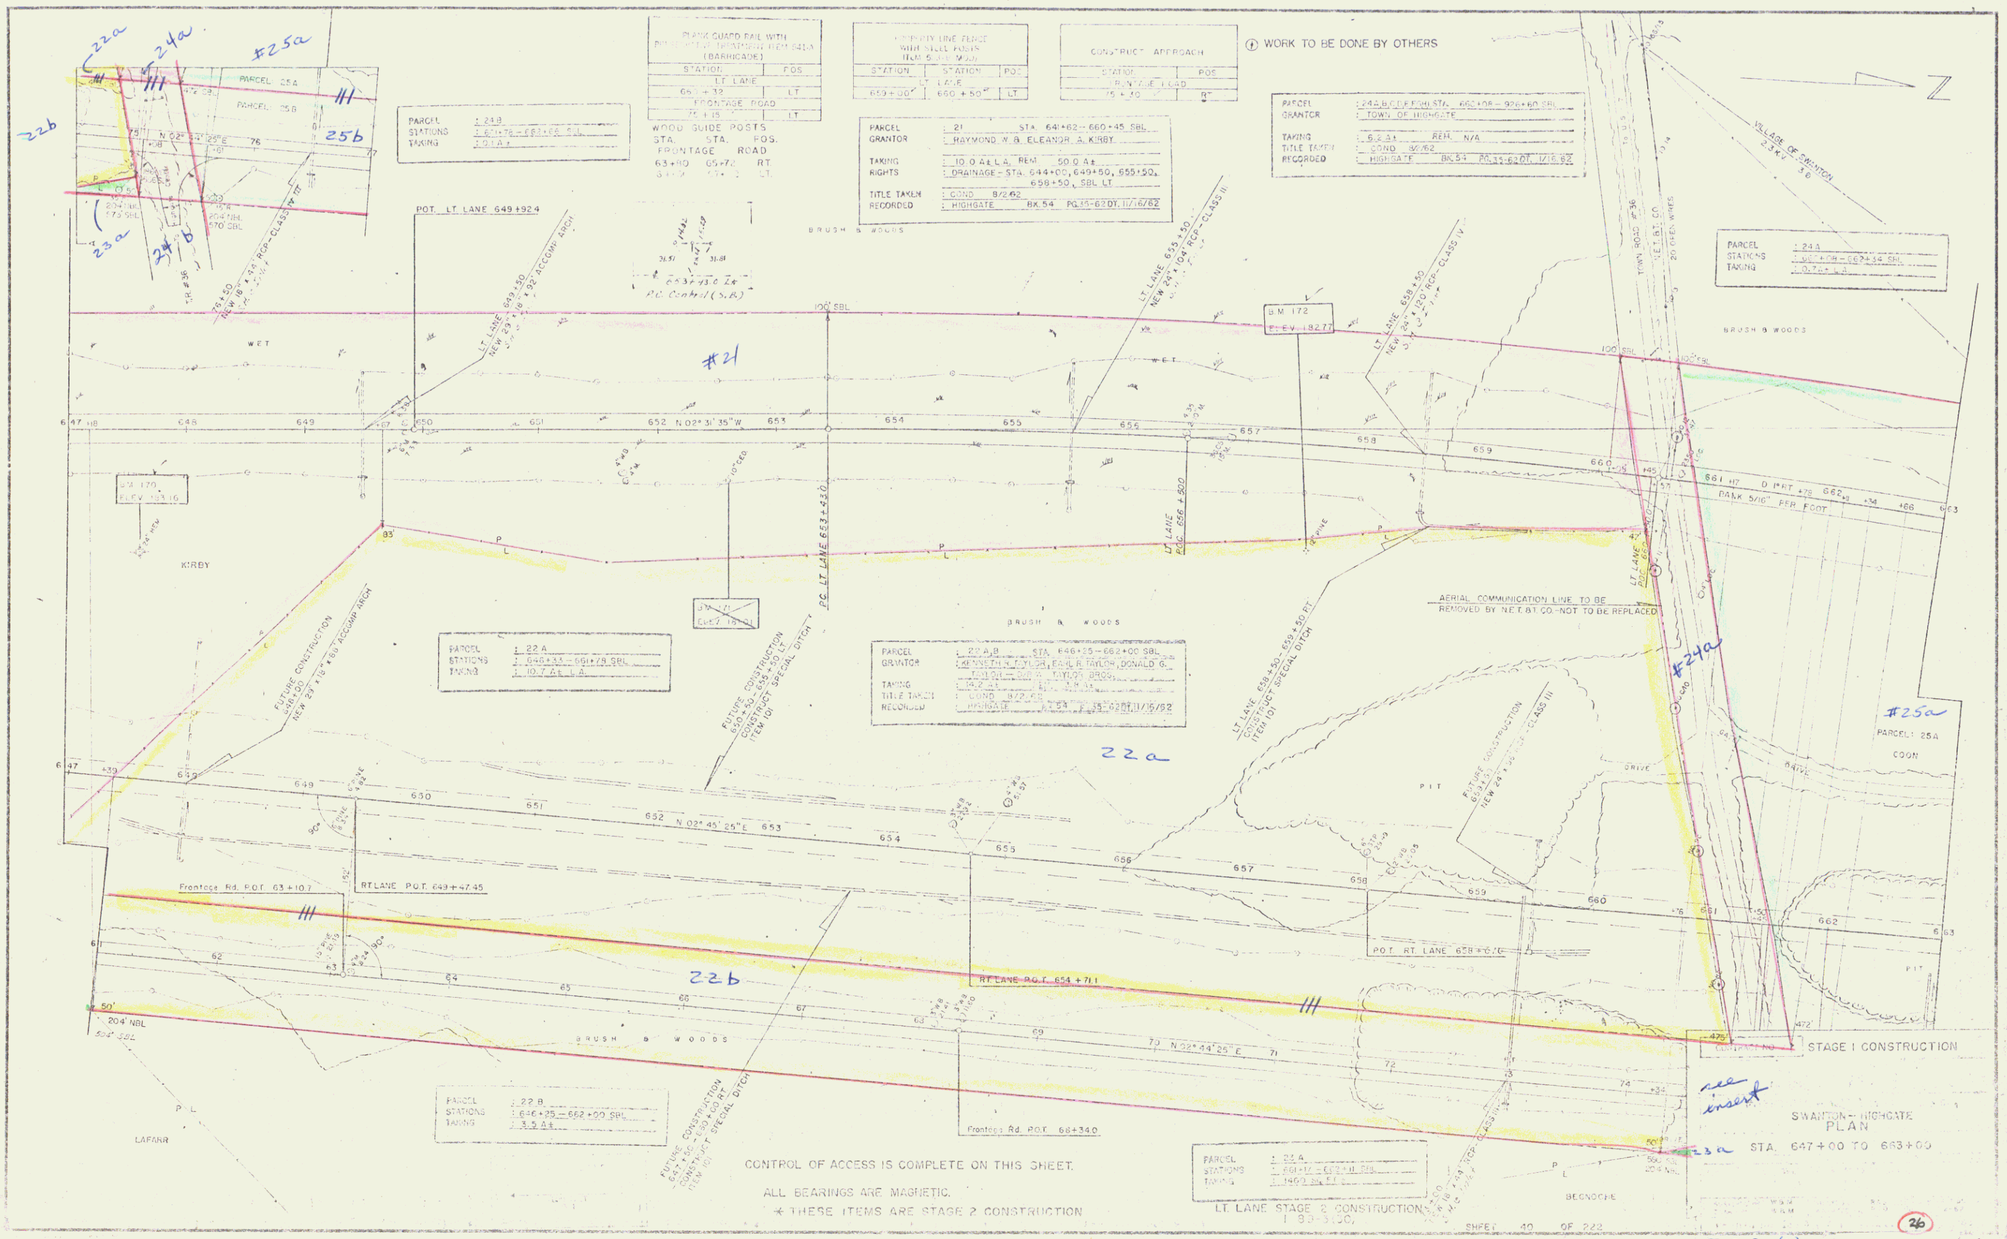
WORK TO BE DONE BY OTHERS
PARCEL 24B
STATIONS 621+78 - 663+68 SBL
TAKING 3.01 Ac
PARCEL 21
GRANTOR HAYMOND W. & ELEANOR A. KIRBY
TAKING 10.0 Ac L.A. REM. 50.0 Ac
RIGHTS DRAINAGE - STA. 644+00, 649+50, 655+50, 658+50, SBL LT
TITLE TAKEN COND 8/2/62
RECORDED HIGHGATE BK 54 PG 35-62 DT. 11/16/62
PARCEL 24A, B, C, E, F, H, I STA. 662+08 - 928+80 SBL
GRANTOR TOWN OF HIGHGATE
TAKING 6.2 Ac REM. N/A
TITLE TAKEN COND 8/2/62
RECORDED HIGHGATE BK 54 PG 35-62 DT. 11/16/62
PARCEL 24A
STATIONS 662+08 - 663+46 SBL
TAKING 0.74 Ac
PARCEL 22A
STATIONS 646+33 - 661+78 SBL
TAKING 10.7 Ac L.A.
PARCEL 22A, B STA. 646+25 - 662+00 SBL
GRANTOR KENNETH J. TAYLOR, EARL R. TAYLOR, DONALD G. TAYLOR - DBA TAYLOR BROS.
TAKING 14.2 Ac
TITLE TAKEN COND 8/2/62
RECORDED HIGHGATE BK 54 PG 35-62 DT. 11/16/62
PARCEL 22B
STATIONS 646+25 - 662+00 SBL
TAKING 3.5 Ac
PARCEL 22A
STATIONS 661+78 - 663+46 SBL
TAKING 1460 Sq. Ft.
BLANK GUARD RAIL WITH REFLECTORIZED BARRICADE, ITEM 641-A (BARRICADE)
STATION FOS. LT LANE
64+32 LT
FRONTAGE ROAD
75+15 LT
WOOD GUIDE POSTS
STA. STA. FOS.
FRONTAGE ROAD
63+80 65+72 RT
CHAIN LINK FENCE WITH STEEL POSTS ITEM 6-[illegible] WOOD
STATION FOS. LT LANE
659+00 LT
660+50 LT
CONSTRUCT APPROACH
STATION FOS.
RUNTAKE ROAD
75+30 8"
POT. LT LANE 649+924
RT LANE P.O.T. 649+47.45
Frontage Rd. P.O.T. 63+10.7
RT LANE P.O.T. 654+71.1
P.O.T. RT. LANE 658+67.6
Frontage Rd. P.O.T. 68+34.0
LT. LANE 653+50 NEW 24" x 104' RCP - CLASS II
LT. LANE 655+50 NEW 24" x 120' RCP - CLASS II
LT. LANE 658+50 NEW 24" x 120' RCP - CLASS IV
LT. LANE 656+80 NEW 18" x 48' RCP - CLASS III
LT. LANE 658+50 - 659+50 RT. CONSTRUCT "SPECIAL DITCH" ITEM 101
FUTURE CONSTRUCTION 649+50 - 650+50 NEW 24" x 75' x 60' ACCOMP. ARCH
FUTURE CONSTRUCTION 653+50 - 654+50 CONSTRUCT "SPECIAL DITCH" ITEM 101
FUTURE CONSTRUCTION 657+50 - 659+50 NEW 24" x 90' RCP - CLASS III
FUTURE CONSTRUCTION 657+50 - 659+50 RT. CONSTRUCT "SPECIAL DITCH" ITEM 101
AERIAL COMMUNICATION LINE TO BE REMOVED BY N.E.T. & T. CO.-NOT TO BE REPLACED
VILLAGE OF SWANTON 2.3 x 3.6
TOWN ROAD #36
N.E.T. & T. CO. 20 OPEN WIRES
BRUSH & WOODS
WET
KIRBY
LAFANR
COON
BEGNOCHE
PIT
DRIVE
DARK 5/16" PER FOOT
B.M. 172 ELEV. 182.77
B.M. 170 ELEV. 183.16
100' SBL
204' NBL
#21
22a
22b
23a
24a
24b
#25a
25b
STAGE I CONSTRUCTION
see insert
SWANTON - HIGHGATE PLAN
STA. 647+00 TO 663+00
CONTROL OF ACCESS IS COMPLETE ON THIS SHEET.
ALL BEARINGS ARE MAGNETIC.
* THESE ITEMS ARE STAGE 2 CONSTRUCTION
LT. LANE STAGE 2 CONSTRUCTION
I 89-3(20)
SHEET 40 OF 222
I 89 3-(7)
26
15