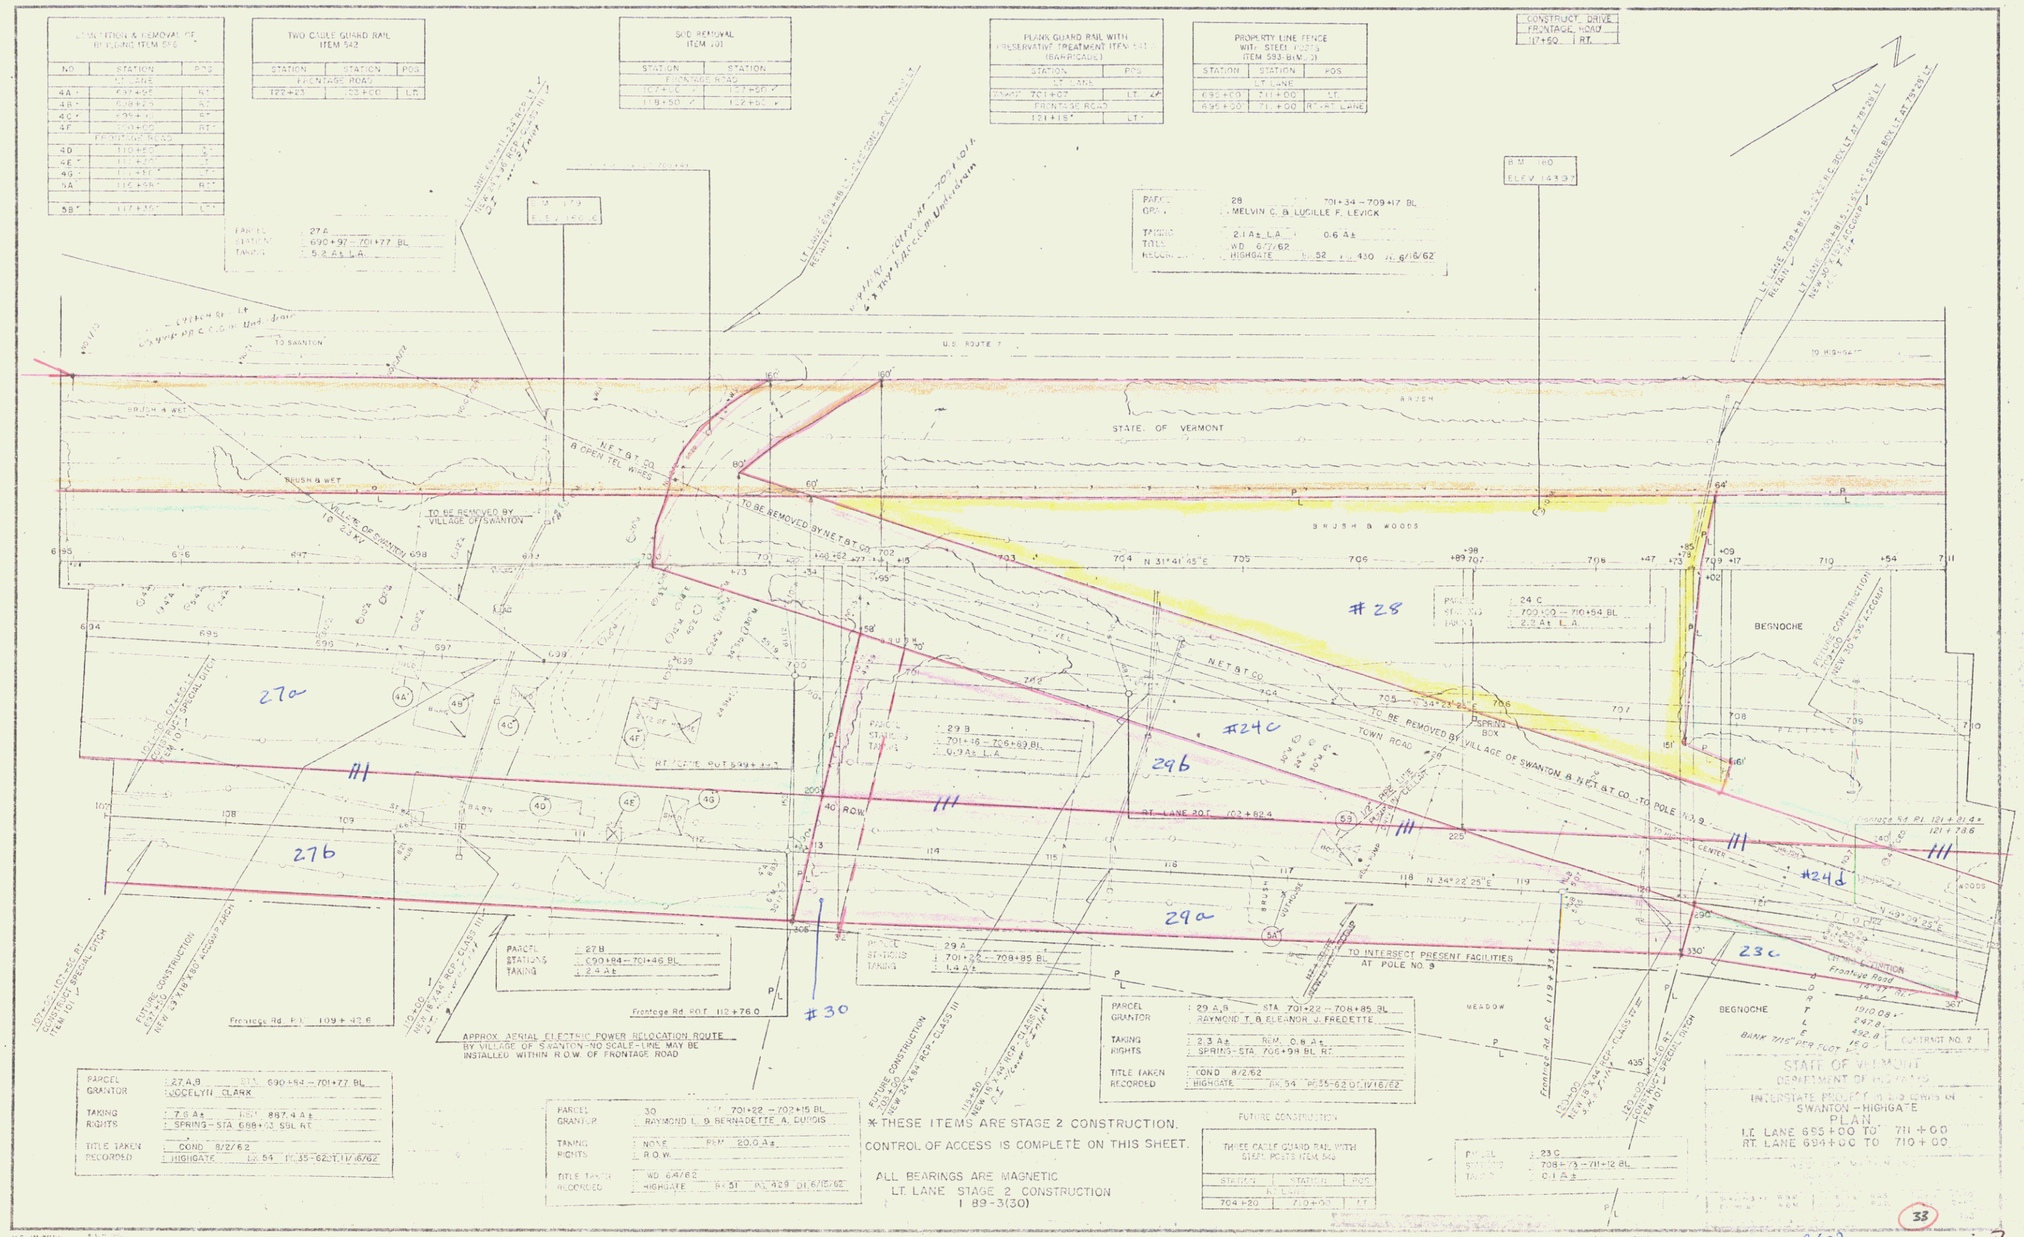
U.S. ROUTE 7
STATE OF VERMONT
BRUSH & WOODS
BEGNOCHE
MEADOW
TO SWANTON
TO HIGHGATE
N.E.T.&T. CO.
TO BE REMOVED BY NE T&T CO
TO BE REMOVED BY VILLAGE OF SWANTON
TO BE REMOVED BY VILL. OF SWANTON & NE T&T CO.
TOWN ROAD
N 31°41'45"E
N 34°22'25"E
#28
#24c
#24d
29b
29a
27a
27b
23c
#30
APPROX. AERIAL ELECTRIC POWER RELOCATION ROUTE BY VILLAGE OF SWANTON-NO SCALE-LINE MAY BE INSTALLED WITHIN R.O.W. OF FRONTAGE ROAD
TO INTERSECT PRESENT FACILITIES AT POLE NO. 9
STATE OF VERMONT
DEPARTMENT OF HIGHWAYS
INTERSTATE PROJECT I-89-3 (30) SWANTON-HIGHGATE
PLAN
LT. LANE 685+00 TO 711+00
RT. LANE 694+00 TO 710+00
CONTRACT NO. 2
* THESE ITEMS ARE STAGE 2 CONSTRUCTION.
CONTROL OF ACCESS IS COMPLETE ON THIS SHEET.
ALL BEARINGS ARE MAGNETIC
LT. LANE STAGE 2 CONSTRUCTION
I 89-3(30)
SHEET 36 OF 222
3-(7)
33
Row + cons
18