PROPERTY LINE FENCE WITH STEEL POSTS ITEM 543-B(MOD)		
STATION	STATION	POS.
LT. LANE		
727+00	743+00	LT.
736+40	743+00	RT.-RT. LANE

727+00

MUCK EXCAVATION ITEM 116	
STATION	STATION
727+0	736+0

* THREE CABLE GUARD RAIL WITH STEEL POSTS ITEM 543		
STATION	STATION	POS.
LT. LANE		
738+08±36	739+52±18	LT.
738+00	739+64±76	RT.

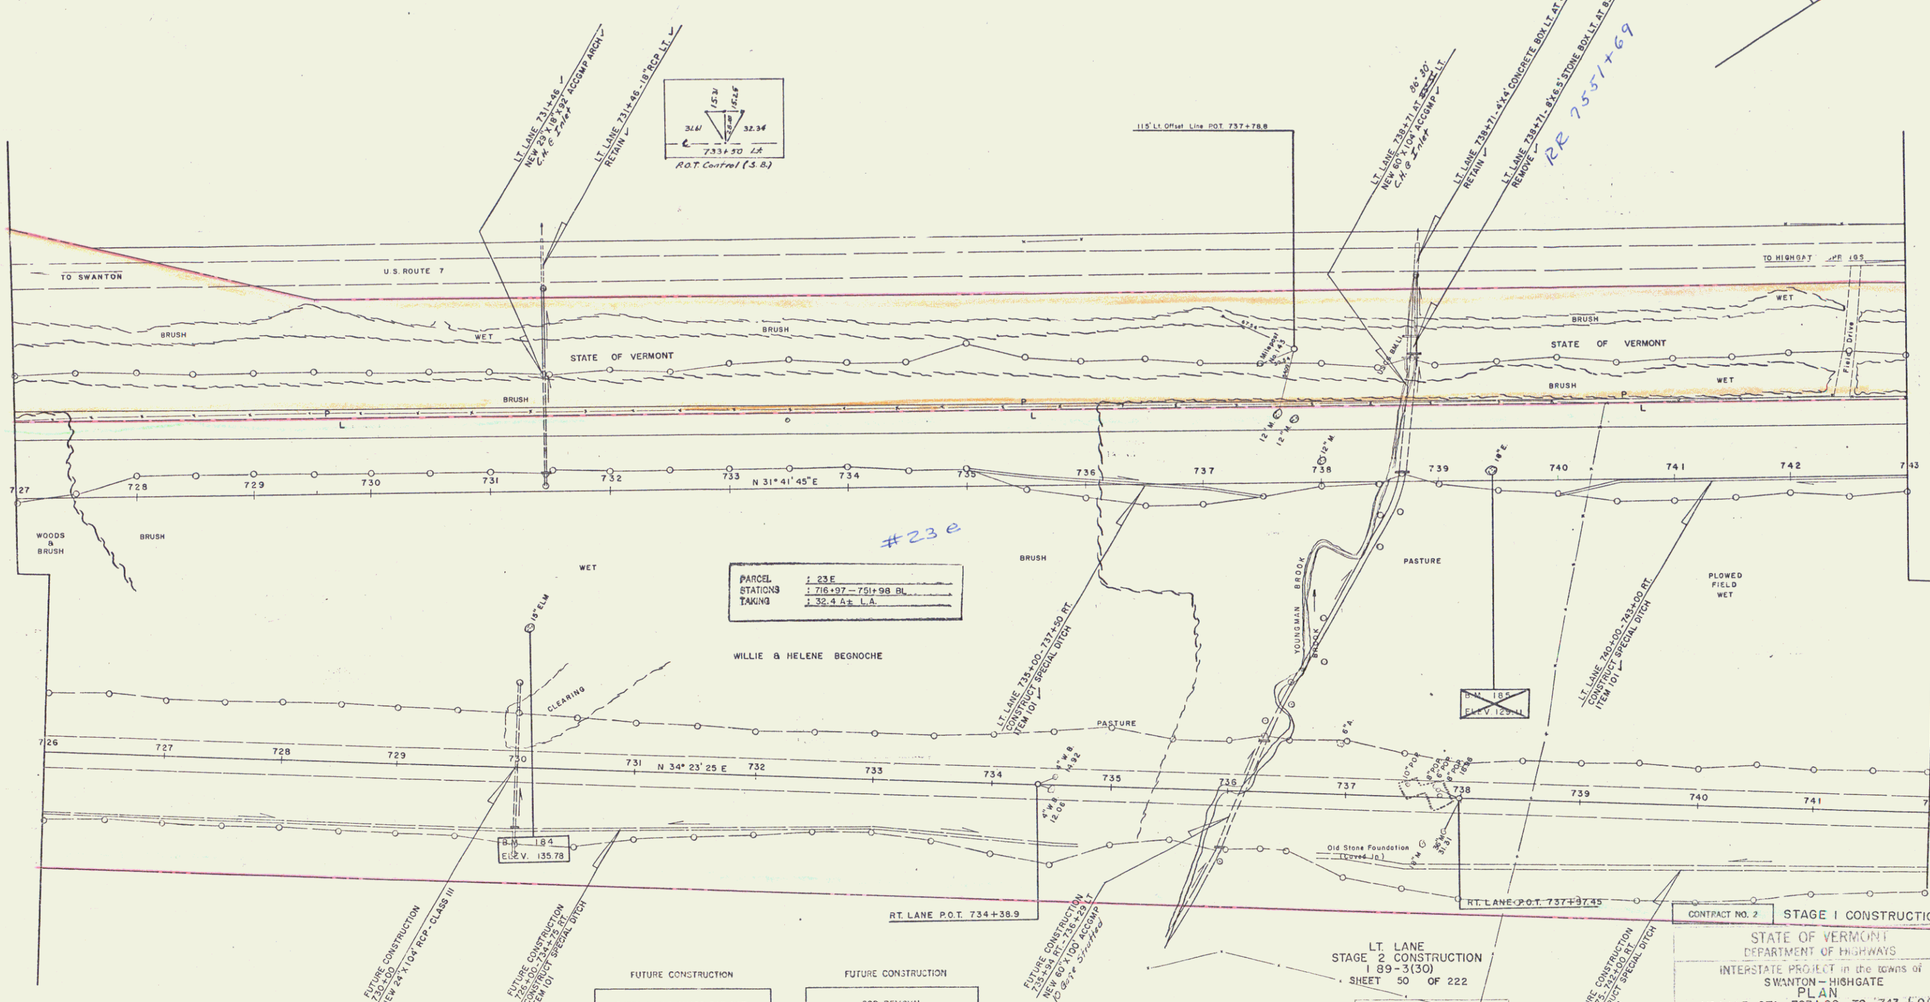

FUTURE CONSTRUCTION

THREE CABLE GUARD RAIL WITH STEEL POSTS ITEM 543		
STATION	STATION	POS.
RT. LANE		
734+72	737+28	LT.
734+72	737+28	RT.

FUTURE CONSTRUCTION

SOD REMOVAL ITEM 101	
STATION	STATION
RT. LANE	
737+00	742+00

ALL BEARINGS ARE MAGNETIC.
* THESE ITEMS ARE STAGE 2 CONSTRUCTION.

CONTROL OF ACCESS IS COMPLETE ON THIS SHEET.

LT. LANE
STAGE 2 CONSTRUCTION
I 89-3(30)
SHEET 50 OF 222

CONTRACT NO. 2 — STAGE I CONSTRUCTION

STATE OF VERMONT
DEPARTMENT OF HIGHWAYS
INTERSTATE PROJECT in the towns of
SWANTON — HIGHGATE
PLAN
LT. LANE STA. 727+00 TO 743+00
RT. LANE STA. 726+00 TO 742+00

WEBSTER MARTIN INC.
CONSULTING ENGINEERS
TO BURLINGTON, VT.

SURVEYED BY W.B.M.	DATE	R.A.D.	SCALE	1"=50'
DRAWN BY W.B.M.	DATE	P.J.D.	DATE	2-62
I 89-3 7			38	163

R.O.W. + const

20