CONSTRUCT DRIVE	
STATION	POS
SA-4 RELOC.	
35 + 00 ±	LT.
35 + 00 ±	RT.

PLANK GUARD RAIL WITH PRESERVATIVE TREATMENT ITEM 541-A (BARRICADE)	
STATION	POS
SA-4 RELOC.	
34 + 00	RT. ✓

SOD REMOVAL ITEM 101	
STATION	STATION
SA-4 RELOC.	
30 + 50 ✓	35 + 00 ✓

EXCAVATION & REMOVAL OF ROAD SURFACE ON ROADWAYS ITEM 110-A		
STATION	STATION	POS
SA-4 RELOC.		
32 + 75	35 + 40	RT.

EXCAVATION & REMOVAL OF EXISTING PAVEMENT ITEM 101	
STATION	STATION
SA-4 RELOC.	
30 + 50	32 + 75

(2) WORK TO BE DONE BY OTHERS

PARCEL	: 39 STA. 29+47 – 30+70 SL LT.
GRANTOR	: JOHN A. TRACY & JENNIE TRACY & LOUIS C. TRACY & MARY M. BEYOR
TAKING	: 871 SQ. FT. ± REM. 0.98 A±
TITLE TAKEN	: WDOE 7/5/62
RECORDED	: HIGHGATE BK. 52 PG. 438 DT. 7/14/62

PARCEL	: 40 STA. 29+47 – 35+10 SL RT.
GRANTOR	: HENRY A. LAFRANCE & RICHARD LAFRANCE
TAKING	: 0.1 A± REM. 4.9 A±
TITLE TAKEN	: WDOE 7/2/62
RECORDED	: HIGHGATE BK. 52 PG. 437 DT. 7/14/62

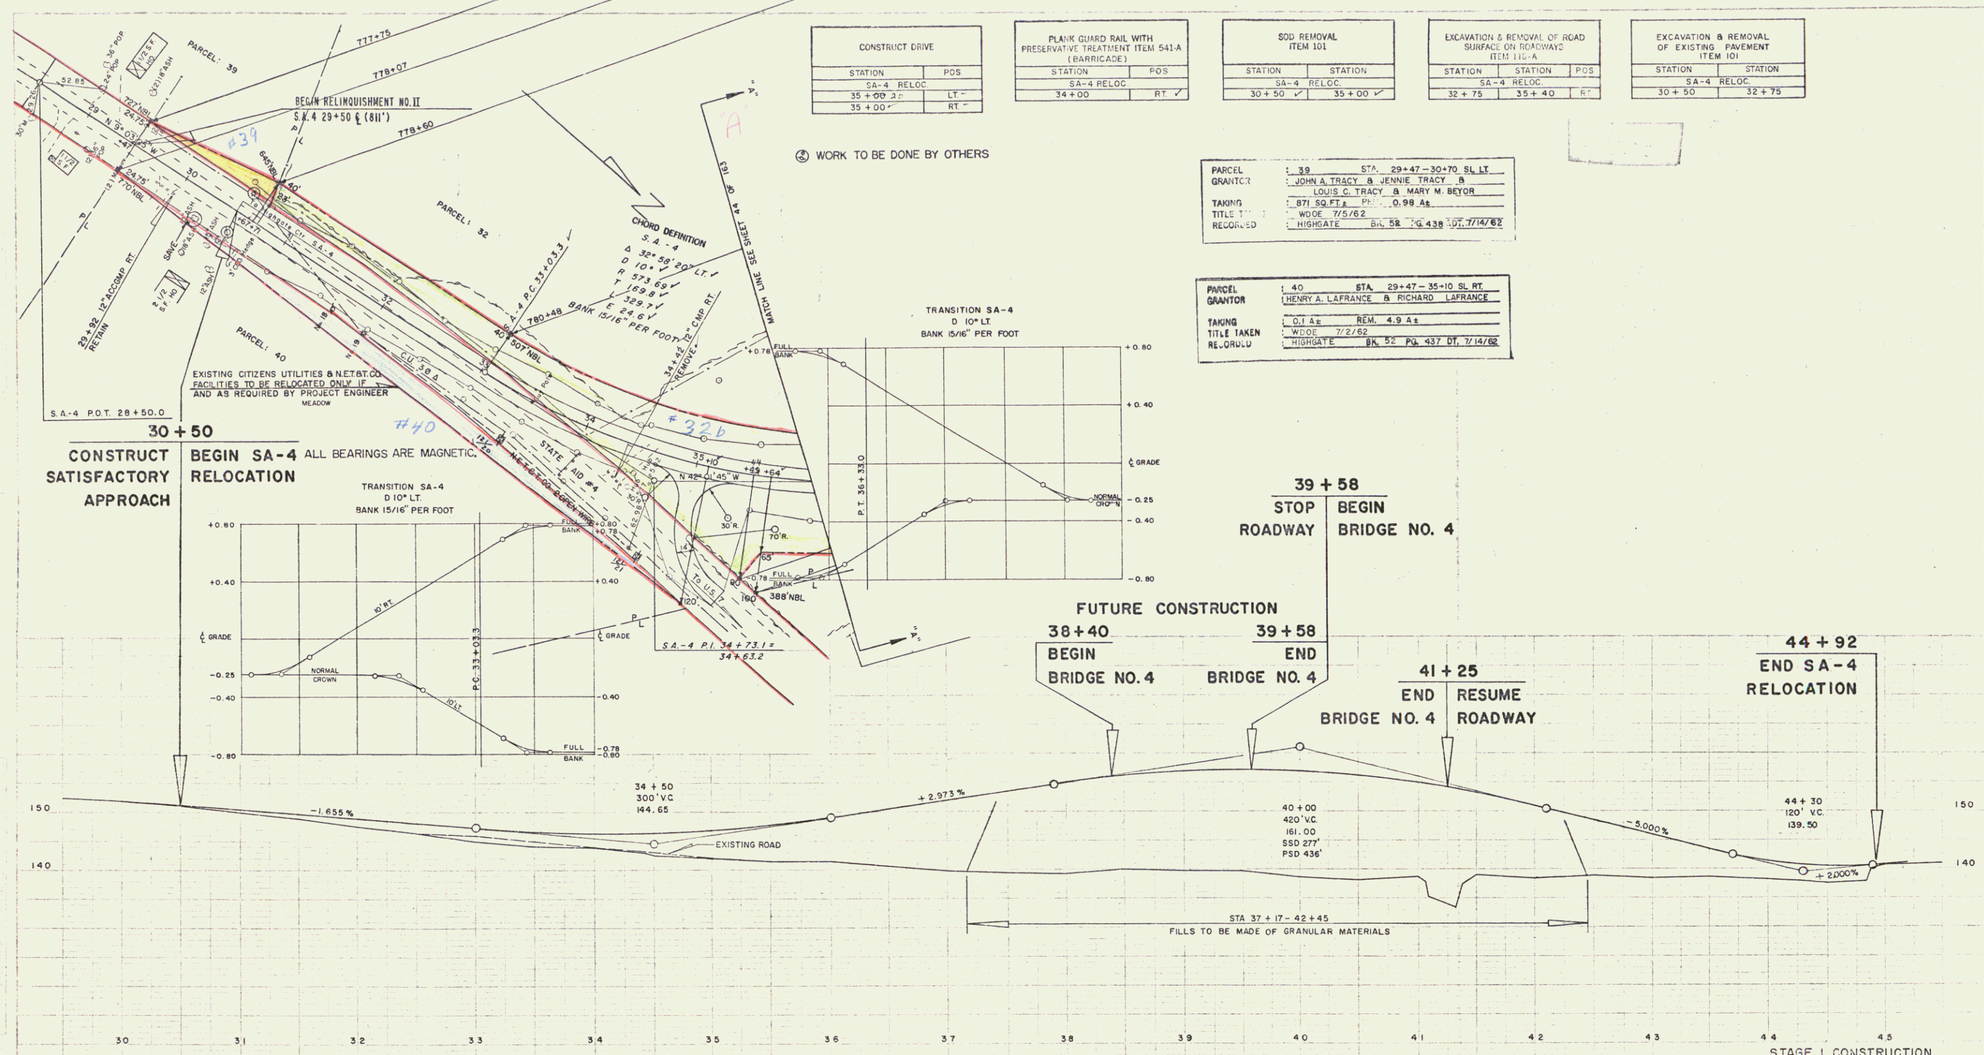

STAGE I CONSTRUCTION

S.A 4 TO BE BUILT IN ITS ENTIRETY AS STAGE I CONSTRUCTION

CONTRACT NO. 2

STATE OF VERMONT
DEPARTMENT OF HIGHWAYS

INTERSTATE PROJECT in the towns of
SWANTON - HIGHGATE
S.A.-4 RELOCATION
PLAN-PROFILE
STA. 30+00 TO 45+00

WEBSTER MARTIN, INC.
CONSULTING ENGINEERS
BURLINGTON, VT.

SURVEYED BY	W&M	CALCULATED	RJS	HORIZ. SCALE	1"=50'
DRAWN BY	W&M	IN CHARGE	RJD	DATE	2-62
PROJECT NO.	2 5 3 (7)	SHEET	46	OF	163

JAN 21 1980

const 25