EXCAVATION & REMOVAL OF ROAD SURFACE ON ROADWAYS ITEM 105-A		
STATION	STATION	POS.
952+80	953+90	RT.

REMOVAL & DISPOSAL OF PRESENT GUARD RAIL ITEM 550		
STATION	STATION	POS
957+23	959+72	LT.
963+05	963+14	LT.

CONSTRUCT APPROACH		
STATION	POS.	DESCRIPTION
952+50	LT.	FRONTAGE ROAD
952+50	RT.	U.S. 7 APPROACH

GRANITE SHOULDERING ITEM 556-A			
STATION	STATION	POS.	LOCATION
LEFT LANE			
951+06	952+25	RT.	MEDIAN
952+75	956+95	RT.	MEDIAN
958+63	960+00	LT.	ISLAND
958+67	959+08	RT.	TURN RD.
958+67	960+62	RT.	MEDIAN
962+28	963+25	RT.	MEDIAN
RIGHT LANE			
951+00	952+25	LT.	MEDIAN
952+75	954+04	LT.	MEDIAN
959+08	960+62	LT.	MEDIAN
960+64	962+23	LT.	MEDIAN
962+28	962+54	L.	MEDIAN
962+94	963+25	L.	TURN RD.

PROPERTY LINE FENCE WITH STRAND BASIS ITEM 710 (BRIDGE)		
STATION	STATION	POS.
951+00	952+20	RT.
951+00	952+20	LT.
952+95	958+38	RT.
952+90	958+45	LT.
963+73	967+00	LT.
963+15	967+00	RT.
CONSTRUCT DRIVE 1+60 LT. U.S. 7 APPROACH		

GRANITE CURB ITEM 556-B			
STATION	STATION	POS.	LOCATION
LEFT LANE			
960+64	962+26	RT.	MEDIAN

GUARD RAIL WITH PRESERVATIVE TREATMENT ITEM 541-A (GARRICADE)	
STATION	POS.
952+65	RT.

NOTE:
FOR SUMMARY OF LANDSCAPE MATERIAL SEE SHEET 16 OF 100

CONSTRUCT TURNING ROADWAY		
STATION	STATION	POS.
LEFT LANE		
958+55	958+93	RT.
RIGHT LANE		
963+15	963+45	LT.

THE UNITED STATES OF AMERICA
GENERAL SERVICES ADMINISTRATION
PARCEL: 63

SOD REMOVAL ITEM 101	
STATION	STATION
LEFT LANE	
951+75	954+25
RIGHT LANE	
951+75	952+70
FRONTAGE ROAD	
953+00	953+25
954+25	955+69.5
FRONTAGE ROAD (REST AREA)	
953+00	955+26

CONSTRUCT 14' HOLDING LANE INCLUDING 175' TAPER			
STATION	STATION	POS	LENGTH
LEFT LANE			
953+25	955+76	LT.	250
953+70	956+70	RT.	300
964+18	967+00	LT.	282
RIGHT LANE			
951+00	951+35	LT.	35
951+00	951+75	RT.	75
958+67	961+97	LT.	330
962+50	964+25	LT.	175
966+15	967+00	LT.	85

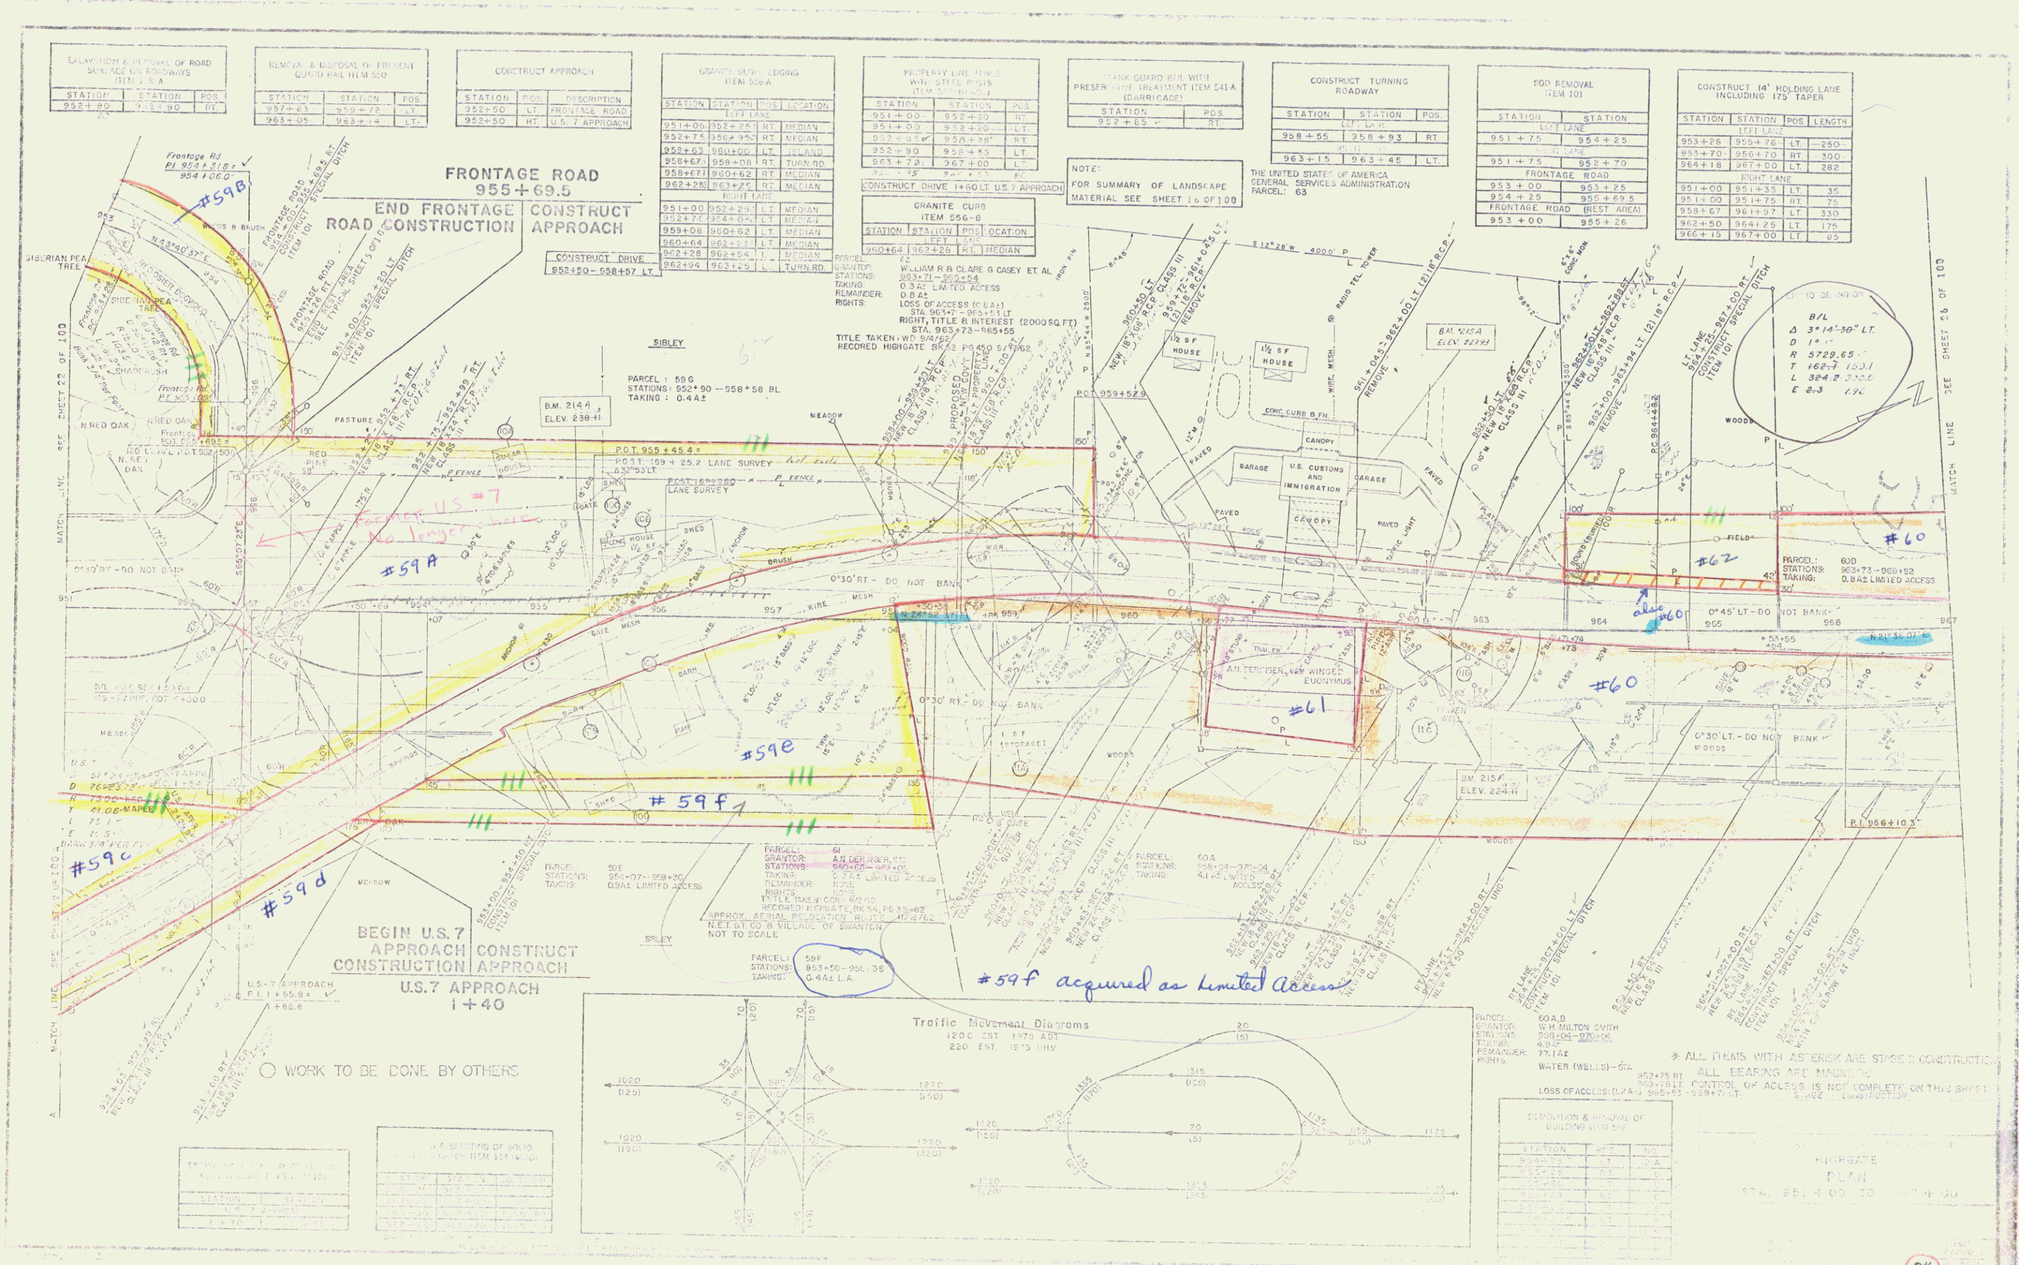

24

48