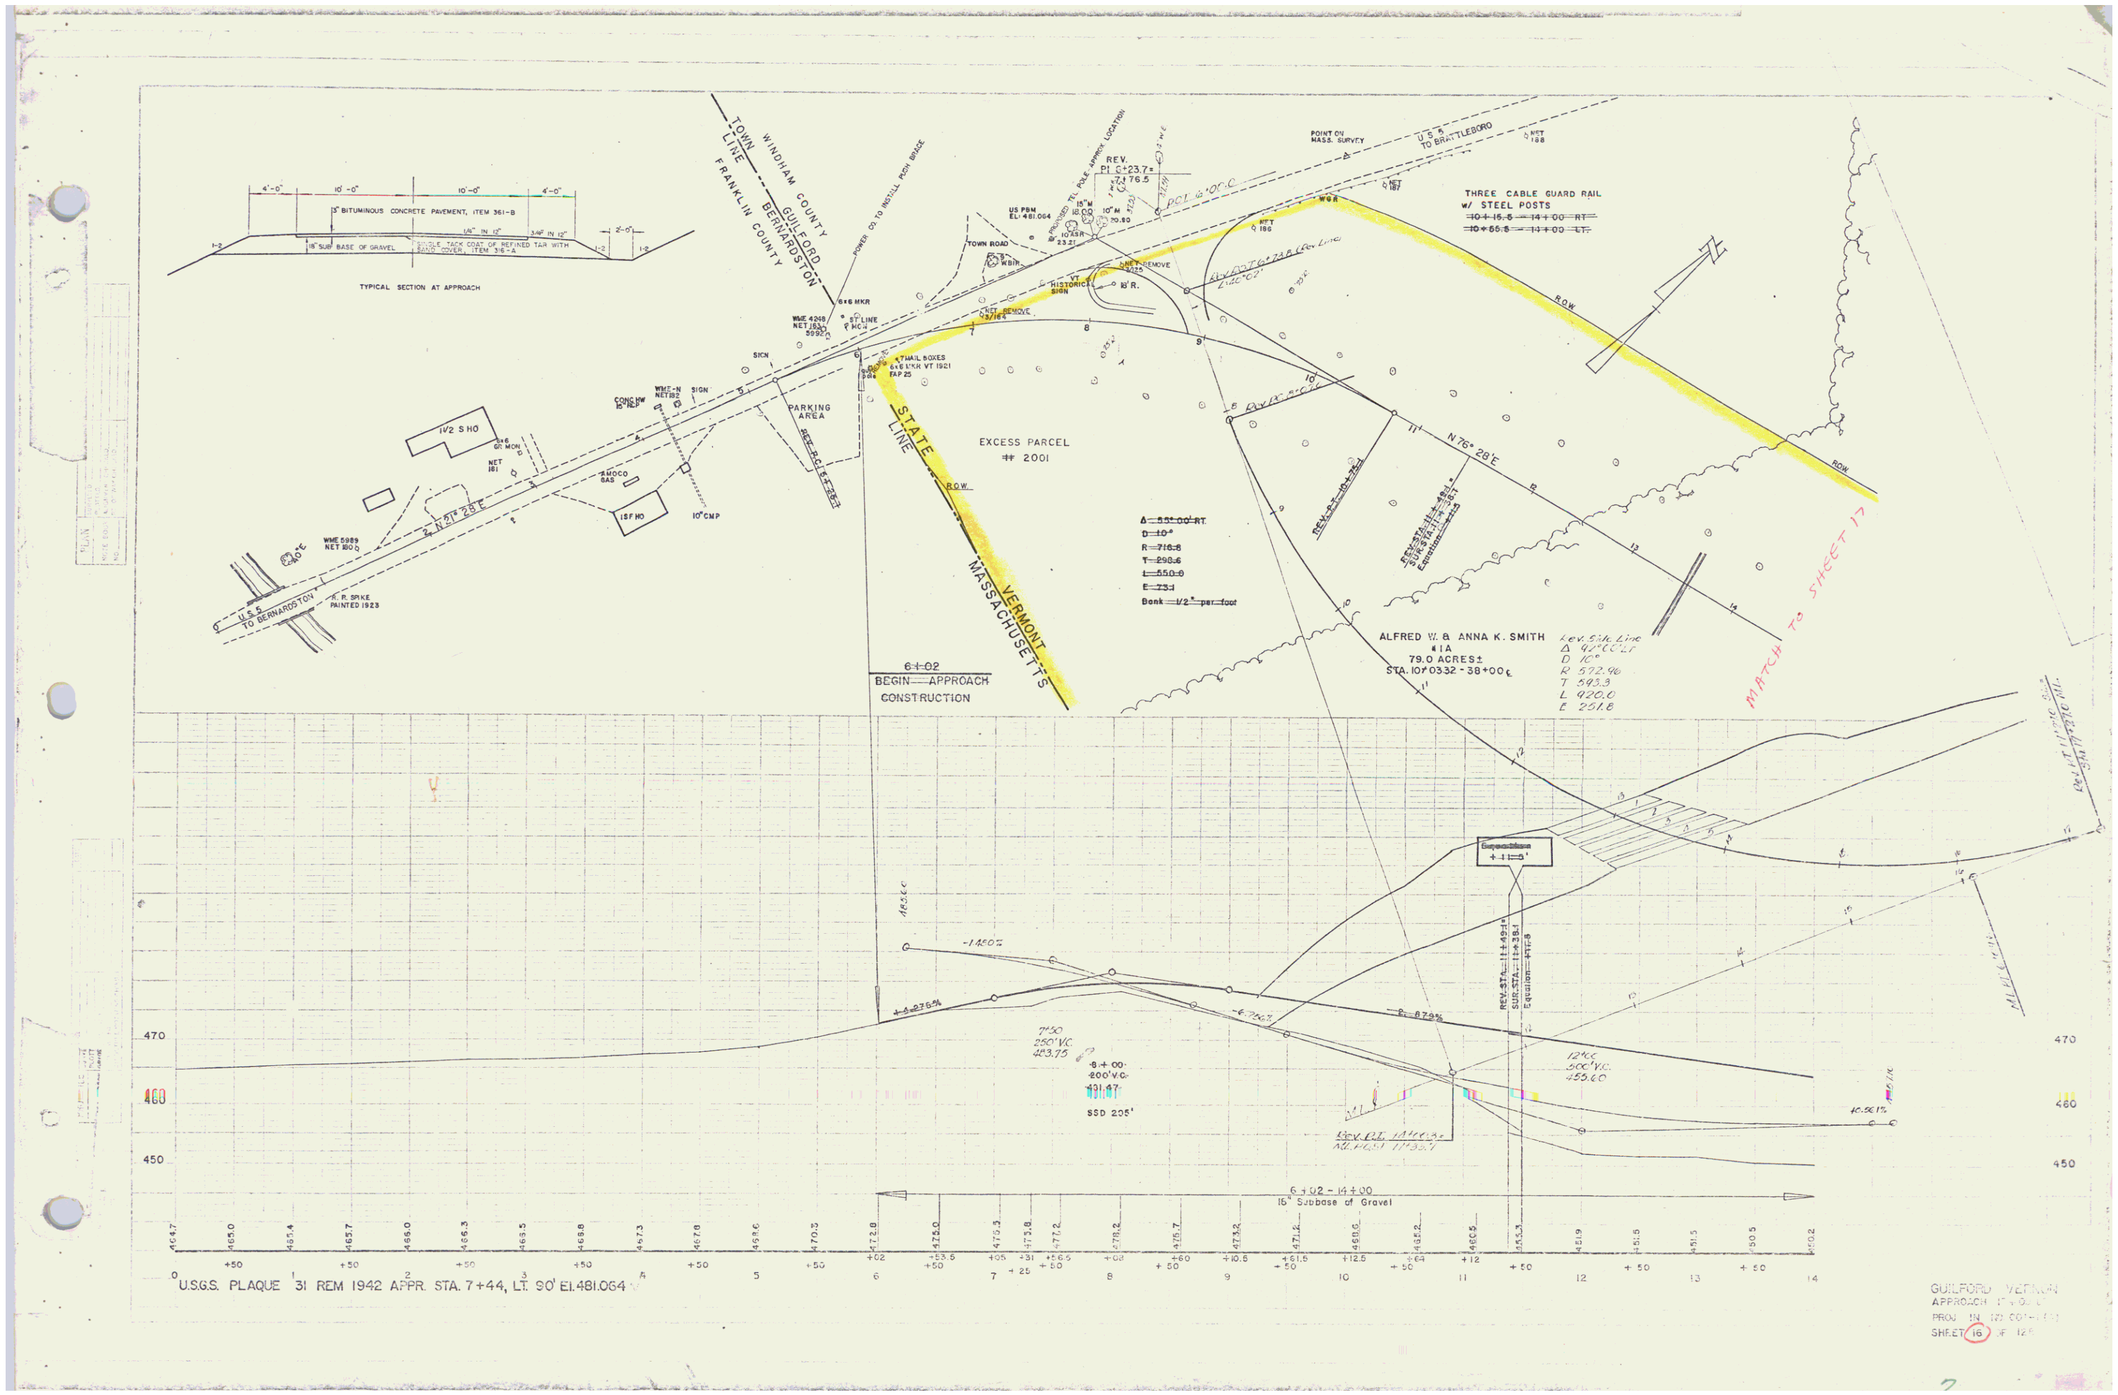
TYPICAL SECTION AT APPROACH
3" BITUMINOUS CONCRETE PAVEMENT, ITEM 361-B
18" SUB BASE OF GRAVEL
DOUBLE TACK COAT OF REFINED TAR WITH SAND COVER, ITEM 316-A
TOWN LINE
FRANKLIN COUNTY
WINDHAM COUNTY
GUILFORD
BERNARDSTON
POINT ON MASS. SURVEY
U.S. 5 TO BRATTLEBORO
THREE CABLE GUARD RAIL w/ STEEL POSTS
~~10+15.5 — 14+00 RT~~
~~10+55.5 — 14+00 LT~~
REV. PI C+23.7=
US PBM EL. 481.064
TOWN ROAD
HISTORICAL SIGN
PARKING AREA
EXCESS PARCEL
2001
STATE LINE
VERMONT
MASSACHUSETTS
U.S. 5 TO BERNARDSTON
N 76° 28' E
N 21° 28' E
ALFRED W. & ANNA K. SMITH
#1A
79.0 ACRES±
STA. 10+0332 - 38+00 ℄
Rev. Site Line
Δ 42°00' LT
D 10°
R 572.96
T 593.3
L 420.0
E 251.8
MATCH TO SHEET 17
6+02
BEGIN APPROACH CONSTRUCTION
Superelevation
7+50
250' V.C.
453.75
8+00
200' V.C.
431.97
SSD 205'
12+00
300' V.C.
455.60
6+02 - 14+00
15" Subbase of Gravel
U.S.G.S. PLAQUE 31 REM 1942 APPR. STA. 7+44, LT. 90' El. 481.064
GUILFORD VETERAN
APPROACH
SHEET 16 OF 12