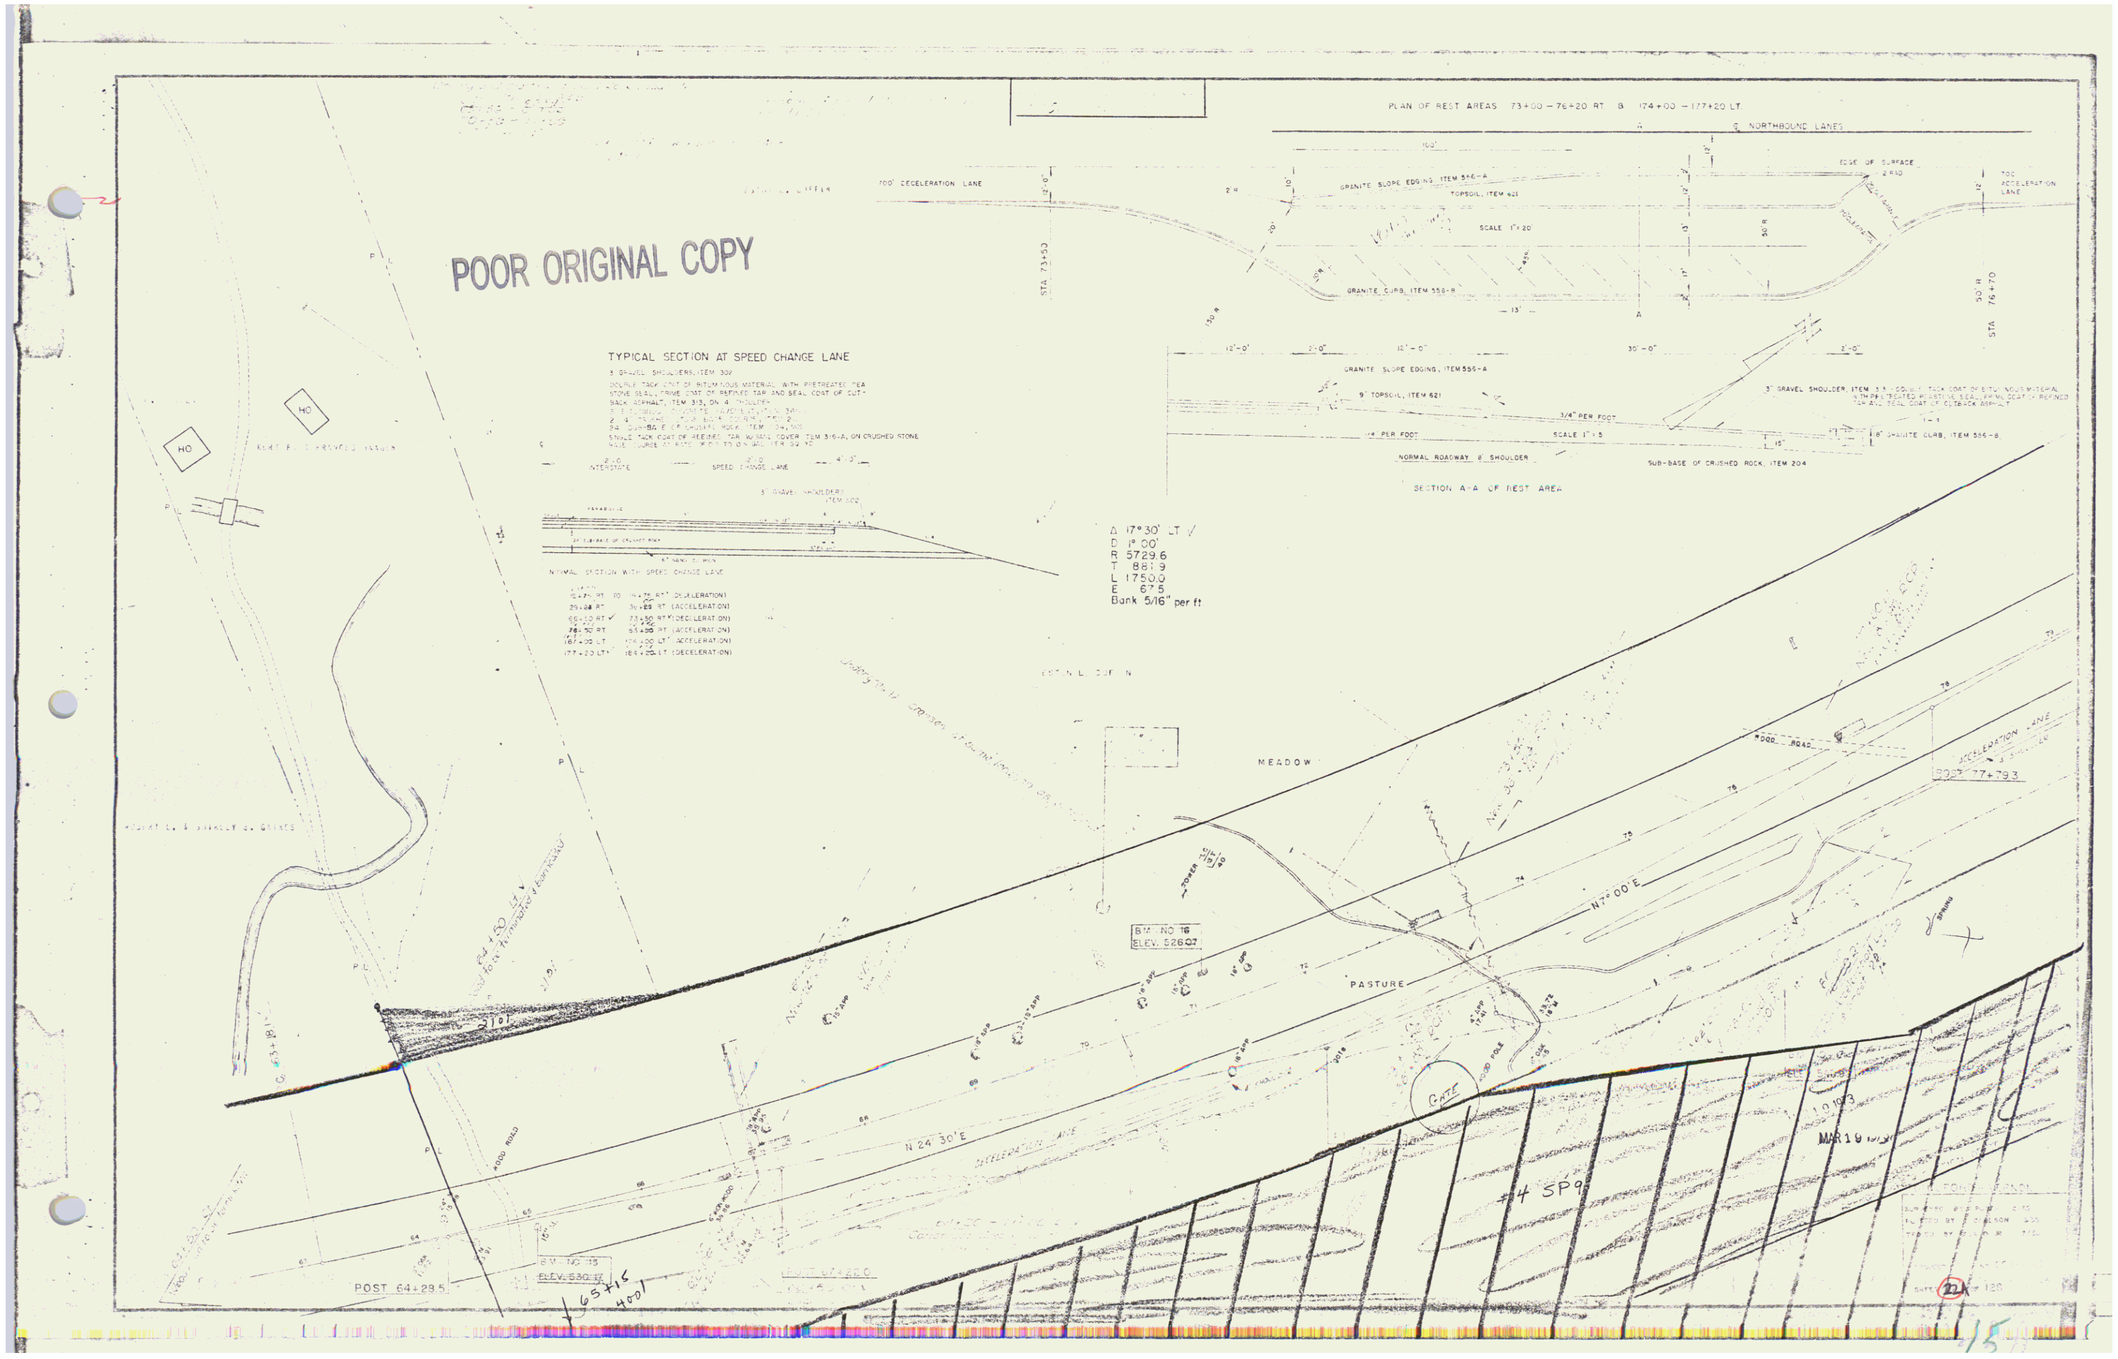
POOR ORIGINAL COPY
PLAN OF REST AREAS 73+00 – 76+20 RT & 174+00 – 177+20 LT.
℄ NORTHBOUND LANES
700' DECELERATION LANE
GRANITE SLOPE EDGING, ITEM 556-A
TOPSOIL, ITEM 621
SCALE 1" = 20'
GRANITE CURB, ITEM 556-B
EDGE OF SURFACE
700' ACCELERATION LANE
STA. 73+53
STA. 76+70
GRANITE SLOPE EDGING, ITEM 556-A
9" TOPSOIL, ITEM 621
3/4" PER FOOT
1/4" PER FOOT
SCALE 1" = 5'
NORMAL ROADWAY & SHOULDER
SUB-BASE OF CRUSHED ROCK, ITEM 204
3" GRAVEL SHOULDER, ITEM 301
18" GRANITE CURB, ITEM 556-B
SECTION A-A OF REST AREA
TYPICAL SECTION AT SPEED CHANGE LANE
INTERSTATE
SPEED CHANGE LANE
NORMAL SECTION WITH SPEED CHANGE LANE
Δ 17°30' LT
D 1°00'
R 5729.6
T 881.9
L 1750.0
E 67.5
Bank 5/16" per ft
MEADOW
PASTURE
BM NO 16
ELEV. 526.07
BM NO 15
ELEV. 530.17
N 7°00'E
N 24°30'E
ROAD ROAD
GATE
POST 64+29.5
MAR 16