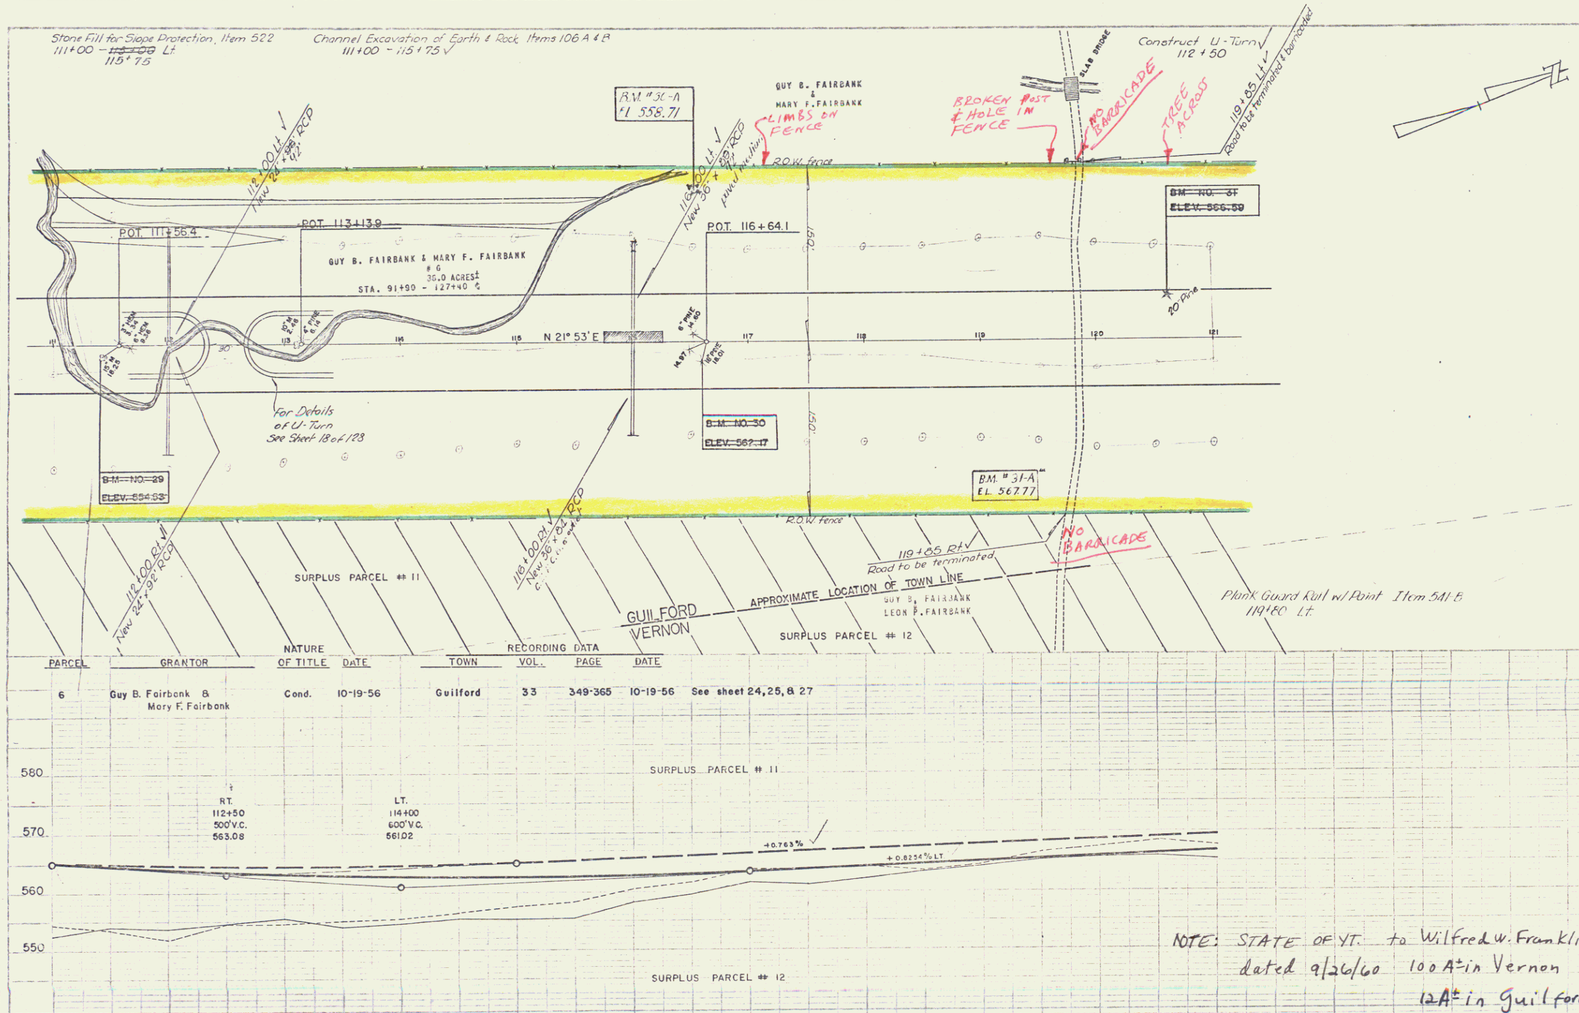

PARCEL	GRANTOR	NATURE OF TITLE	DATE	TOWN	RECORDING DATA VOL.	PAGE	DATE	
6	Guy B. Fairbank & Mary F. Fairbank	Cond.	10-19-56	Guilford	33	349-365	10-19-56	See sheet 24, 25, & 27

	111	+50	112	+50	113	+50	114	+50	115	+50	116	+50	117	+50	118	+50	119	+50	120	+50	121
LT.	552.3	553.9	553.7	554.4	555.4	554.0	554.6	555.3	555.2	555.6	558.4	559.7	560.7	561.1	562.8	563.4	564.5	565.3	565.7	566.0	565.3
RT.	554.1	553.7	553.0	554.4	554.4	555.0	555.6	556.2	557.6	558.2	560.9	561.9	564.0	564.0	564.3	563.7	564.7	566.8	567.5	567.8	567.7