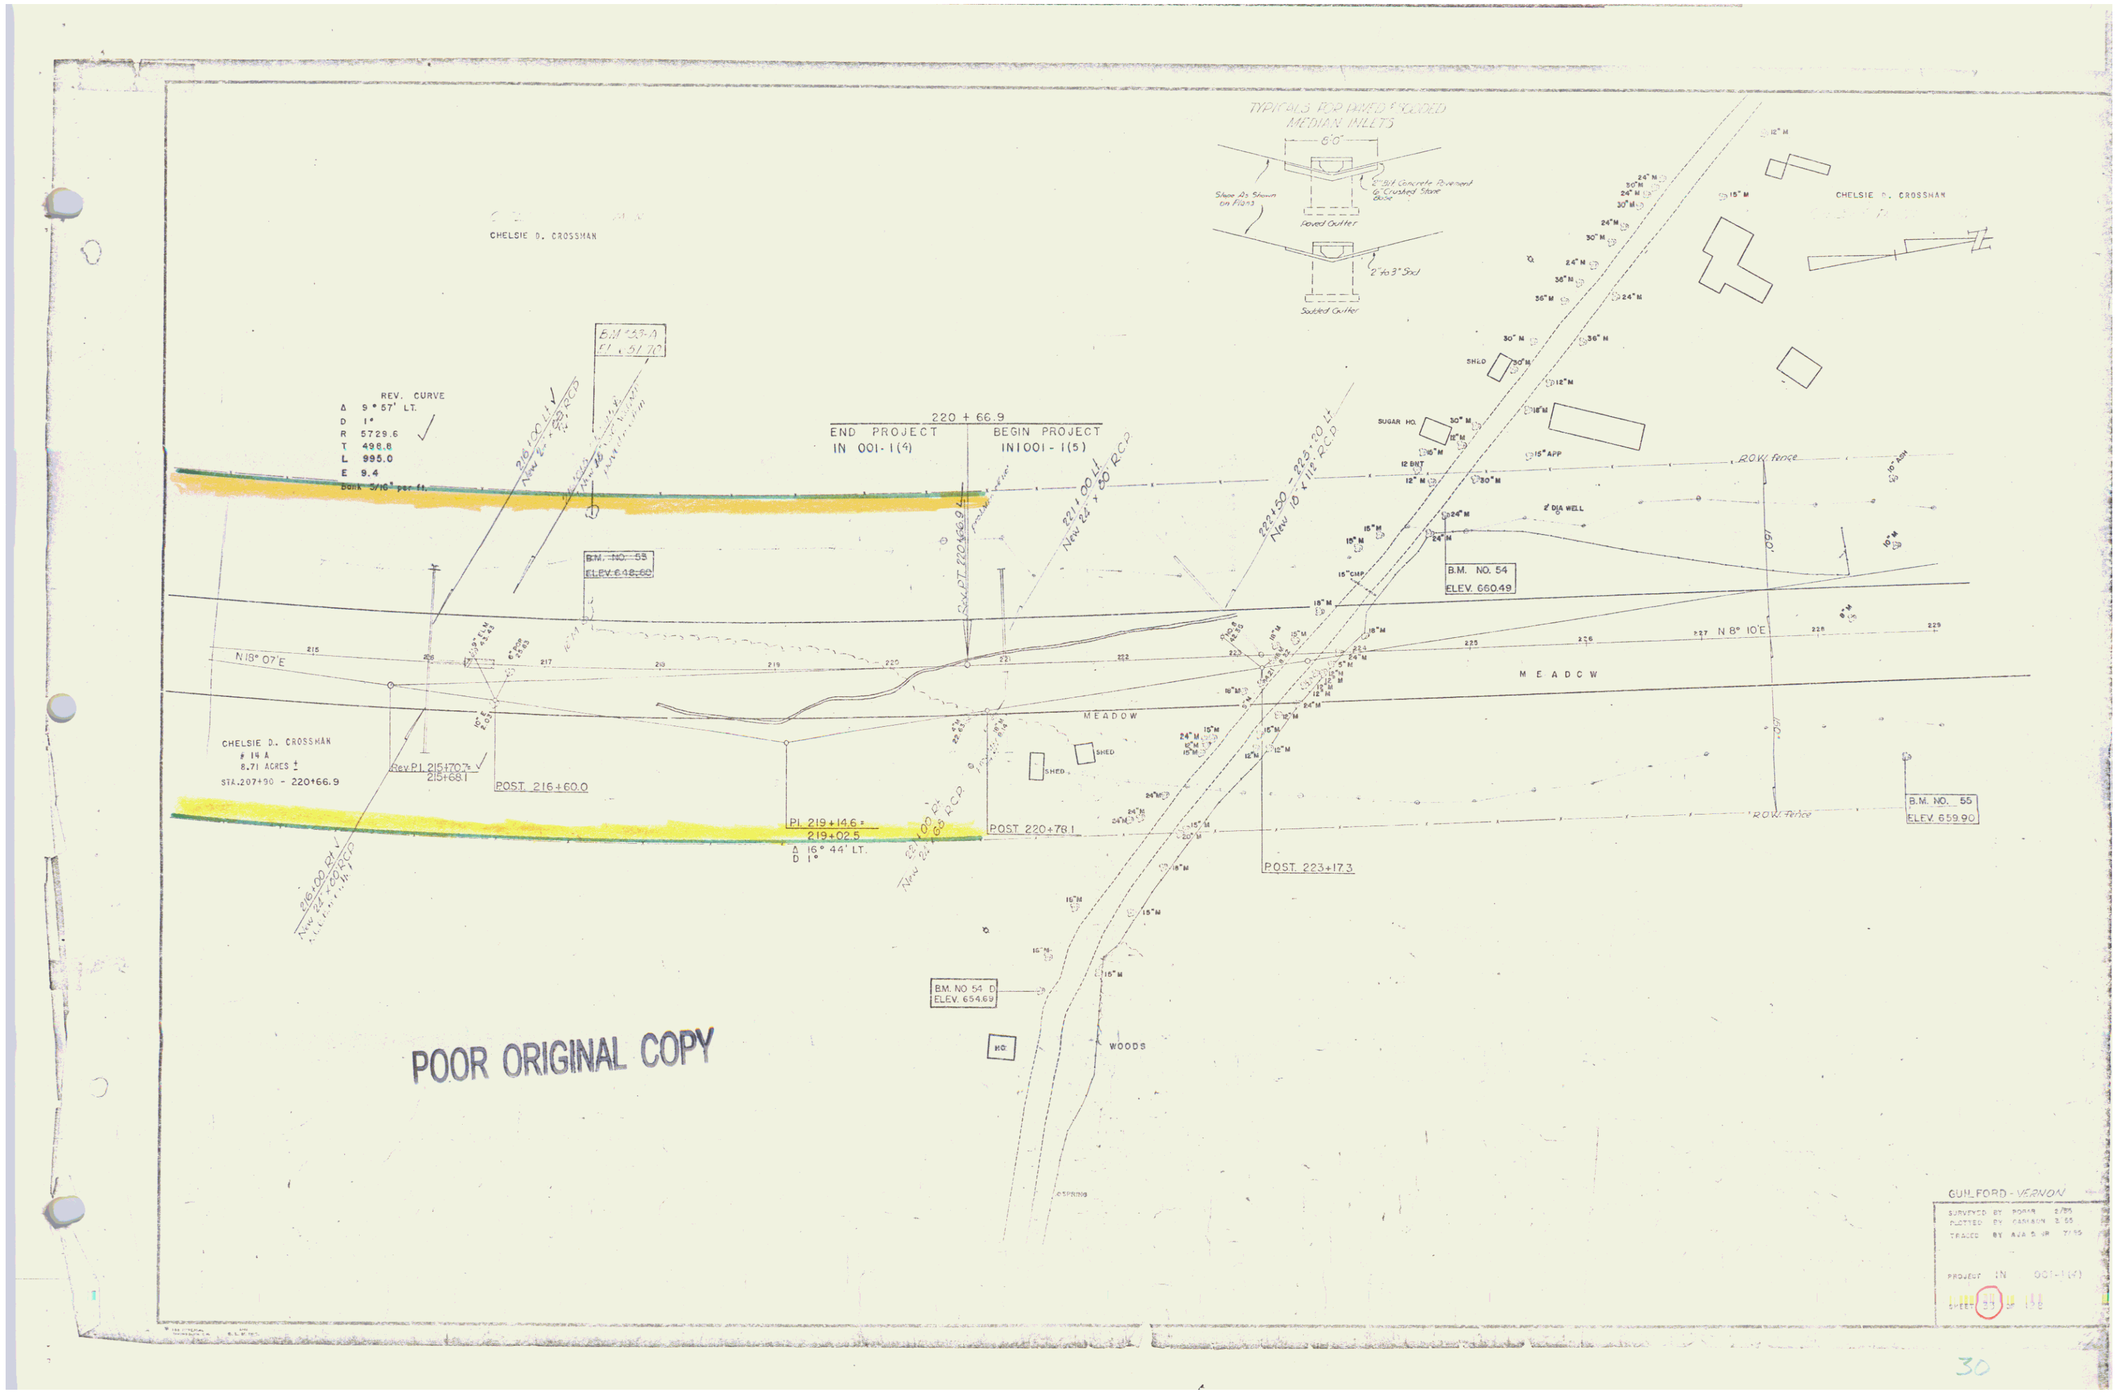

POOR ORIGINAL COPY