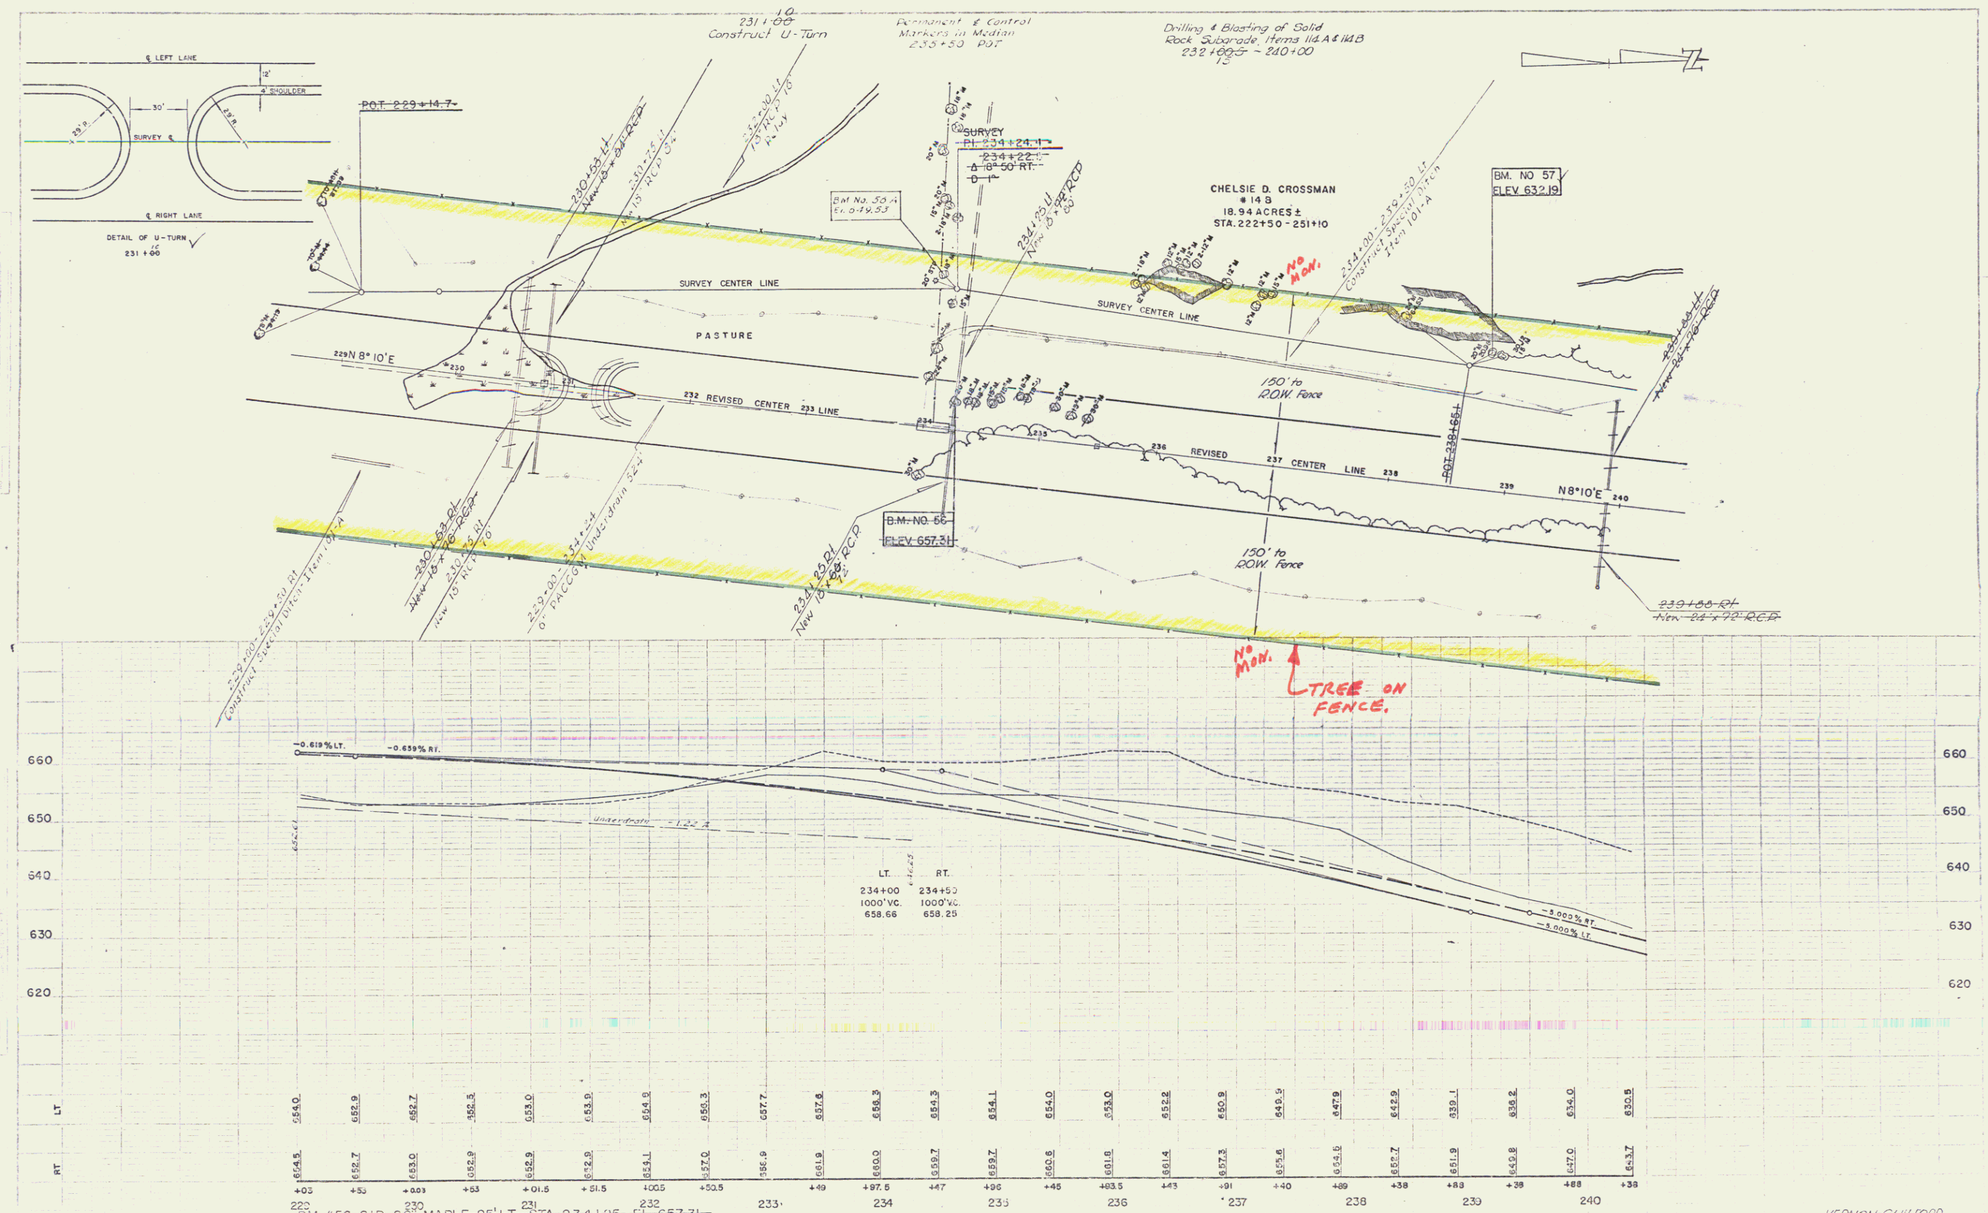
℄ LEFT LANE
12'
4' SHOULDER
30'
SURVEY ℄
℄ RIGHT LANE
DETAIL OF U-TURN
231+00
POT 229+14.7
231+00
Construct U-Turn
Permanent & Control Markers in Median 233+50 POT
Drilling & Blasting of Solid Rock Subgrade. Items 114A & 114B 232+66.5 - 240+00
SURVEY
PI 234+24.1
234+22
Δ 8°50 RT.
D 1°
BM No. 58 A El. 649.53
CHELSIE D. CROSSMAN
#14B
18.94 ACRES ±
STA. 222+50 - 251+10
BM. NO 57
ELEV 632.19
NO MON.
SURVEY CENTER LINE
PASTURE
229 N 8° 10'E
232 REVISED CENTER 233 LINE
150' to R.O.W. Fence
REVISED 237 CENTER LINE
N8°10'E
POT 238+65
B.M. NO. 56
ELEV 657.31
NO MON.
TREE ON FENCE.
-0.619% LT.
-0.639% RT.
Underdrain
LT. 234+00 1000' VC. 658.66
RT. 234+50 1000' VC. 658.25
-3.002% RT.
-3.000% LT.
660
650
640
630
620
LT
RT
+03 +53 +0.03 +53 +01.5 +51.5 +00.5 +50.5 +49 +97.5 +47 +96 +45 +93.5 +43 +91 +40 +89 +38 +88 +38 +38
220 230 231 232 233 234 235 236 237 238 239 240
BM #56 S.I.R. 20" MAPLE 25' LT STA. 234+25 EL. 657.31
BM #57 S.I.R. 20" MAPLE 117' LT. STA. 238+76 EL. 632.19
BM 56A S.I.R. 18" Maple 160' Lt Sta 234+15 El. 649.53
VERNON-GUILFORD IN 100(10)
SHEET 15 OF 130

4