Three Cable Guard Rail with Steel Posts
Right Lane
283+00 - 285+57 Rt
284+00 - 285+36 Lt
286+77 - 289+57 Rt
286+80 - 287+43 Lt
291+63 - 293+90 Rt
293+50 - 299+00 Rt
Coombs Underpass 286+50
5+51 - 6+29 Lt
7+00 - 8+44 Lt

Left Lane
285+43 - 286+31 Lt
287+03 - 289+70 Rt
287+31 - 287+57 Lt
290+13 - 292+42 Lt

~~Three Cable Guard Rail with Steel Posts~~
~~Right Lane~~ ~~Left~~
~~285+00 - 285+476 Rt~~ ~~285+680 - 286+24 Lt~~
~~286+65 - 288+93 Rt~~ ~~287+426 - 288+36 Lt~~
~~289+40 - 294+00 Rt~~ ~~290+20 - 292+28 Lt~~
~~298+40 - 299+00 Rt~~
~~Coombs Underpass 286+50~~
~~6+96 - 8+40 Lt~~

Demolition & Removal of Building
264+65 Rt.
295+90 Lt

Permanent & Control Markers in Median
283+623 PC
299+10.6 PT

PARCEL	GRANTOR	NATURE OF TITLE	DATE	RECORDING DATA TOWN	VOL.	PAGE	DATE
19	Albert W. & Bertha J. Pike	Cond.	10-19-56	Guilford	33	349-365	10-19-56 See sheet 18
20	Lawrence T. & Winifred B. Brissette	Cond.	10-19-56	Guilford	33	349-365	10-19-56
21A	John C. Gale	Judgment	2-12-57	Guilford	33	415	4-30-57
22A	Zadie P. & Elvira Corson	W. D.	4-22-57	Guilford	33	423	5-1-57
22B	Zadie P. & Elvira Corron	W. D.	10-3-57	Guilford	33	481	10-9-57

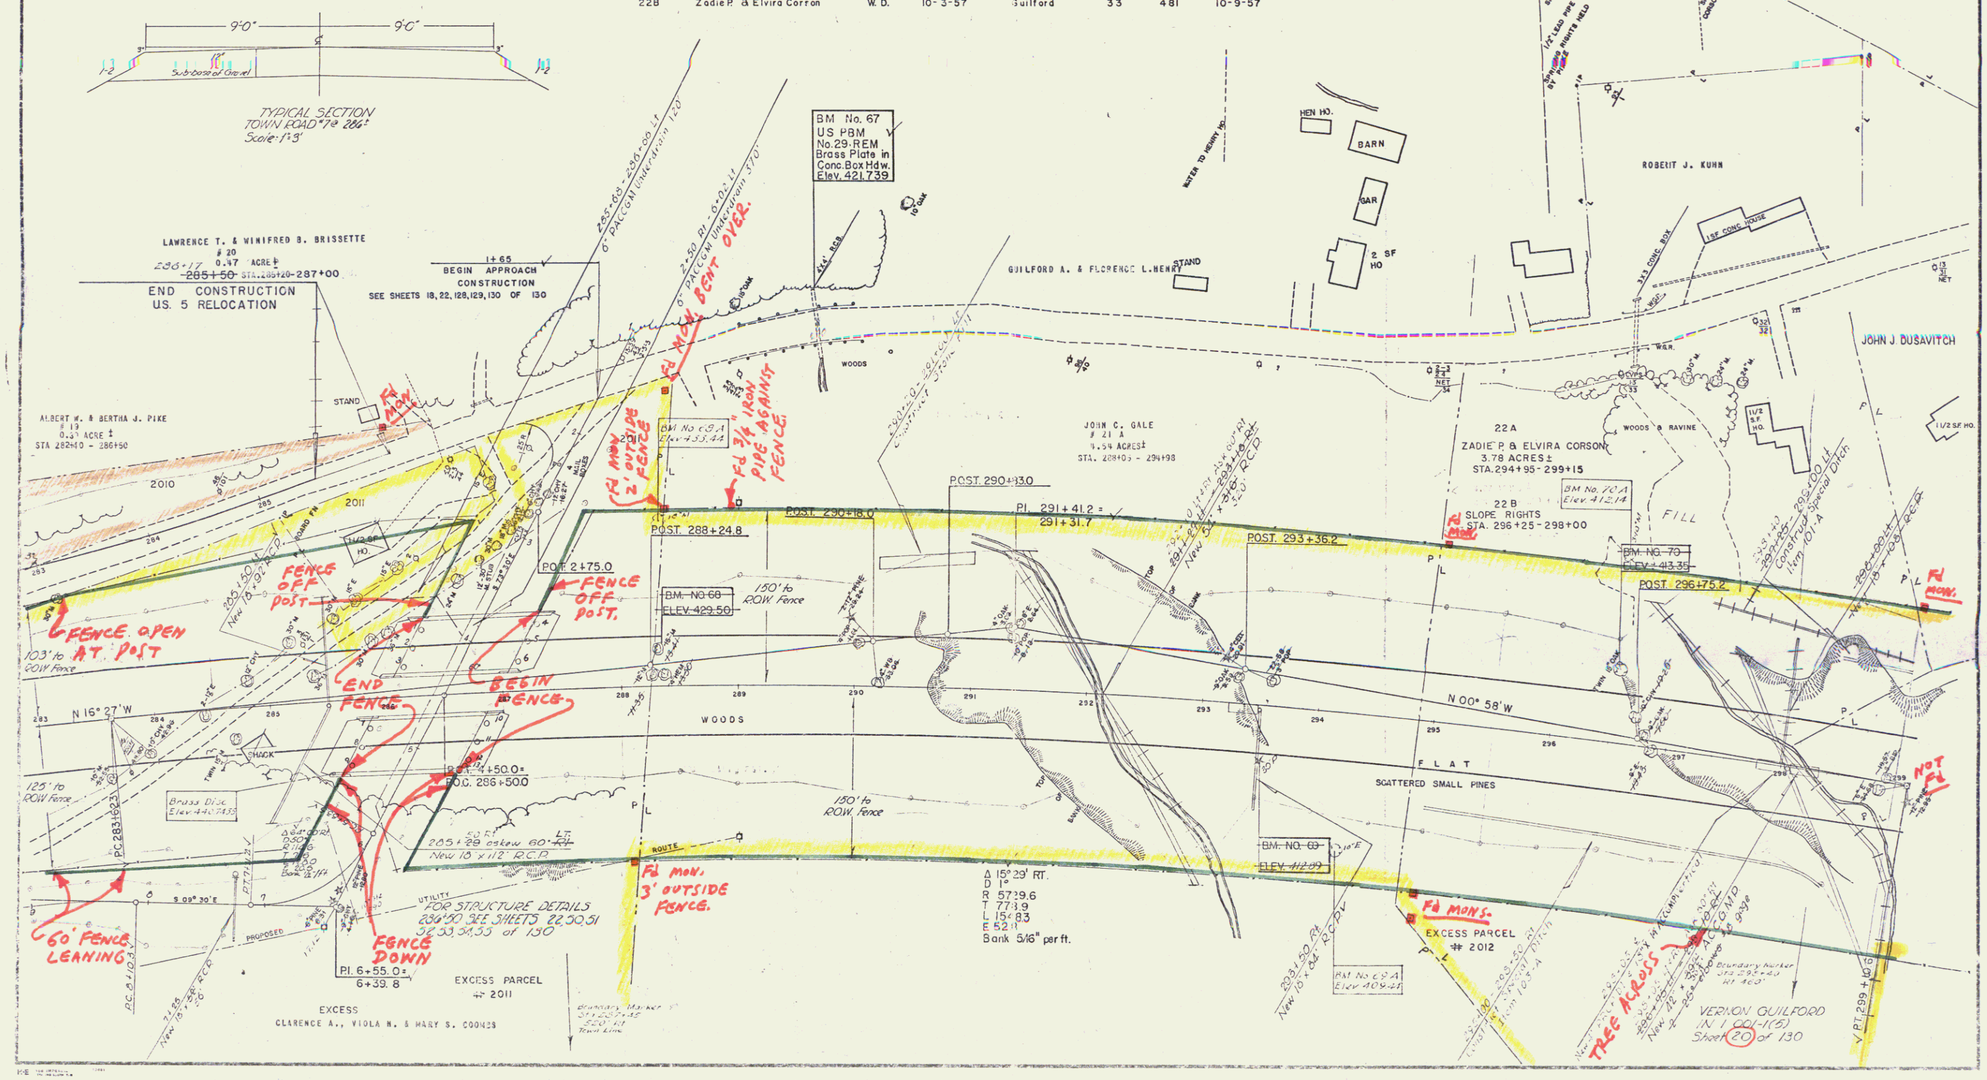

8