RIGHT-OF-WAY DIVISION
TOWN FILE
PERPETUAL
Town of Brattleboro I 91
(To Be Returned To R.O.W. Division)

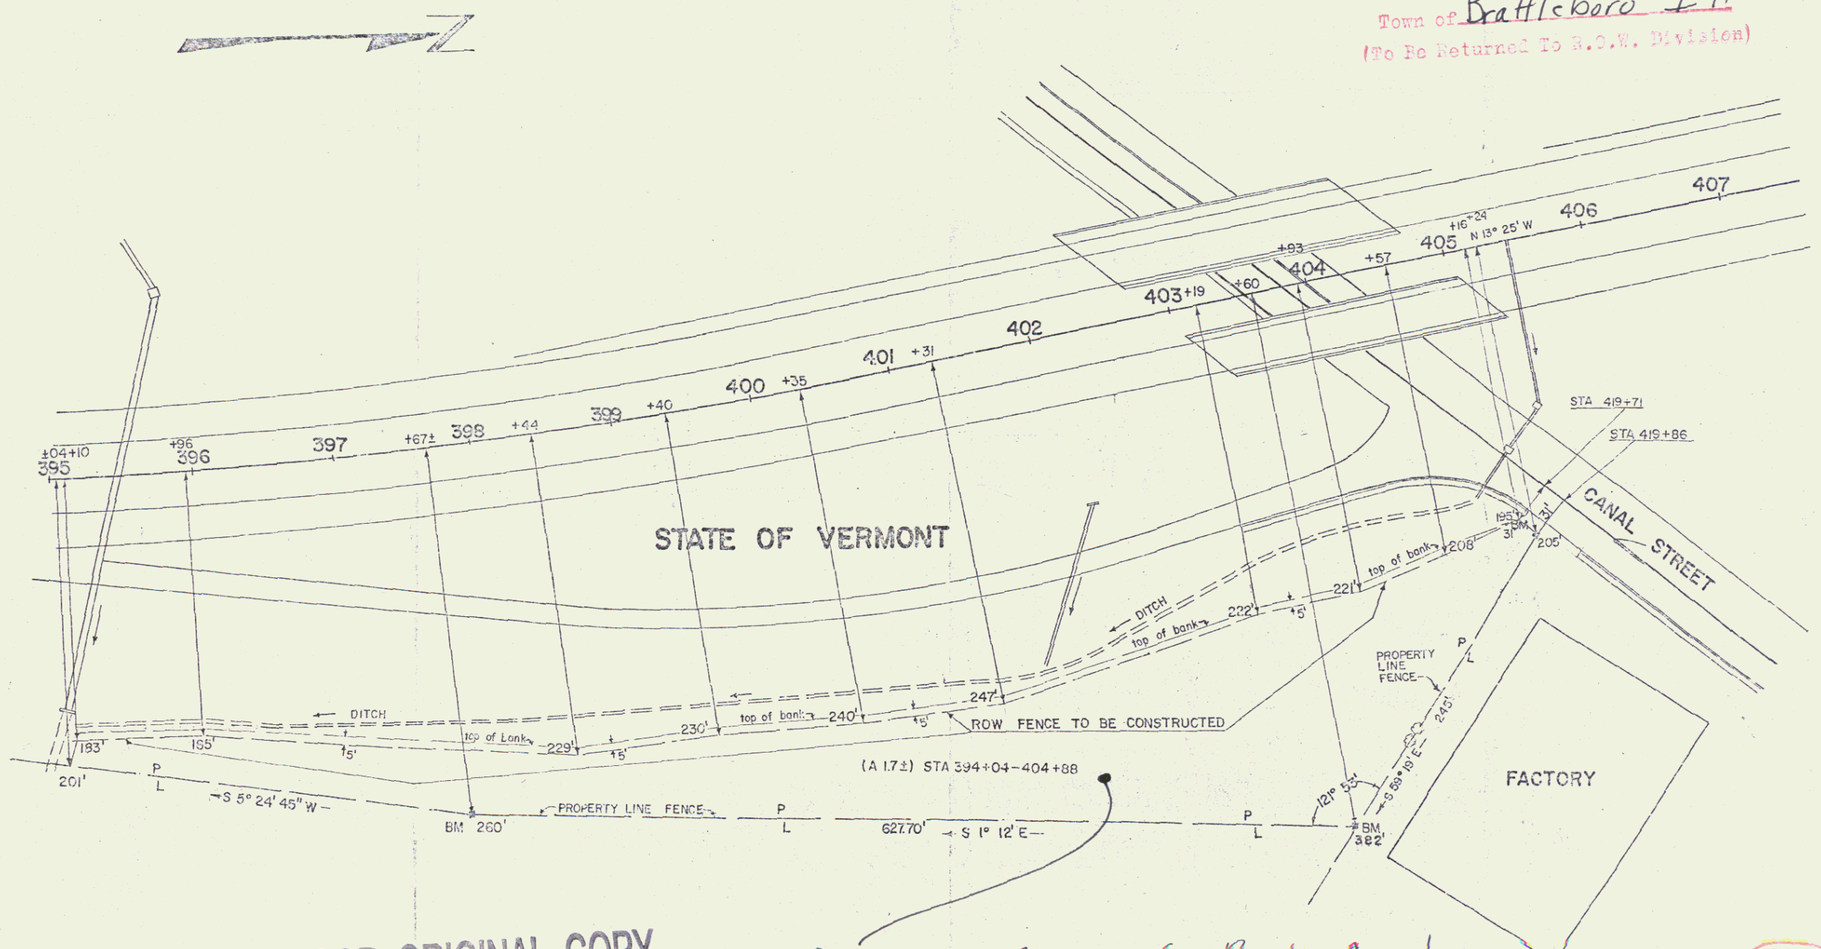

POOR ORIGINAL COPY

State of Vt to Marcraft Realty Corp. by
QCD. 4/15/60, BK103 Pg 482

30A

SCALE 1" = 50'

GUILFORD-VERNON-BRATTLEBORO
FI IN 91-1 (1)

68

JAN 3 1992

8